


LEGEND

- PAVED ROAD
- DIRT ROAD
- TRAIL
- FENCE
- PIPELINE
- POLE
- CONCRETE BUILDING
- TREES
- DRAINAGE
- MINE LEASE
- INDEX CONTOUR
- INTERMEDIATE CONTOUR
- DEPRESSION INDEX CONTOUR
- DEPRESSION INTERMEDIATE
- GRID TICK
- GRID NUMBER N 326,000
- SPOT ELEVATION 2995.2
- ANALYTICAL POINT
- SURVEYED CONTROLS
- CULVERT
- BUSINESS LEASE
- AS-BUILT FINAL SURFACE SPOT ELEVATION

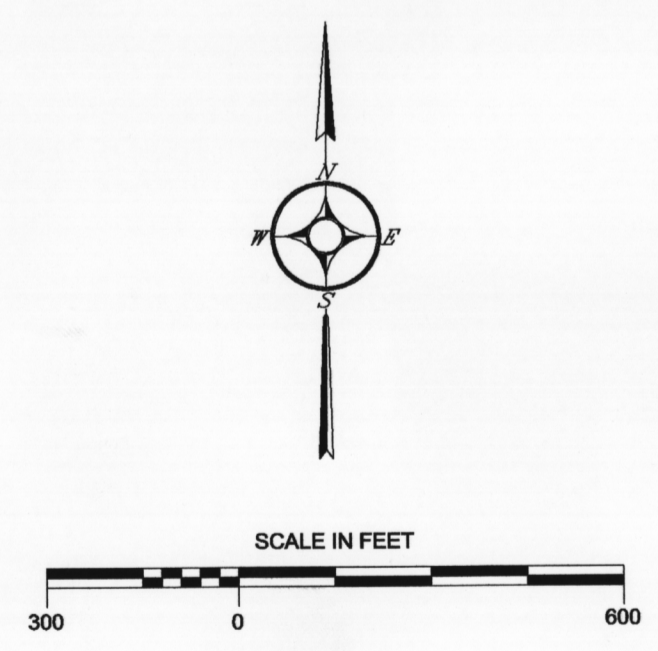

CONTOUR INTERVAL 2'
 DATE OF AERIAL PHOTOGRAPHY: 5-16-93
 AS-BUILT SURVEYED BY C.E. SPURLOCK & ASSOC., INC. 4-8-97
 MAP WAS RECREATED BY SHEPHERD MILLER, INC. (10-20-99)

REVISIONS		PROJECT AREA:		WESTERN NUCLEAR INC.
DATE	BY	SHERWOOD URANIUM MILLSITE		
10/20/99	TGB(SM)	STATE WASHINGTON COUNTY STEVENS		
		SECTION 2,3 & 34,35 TWP.27&28N RGE. 37E		
11/11/99	TGB(SM)	TITLE:		
		RANDOM SAMPLE POINTS STAKED IN TAILING & MARGIN AREA		
		Design By	Scale 1" = 300'	DWG. NO.
		Drawn By	Date 5/19/97	
		Checked By	Sheet 1 of 1	
ASCI FILE: ASBLT96.CSV (SPURLOCK FILE)				
PROJECT FILE: 03-317.CLIENT\SPURLOCK-99				
ACAD FILE: ASBUILT-SMI.DWG				

D-1

Date: 05/19/97
 Project: 03-317 CLIENT\SPURLOCK-99\ASBUILT-SMI.DWG
 Drawn: TGB
 Checked: TGB
 Date: 05/19/97