


- NOTES:
- FOR GENERAL NOTES SEE DRAWING M-0035A.
 - EXCEPT AS NOTED, ALL PIPING, VALVES, CONTROLS, ETC. ARE SUPPLIED, DESIGNED & INSTALLED BY THE CO. SYSTEM SUBCONTRACTOR.
 - THIS P & I IS NOT "D" LISTED "D" IDENTIFICATION IS FOR MAJOR AREAS ONLY AS SHOWN.
 - VALVES QIP64F-332A & B ARE CLASS 00B.
 - VALVES F332A AND F332B GAGGED OPEN BY EC-0026

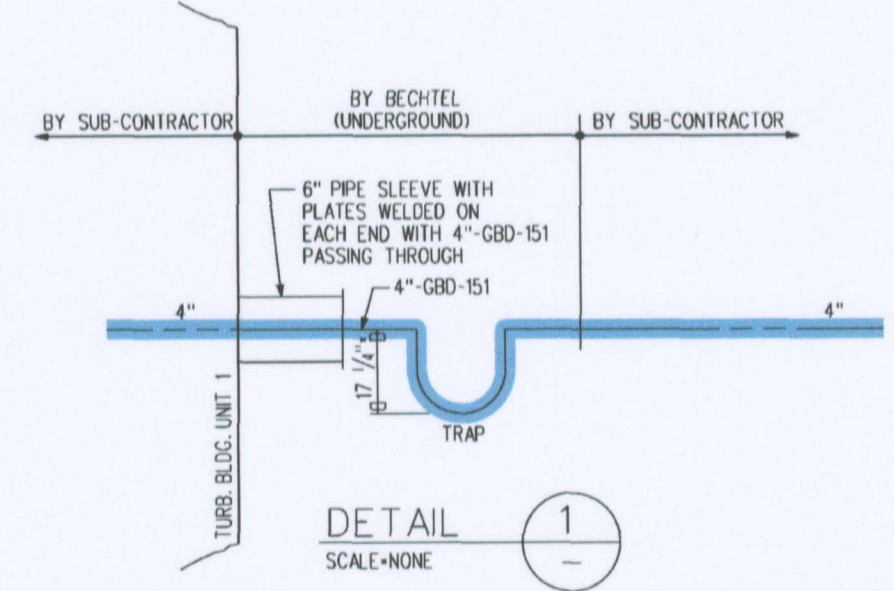

COMPONENTS SUBJECT TO AMR
 FIRE PROTECTION CO2 AND HALON SYSTEM AMM16

022	AS-BUILT PER EC 0026	WE	N/A	N/A	SIP	MM	11-18-08
021	AS-BUILT PER DRN 99-662	SIP	N/A	N/A	WE	MM	12-12-2005
020	AS-BUILT PER DRN 04-684	SIGN-OFF ON RECORD					

UPDATED FINAL SAFETY ANALYSIS REPORT
 FIGURE NUMBER - 9.5-005
 GRAND GULF NUCLEAR STATION
 UNIT 1
 NUCLEAR PLANT ENGINEERING
 P & I DIAGRAM
 FIRE PROTECTION SYSTEM
 UNIT 1

NO.	DATE	DESCRIPTION	BY	ENGR	CHK	APP
REVISIONS						
LRA-M-0035E						
CAD FILE: m0035e.DGN						
PLOT FILE: m0035e.DGN						

COMMON - UNIT 1 CONTROLLED
 MPL No. SP64 1015M
 SCALE: NONE
 DRAWING No. M-0035E
 REV. 022
 DF Nm0035e.dgn

013