
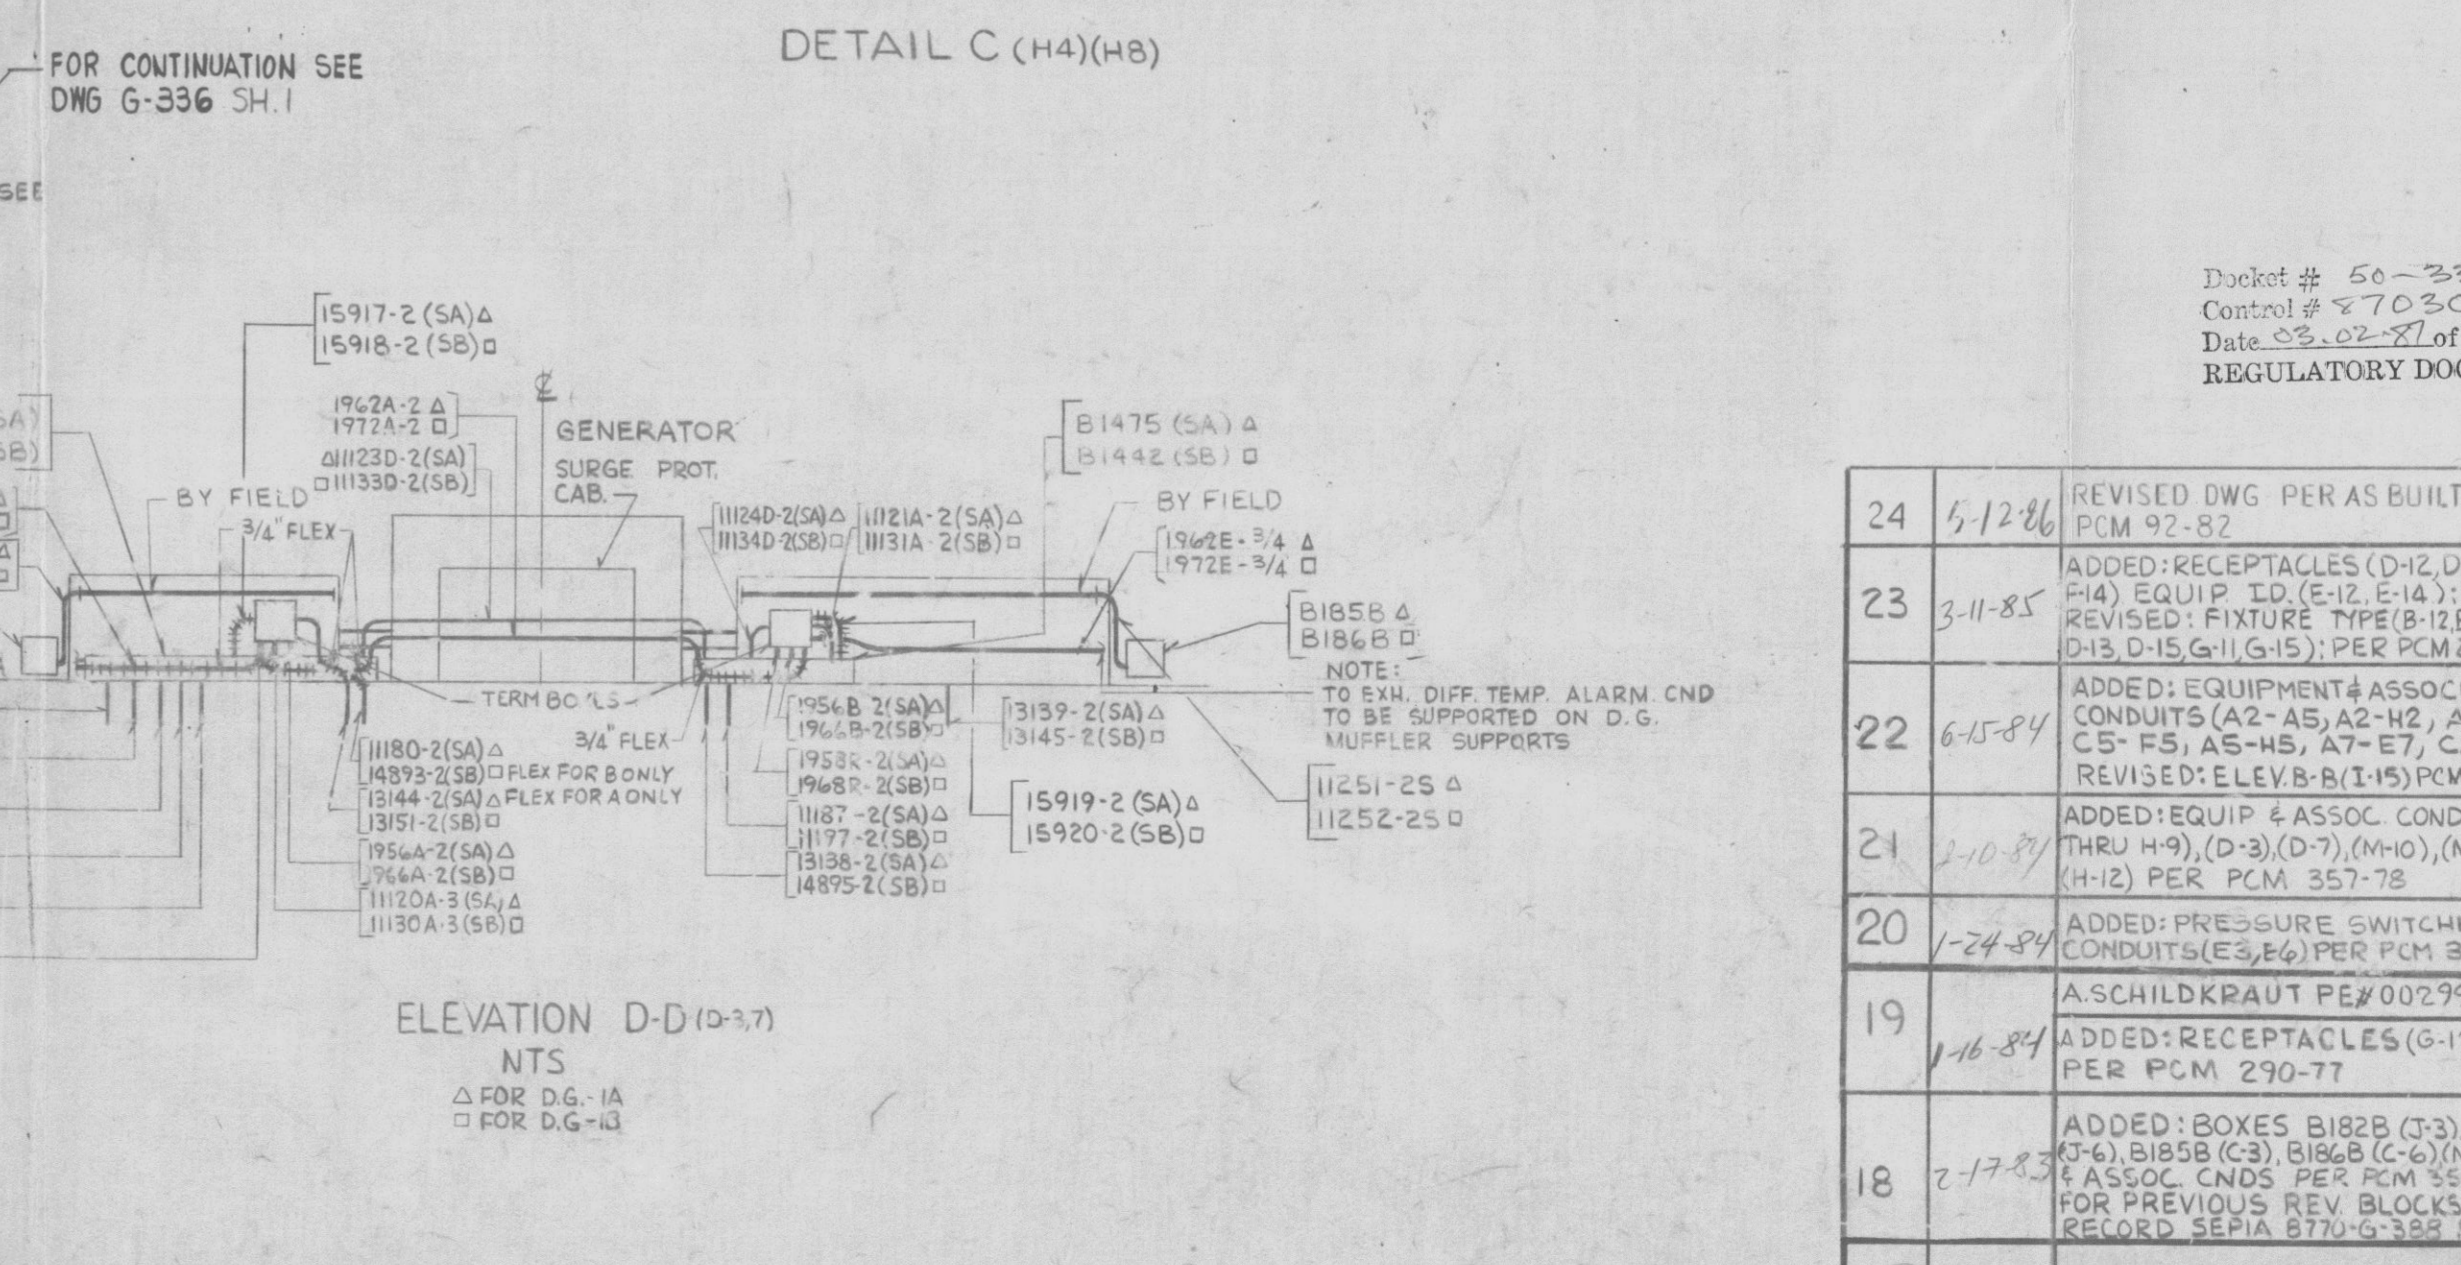
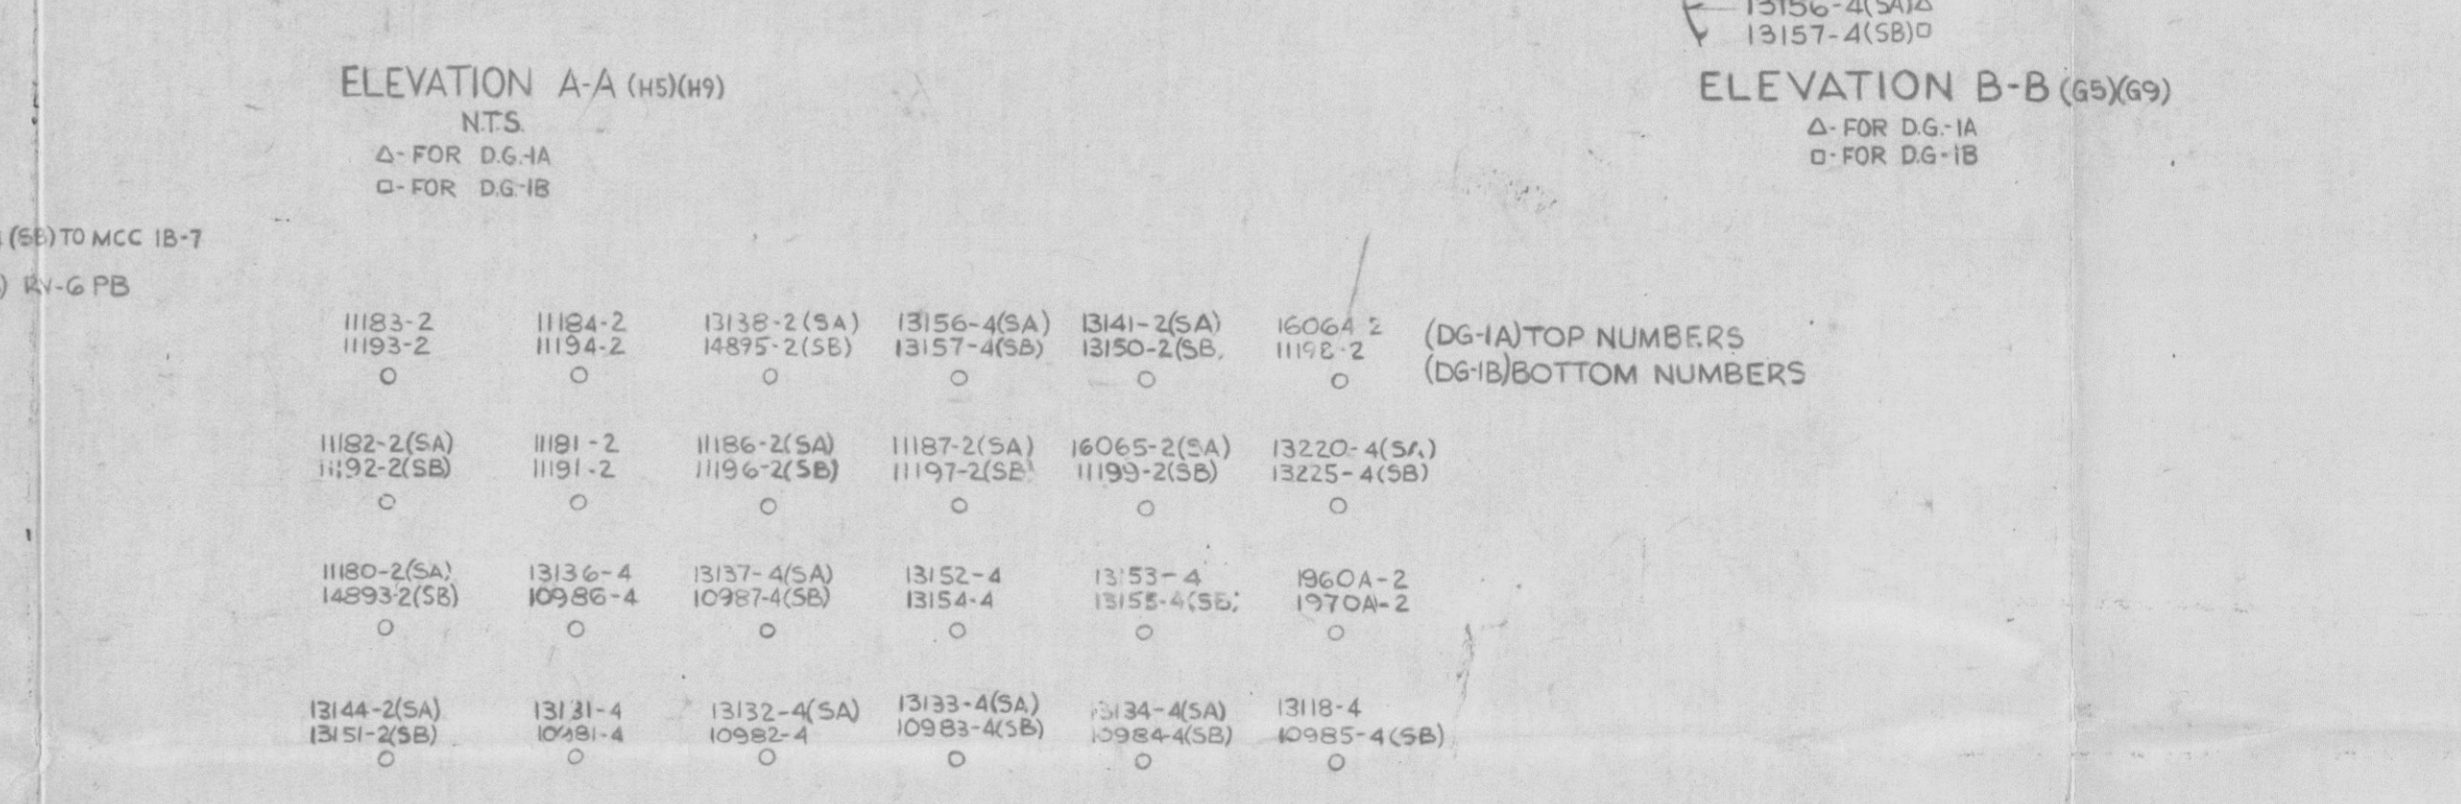
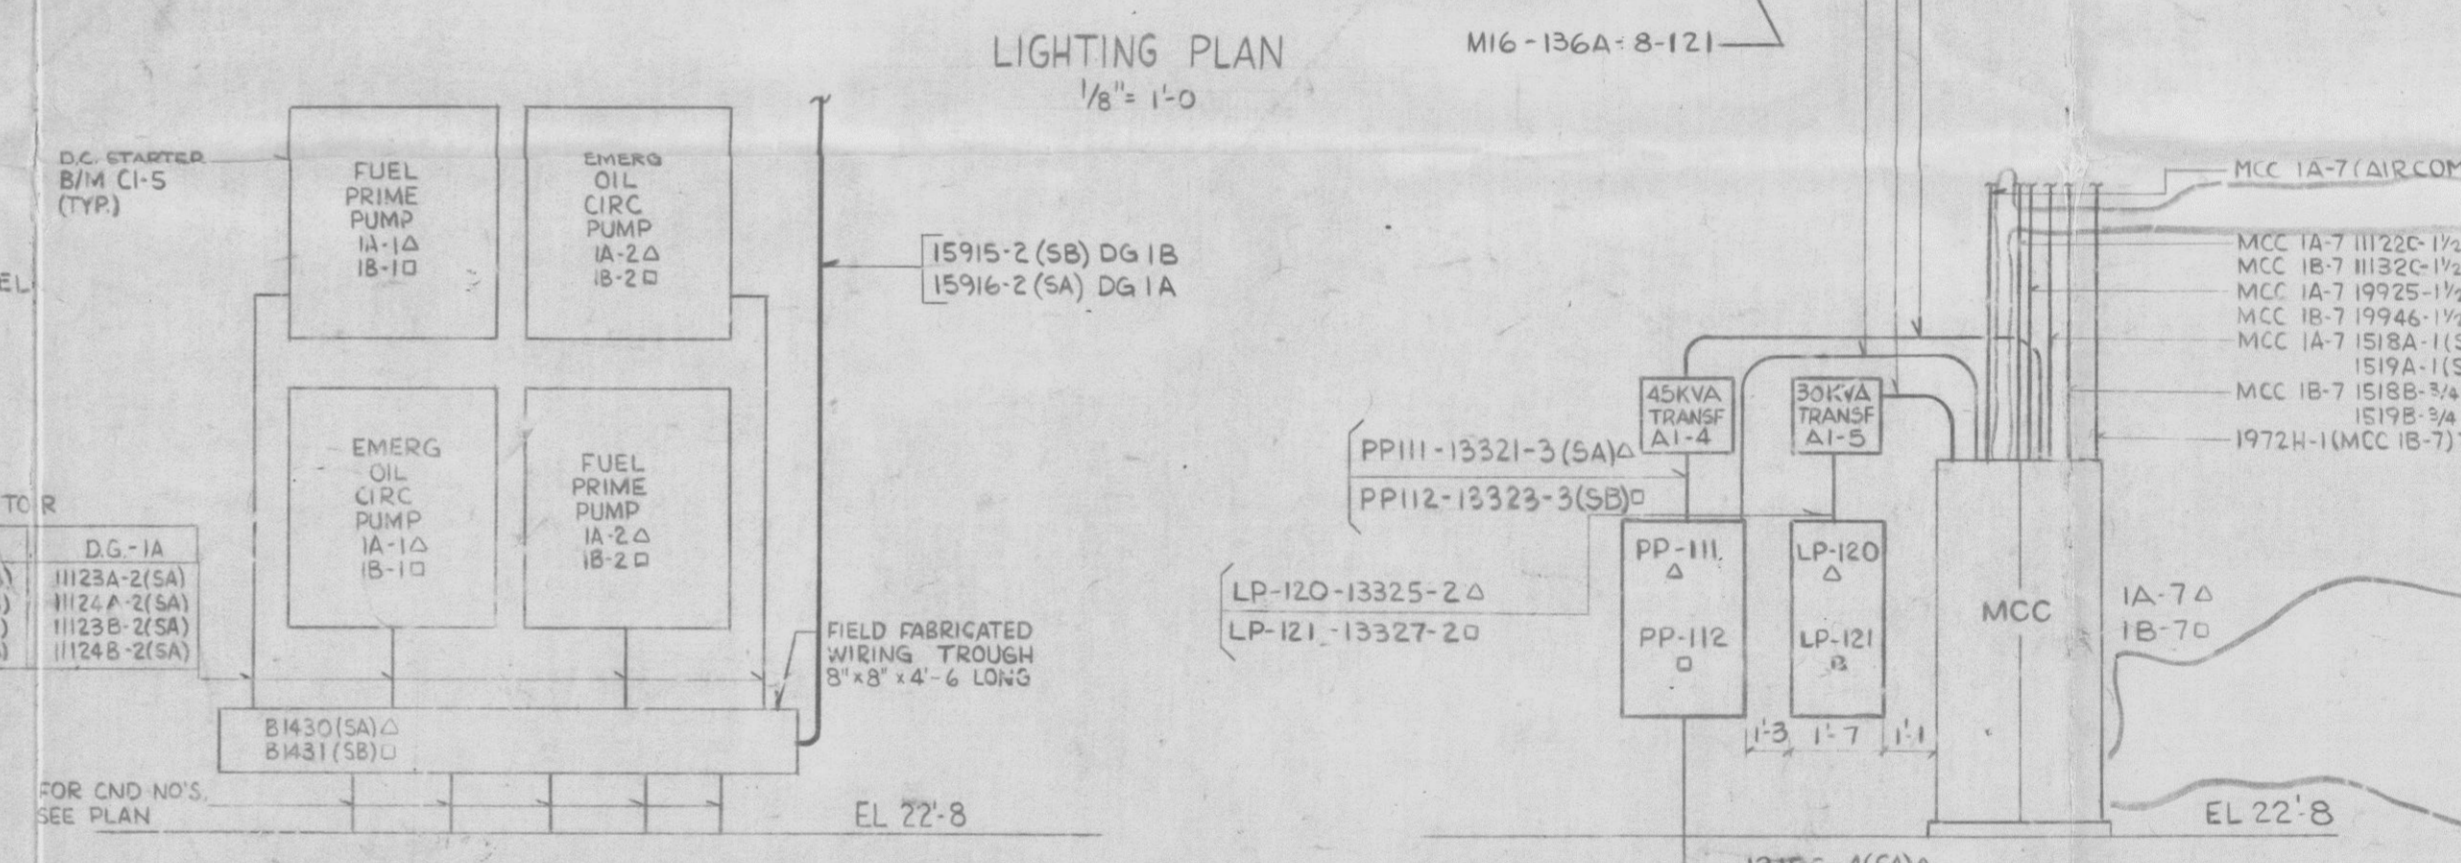


- SYMBOLS**
- GROUND CABLE
 - CONDUIT EMBEDDED
 - CONDUIT RUN EXPOSED
 - CONDUIT TURNING TOWARD OBSERVER
 - CONDUIT TURNING AWAY FROM OBSERVER

- NOTES**
1. FOR NOTES SEE DWG 8770-G-355
 2. CONDUITS TO BE EMBEDDED IN CEILING FROM LTG PNL TO NORMAL/EMERGENCY FIXTURES.
 3. FOR DETAILS OF B180A SEE 8770-B-404 SH.2D

- REFERENCE DWG'S**
- LIST OF DRAWINGS
 - BILL OF MATERIAL
 - CABLE & CONDUIT LIST
 - STATION GROUNDING
 - MANHOLE & HANDHOLE DETAILS
 - GROUNDING NOTES
 - YARD DUCT RUNS & LTG PLAN SECTIONS & DETAILS SH.1
 - LIGHTING NOTES
 - HVAC - DIESEL GEN BLDG
 - BOX DETAILS
 - POWER DISTRIBUTION & MOTOR DATA
 - YARD DUCT RUNS & LIGHTING

- 8770-A-146
- B-325
- B-328
- G-336/SH.1
- B-348
- B-412
- G-408/SH.1
- A-399
- G-874
- B-404
- B-335
- G-407
- SH.1

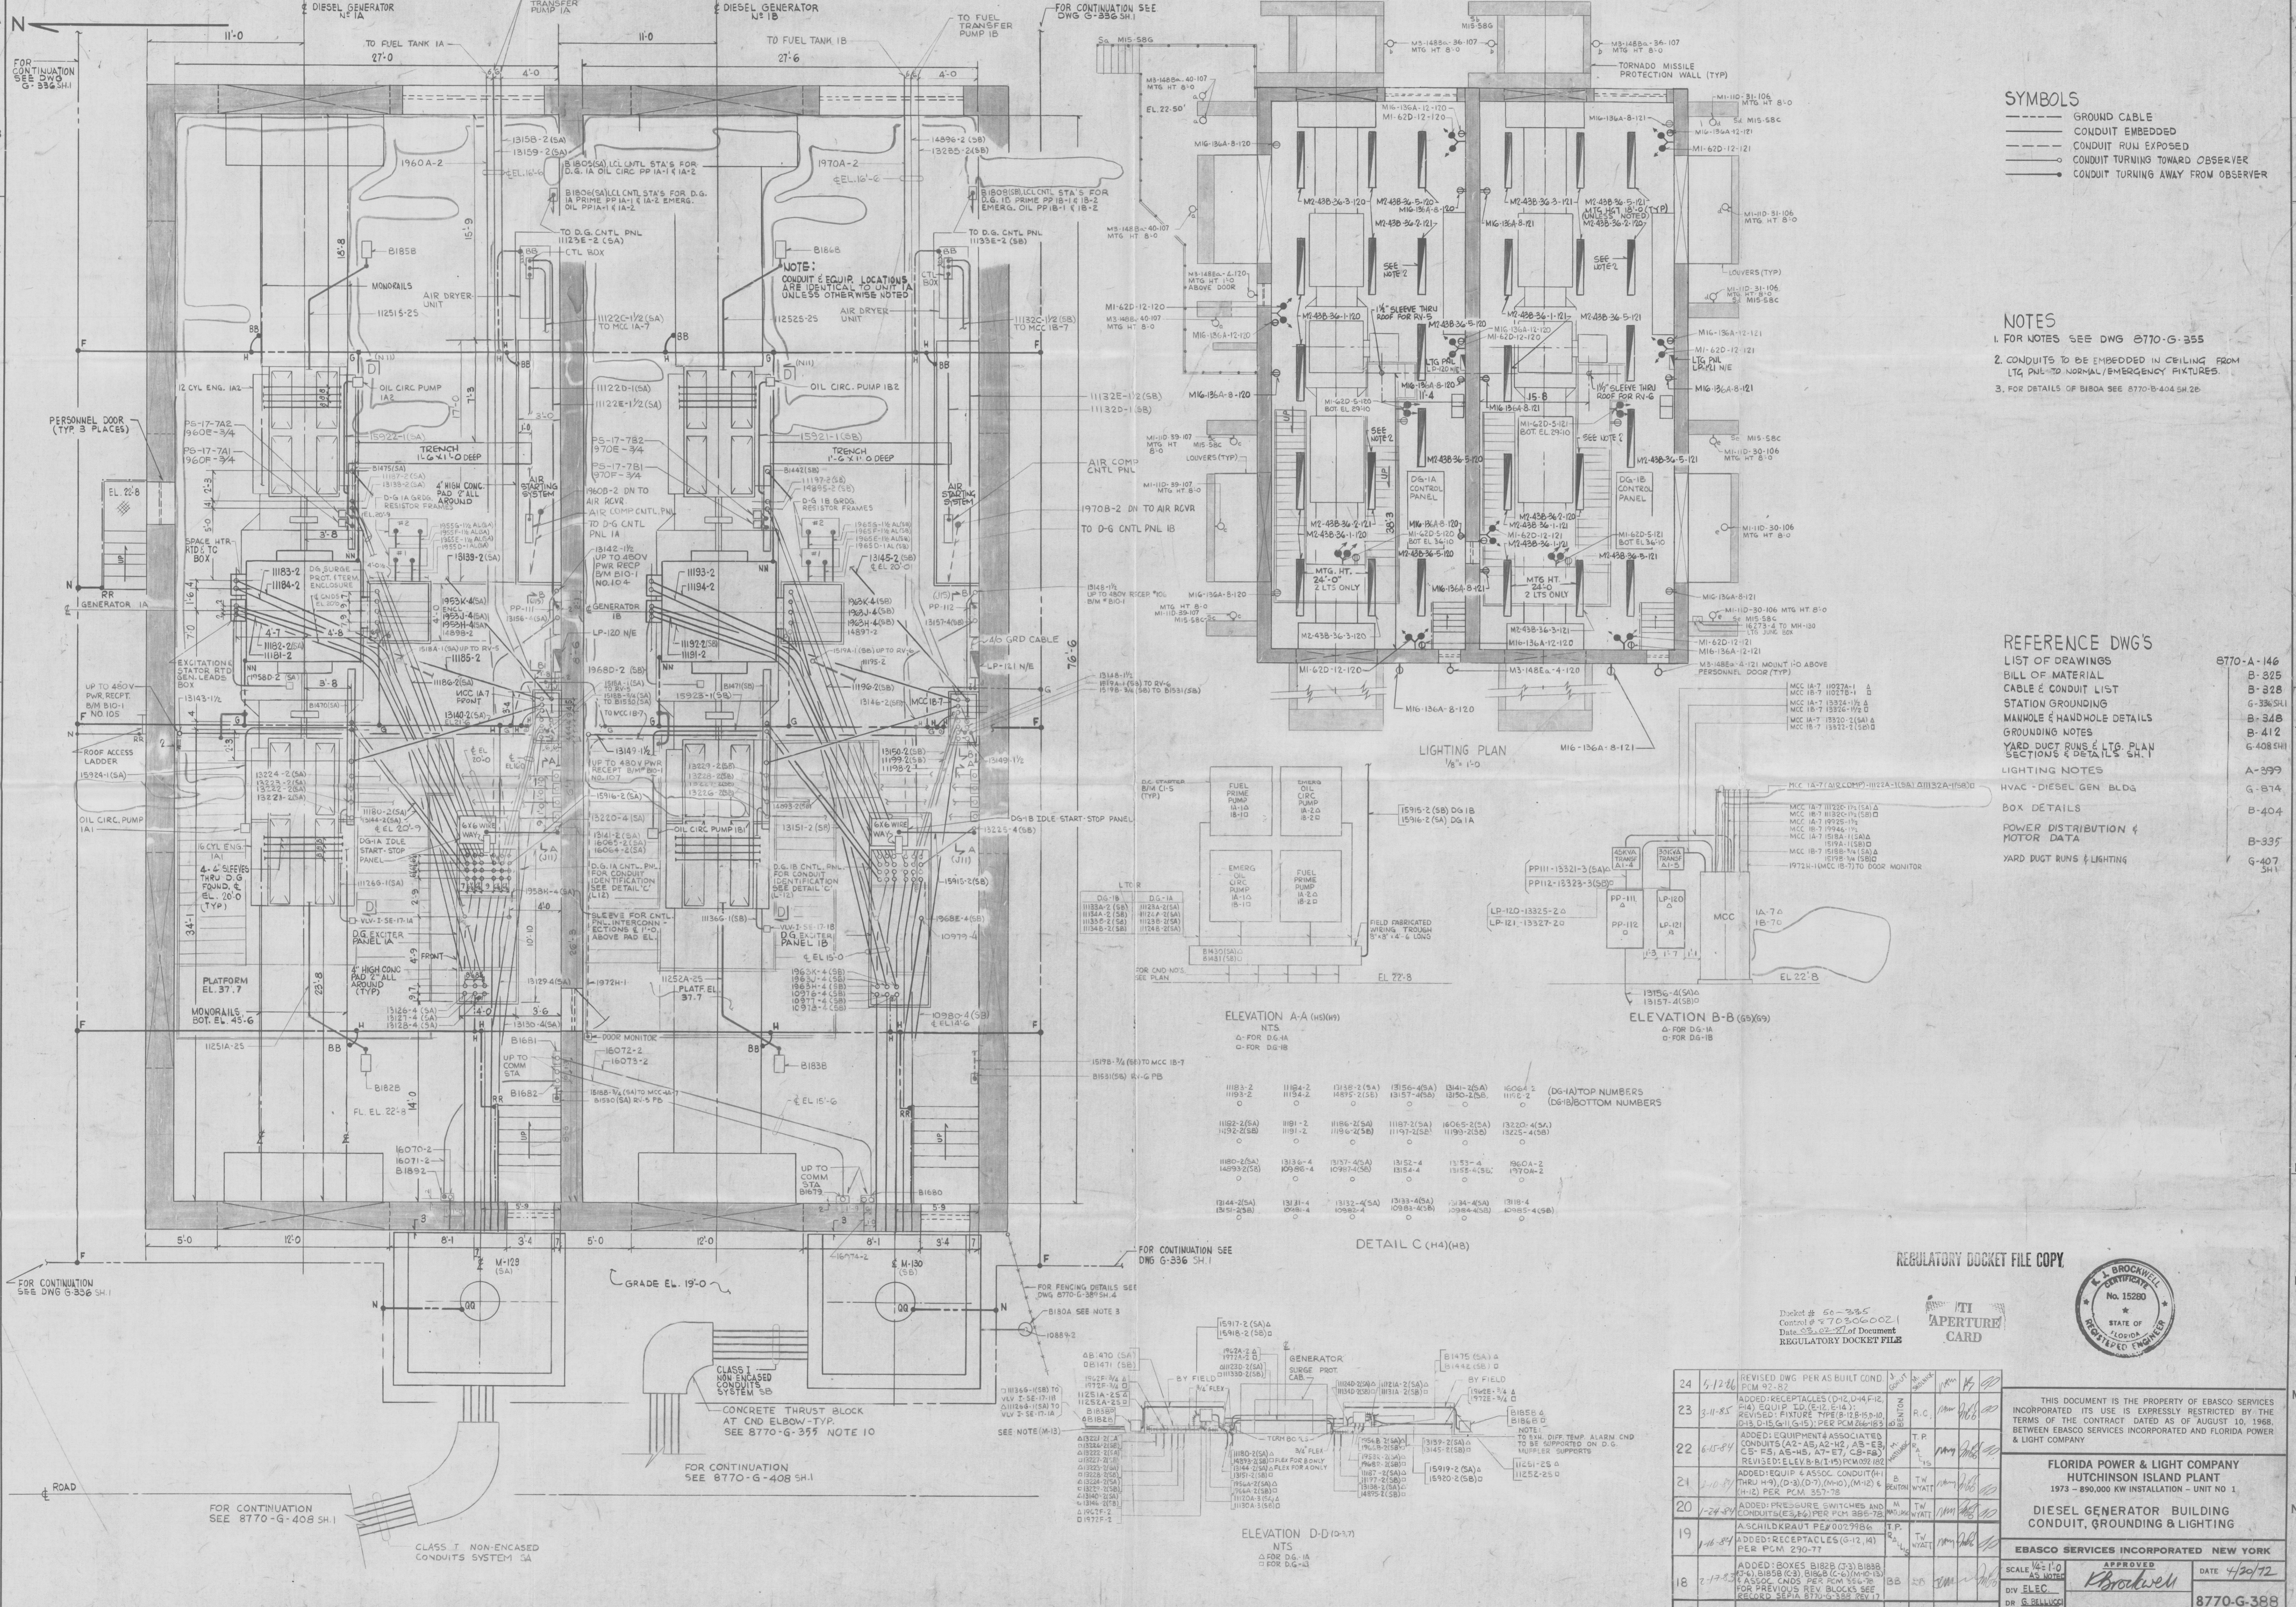

REGULATORY DOCKET FILE COPY.

APERTURE CARD

Docket # 50-335
Control # 70506002.1
Date: 03-22-77 Document
REGULATORY DOCKET FILE



NO	DATE	REVISION	BY	CH	APPROVED
24	5-12-86	REVISED DWG PER AS BUILT COND. PCM 92-82			
23	3-11-85	ADDED: RECEPTACLES (D-12, D-14, E-12, E-14) EQUIP. ID. (E-12, E-14); REVISED: FIXTURE TYPE (B-12, B-14, D-15, D-15 (G-15)); PER PCM 266163			
22	6-15-84	ADDED: EQUIPMENT & ASSOCIATED CONDUITS (A-7, A-5, A-2, A-3, A-5, A-5, C-5, F-5, A-5, A-7, E-7, C-5, F-5); REVISED: ELEV. B-B (1-15) PER PCM 266163			
21	2-10-84	ADDED: EQUIP. & ASSOC. CONDUITS (H-12) PER PCM 357-78			
20	1-24-84	ADDED: PRESSURE SWITCHES AND CONDUITS (E-2, E-4) PER PCM 356-78			
19	1-16-84	ADDED: RECEPTACLES (G-12, H-1) PER PCM 230-77			
18	1-7-84	ADDED: BOXES B182 (73) B188 (74) B189 (75) B190 (76) B191 (77) B192 (78) B193 (79) B194 (80) B195 (81) B196 (82) B197 (83) B198 (84) B199 (85) B200 (86) B201 (87) B202 (88) B203 (89) B204 (90) B205 (91) B206 (92) B207 (93) B208 (94) B209 (95) B210 (96) B211 (97) B212 (98) B213 (99) B214 (100) B215 (101) B216 (102) B217 (103) B218 (104) B219 (105) B220 (106) B221 (107) B222 (108) B223 (109) B224 (110) B225 (111) B226 (112) B227 (113) B228 (114) B229 (115) B230 (116) B231 (117) B232 (118) B233 (119) B234 (120) B235 (121) B236 (122) B237 (123) B238 (124) B239 (125) B240 (126) B241 (127) B242 (128) B243 (129) B244 (130) B245 (131) B246 (132) B247 (133) B248 (134) B249 (135) B250 (136) B251 (137) B252 (138) B253 (139) B254 (140) B255 (141) B256 (142) B257 (143) B258 (144) B259 (145) B260 (146) B261 (147) B262 (148) B263 (149) B264 (150) B265 (151) B266 (152) B267 (153) B268 (154) B269 (155) B270 (156) B271 (157) B272 (158) B273 (159) B274 (160) B275 (161) B276 (162) B277 (163) B278 (164) B279 (165) B280 (166) B281 (167) B282 (168) B283 (169) B284 (170) B285 (171) B286 (172) B287 (173) B288 (174) B289 (175) B290 (176) B291 (177) B292 (178) B293 (179) B294 (180) B295 (181) B296 (182) B297 (183) B298 (184) B299 (185) B300 (186) B301 (187) B302 (188) B303 (189) B304 (190) B305 (191) B306 (192) B307 (193) B308 (194) B309 (195) B310 (196) B311 (197) B312 (198) B313 (199) B314 (200) B315 (201) B316 (202) B317 (203) B318 (204) B319 (205) B320 (206) B321 (207) B322 (208) B323 (209) B324 (210) B325 (211) B326 (212) B327 (213) B328 (214) B329 (215) B330 (216) B331 (217) B332 (218) B333 (219) B334 (220) B335 (221) B336 (222) B337 (223) B338 (224) B339 (225) B340 (226) B341 (227) B342 (228) B343 (229) B344 (230) B345 (231) B346 (232) B347 (233) B348 (234) B349 (235) B350 (236) B351 (237) B352 (238) B353 (239) B354 (240) B355 (241) B356 (242) B357 (243) B358 (244) B359 (245) B360 (246) B361 (247) B362 (248) B363 (249) B364 (250) B365 (251) B366 (252) B367 (253) B368 (254) B369 (255) B370 (256) B371 (257) B372 (258) B373 (259) B374 (260) B375 (261) B376 (262) B377 (263) B378 (264) B379 (265) B380 (266) B381 (267) B382 (268) B383 (269) B384 (270) B385 (271) B386 (272) B387 (273) B388 (274) B389 (275) B390 (276) B391 (277) B392 (278) B393 (279) B394 (280) B395 (281) B396 (282) B397 (283) B398 (284) B399 (285) B400 (286) B401 (287) B402 (288) B403 (289) B404 (290) B405 (291) B406 (292) B407 (293) B408 (294) B409 (295) B410 (296) B411 (297) B412 (298) B413 (299) B414 (300) B415 (301) B416 (302) B417 (303) B418 (304) B419 (305) B420 (306) B421 (307) B422 (308) B423 (309) B424 (310) B425 (311) B426 (312) B427 (313) B428 (314) B429 (315) B430 (316) B431 (317) B432 (318) B433 (319) B434 (320) B435 (321) B436 (322) B437 (323) B438 (324) B439 (325) B440 (326) B441 (327) B442 (328) B443 (329) B444 (330) B445 (331) B446 (332) B447 (333) B448 (334) B449 (335) B450 (336) B451 (337) B452 (338) B453 (339) B454 (340) B455 (341) B456 (342) B457 (343) B458 (344) B459 (345) B460 (346) B461 (347) B462 (348) B463 (349) B464 (350) B465 (351) B466 (352) B467 (353) B468 (354) B469 (355) B470 (356) B471 (357) B472 (358) B473 (359) B474 (360) B475 (361) B476 (362) B477 (363) B478 (364) B479 (365) B480 (366) B481 (367) B482 (368) B483 (369) B484 (370) B485 (371) B486 (372) B487 (373) B488 (374) B489 (375) B490 (376) B491 (377) B492 (378) B493 (379) B494 (380) B495 (381) B496 (382) B497 (383) B498 (384) B499 (385) B500 (386) B501 (387) B502 (388) B503 (389) B504 (390) B505 (391) B506 (392) B507 (393) B508 (394) B509 (395) B510 (396) B511 (397) B512 (398) B513 (399) B514 (400) B515 (401) B516 (402) B517 (403) B518 (404) B519 (405) B520 (406) B521 (407) B522 (408) B523 (409) B524 (410) B525 (411) B526 (412) B527 (413) B528 (414) B529 (415) B530 (416) B531 (417) B532 (418) B533 (419) B534 (420) B535 (421) B536 (422) B537 (423) B538 (424) B539 (425) B540 (426) B541 (427) B542 (428) B543 (429) B544 (430) B545 (431) B546 (432) B547 (433) B548 (434) B549 (435) B550 (436) B551 (437) B552 (438) B553 (439) B554 (440) B555 (441) B556 (442) B557 (443) B558 (444) B559 (445) B560 (446) B561 (447) B562 (448) B563 (449) B564 (450) B565 (451) B566 (452) B567 (453) B568 (454) B569 (455) B570 (456) B571 (457) B572 (458) B573 (459) B574 (460) B575 (461) B576 (462) B577 (463) B578 (464) B579 (465) B580 (466) B581 (467) B582 (468) B583 (469) B584 (470) B585 (471) B586 (472) B587 (473) B588 (474) B589 (475) B590 (476) B591 (477) B592 (478) B593 (479) B594 (480) B595 (481) B596 (482) B597 (483) B598 (484) B599 (485) B600 (486) B601 (487) B602 (488) B603 (489) B604 (490) B605 (491) B606 (492) B607 (493) B608 (494) B609 (495) B610 (496) B611 (497) B612 (498) B613 (499) B614 (500) B615 (501) B616 (502) B617 (503) B618 (504) B619 (505) B620 (506) B621 (507) B622 (508) B623 (509) B624 (510) B625 (511) B626 (512) B627 (513) B628 (514) B629 (515) B630 (516) B631 (517) B632 (518) B633 (519) B634 (520) B635 (521) B636 (522) B637 (523) B638 (524) B639 (525) B640 (526) B641 (527) B642 (528) B643 (529) B644 (530) B645 (531) B646 (532) B647 (533) B648 (534) B649 (535) B650 (536) B651 (537) B652 (538) B653 (539) B654 (540) B655 (541) B656 (542) B657 (543) B658 (544) B659 (545) B660 (546) B661 (547) B662 (548) B663 (549) B664 (550) B665 (551) B666 (552) B667 (553) B668 (554) B669 (555) B670 (556) B671 (557) B672 (558) B673 (559) B674 (560) B675 (561) B676 (562) B677 (563) B678 (564) B679 (565) B680 (566) B681 (567) B682 (568) B683 (569) B684 (570) B685 (571) B686 (572) B687 (573) B688 (574) B689 (575) B690 (576) B691 (577) B692 (578) B693 (579) B694 (580) B695 (581) B696 (582) B697 (583) B698 (584) B699 (585) B700 (586) B701 (587) B702 (588) B703 (589) B704 (590) B705 (591) B706 (592) B707 (593) B708 (594) B709 (595) B710 (596) B711 (597) B712 (598) B713 (599) B714 (600) B715 (601) B716 (602) B717 (603) B718 (604) B719 (605) B720 (606) B721 (607) B722 (608) B723 (609) B724 (610) B725 (611) B726 (612) B727 (613) B728 (614) B729 (615) B730 (616) B731 (617) B732 (618) B733 (619) B734 (620) B735 (621) B736 (622) B737 (623) B738 (624) B739 (625) B740 (626) B741 (627) B742 (628) B743 (629) B744 (630) B745 (631) B746 (632) B747 (633) B748 (634) B749 (635) B750 (636) B751 (637) B752 (638) B753 (639) B754 (640) B755 (641) B756 (642) B757 (643) B758 (644) B759 (645) B760 (646) B761 (647) B762 (648) B763 (649) B764 (650) B765 (651) B766 (652) B767 (653) B768 (654) B769 (655) B770 (656) B771 (657) B772 (658) B773 (659) B774 (660) B775 (661) B776 (662) B777 (663) B778 (664) B779 (665) B780 (666) B781 (667) B782 (668) B783 (669) B784 (670) B785 (671) B786 (672) B787 (673) B788 (674) B789 (675) B790 (676) B791 (677) B792 (678) B793 (679) B794 (680) B795 (681) B796 (682) B797 (683) B798 (684) B799 (685) B800 (686) B801 (687) B802 (688) B803 (689) B804 (690) B805 (691) B806 (692) B807 (693) B808 (694) B809 (695) B810 (696) B811 (697) B812 (698) B813 (699) B814 (700) B815 (701) B816 (702) B817 (703) B818 (704) B819 (705) B820 (706) B821 (707) B822 (708) B823 (709) B824 (710) B825 (711) B826 (712) B827 (713) B828 (714) B829 (715) B830 (716) B831 (717) B832 (718) B833 (719) B834 (720) B835 (721) B836 (722) B837 (723) B838 (724) B839 (725) B840 (726) B841 (727) B842 (728) B843 (729) B844 (730) B845 (731) B846 (732) B847 (733) B848 (734) B849 (735) B850 (736) B851 (737) B852 (738) B853 (739) B854 (740) B855 (741) B856 (742) B857 (743) B858 (744) B859 (745) B860 (746) B861 (747) B862 (748) B863 (749) B864 (750) B865 (751) B866 (752) B867 (753) B868 (754) B869 (755) B870 (756) B871 (757) B872 (758) B873 (759) B874 (760) B875 (761) B876 (762) B877 (763) B878 (764) B879 (765) B880 (766) B881 (767) B882 (768) B883 (769) B884 (770) B885 (771) B886 (772) B887 (773) B888 (774) B889 (775) B890 (776) B891 (777) B892 (778) B893 (779) B894 (780) B895 (781) B896 (782) B897 (783) B898 (784) B899 (785) B900 (786) B901 (787) B902 (788) B903 (789) B904 (790) B905 (791) B906 (792) B907 (793) B908 (794) B909 (795) B910 (796) B911 (797) B912 (798) B913 (799) B914 (800) B915 (801) B916 (802) B917 (803) B918 (804) B919 (805) B920 (806) B921 (807) B922 (808) B923 (809) B924 (810) B925 (811) B926 (812) B927 (813) B928 (814) B929 (815) B930 (816) B931 (817) B932 (818) B933 (819) B934 (820) B935 (821) B936 (822) B937 (823) B938 (824) B939 (825) B940 (826) B941 (827) B942 (828) B943 (829) B944 (830) B945 (831) B946 (832) B947 (833) B948 (834) B949 (835) B950 (836) B951 (837) B952 (838) B953 (839) B954 (840) B955 (841) B956 (842) B957 (843) B958 (844) B959 (845) B960 (846) B961 (847) B962 (848) B963 (849) B964 (850) B965 (851) B966 (852) B967 (853) B968 (854) B969 (855) B970 (856) B971 (857) B972 (858) B973 (859) B974 (860) B975 (861) B976 (862) B977 (863) B978 (864) B979 (865) B980 (866) B981 (867) B982 (868) B983 (869) B984 (870) B985 (871) B986 (872) B987 (873) B988 (874) B989 (875) B990 (876) B991 (877) B992 (878) B993 (879) B994 (880) B995 (881) B996 (882) B997 (883) B998 (884) B999 (885) B1000 (886)			

THIS DOCUMENT IS THE PROPERTY OF EASCO SERVICES INCORPORATED. ITS USE IS EXPRESSLY RESTRICTED BY THE TERMS OF THE CONTRACT DATED AS OF AUGUST 10, 1968 BETWEEN EASCO SERVICES INCORPORATED AND FLORIDA POWER & LIGHT COMPANY.

FLORIDA POWER & LIGHT COMPANY
HUTCHINSON ISLAND PLANT
1973 - 890,000 KW INSTALLATION - UNIT NO. 1

DIESEL GENERATOR BUILDING CONDUIT, GROUNDING & LIGHTING

EASCO SERVICES INCORPORATED NEW YORK

SCALE 1/4" = 1'-0"
APPROVED: [Signature]
DATE: 4/20/72
BY: ELEC.
DR: G. BELLUCCI
CH: J. PAUTZ

8770-G-388