



M. CHRISTOPHER NOLAN
Vice President

**Nuclear Regulatory Affairs, Policy &
Emergency Preparedness**
526 South Church Street, EC-07C
Charlotte, NC 28202
980-382-7426
Chris.Nolan@duke-energy.com

April 30, 2019

Serial: RA-19-0206

10 CFR 50.55a(g)(5)(iii)

U.S. Nuclear Regulatory Commission
ATTN: Document Control Desk
Washington, DC 20555-0001

Subject: Shearon Harris Nuclear Power Plant, Unit 1
Renewed Facility Operating License No. NPF-63
Docket No. 50-400
Proposed Alternative for the Third 10-Year Inservice Inspection Program

Reference: Letter from D. H. Corlett (Progress Energy) to the the U.S. Nuclear Regulatory Commission, *Third Interval Inservice Inspection Program Submittal*, dated April 29, 2008, ADAMS Accession Number ML081330463.

Ladies and Gentlemen:

By letter dated April 29, 2008 (i.e., Reference), Duke Energy Progress, LLC (Duke Energy), submitted the Inservice Inspection Program Plan for the third 10-year inspection interval for the Shearon Harris Nuclear Power Plant, Unit 1 (HNP). During the third inspection interval, the 2001 Edition through 2003 Addenda of the American Society of Mechanical Engineers (ASME) Boiler and Pressure Vessel Code, Section XI, was used for Class 1, 2, and 3 components, unless otherwise permitted.

During the third 10-year interval, Duke Energy completed the required inservice examinations for HNP, in accordance with the plan, except that certain components could not fully meet the examination requirements specified in the 2001 ASME Code with 2003 Addenda, Section XI, including the clarifications provided in ASME Code Case N-460. Duke Energy has determined that conformance to the Code requirement of essentially 100 percent coverage of weld volume or area examined was impractical due to various constraints and limitations. Accordingly, in accordance with 10 CFR 50.55a(g)(5)(iii), Duke Energy requests NRC approval of the 10 CFR 50.55a relief requests for the locations identified in Table 1 of Enclosure 1, for HNP. Non-destruction examination (NDE) data and coverage plots for HNP are provided in Enclosure 2.

The third 10-year inservice inspection interval for HNP Unit 1 began on May 2, 2007, and ended on May 1, 2018. The third interval end date was extended 12 months in accordance with IWA-2430(d)(1) of the 2001 Edition with the 2003 Addenda. This submittal is being provided to the NRC within 12 months after the expiration of the 10-year inservice inspection interval.

DUAL ENERGY

No regulatory commitments are contained in this letter. Please refer any questions regarding this submittal to Mr. Art Zaremba, Director – Nuclear Fleet Licensing, at (980) 373-2062.

Sincerely,



M. Christopher Nolan
Vice President – Nuclear Regulatory Affairs,
Policy, & Emergency Preparedness

LJG/ljg

Enclosures:

1. Relief Request Number I3R-19, Relief Requested in Accordance with 10 CFR 50.55a(g)(5)(iii) for Volumetric Examination of Class 1 and 2 Components
2. Relief Request Number I3R-19, Third Inservice Inspection (ISI) Interval Limited Coverage Non-Destruction Examination (NDE) Data

cc (with Enclosures):

U.S. Nuclear Regulatory Commission, Region II
ATTN: Ms. Catherine Haney, Regional Administrator
245 Peachtree Center Ave, NE, Suite 1200
Atlanta, GA 30303-1257

U.S. Nuclear Regulatory Commission
ATTN: Ms. Martha Barillas **(Electronic Copy Only)**
11555 Rockville Pike
Rockville, MD 20852-2738
Martha.Barillas@nrc.gov

U.S. Nuclear Regulatory Commission
ATTN: Mr. John Zeiler, NRC Senior Resident Inspector
5421 Shearon Harris Rd.
New Hill, NC 27562

Chair - North Carolina Utilities Commission **(Electronic Copy Only)**
4325 Mail Service Center
Raleigh, NC 27699-4300
swatson@ncuc.net

Mr. Cliff Dautrich, Bureau Chief
North Carolina Department of Labor
Boiler Safety Bureau
1101 Mail Service Center
Raleigh, NC 27699-1101

Enclosure 1

Duke Energy Progress, LLC

Shearon Harris Nuclear Plant, Unit 1

Relief Request I3R-19

**Relief Requested in Accordance with 10 CFR 50.55a(g)(5)(iii) for Volumetric Examination
of Class 1 and 2 Components**

1.0 ASME CODE COMPONENTS AFFECTED:

Code Class: 1 & 2
References: IWB-2500, Table IWB-2500-1
IWC-2500, Table IWC-2500-1
ASME Code Case N-460
Examination Categories: B-A, B-B, B-D, C-A, C-B
Item Numbers: B1.30, B2.40, B3.110, C1.10, C2.21
Description: Limited Volumetric Examination Coverage
Component Number: See Tables 1 and 2 for a list of Component IDs

2.0 APPLICABLE CODE EDITION AND ADDENDA:

The Shearon Harris Nuclear Plant (HNP), Unit 1 third Inservice Inspection (ISI) Interval is based on the American Society of Mechanical Engineers (ASME) Boiler and Pressure Vessel (B&PV) Code, Section XI, 2001 Edition through the 2003 Addenda.

3.0 APPLICABLE CODE REQUIREMENTS:

3.1. Examination Category B-A

The extent of examination requirement for Examination Category B-A, Item Number B1.30, per Table IWB-2500-1, requires a volumetric examination of essentially 100% of the weld length for shell-to-flange welds as shown in Figure IWB-2500-4.

3.2 Examination Category B-B

The extent of examination requirement for Examination Category B-B, Item Number B2.40, per Table IWB-2500-1, requires a volumetric examination of essentially 100% of the weld length for tubesheet-to-head welds as shown in Figure IWB-2500-6.

3.3 Examination Category B-D

The extent of examination requirement for Examination Category B-D, Item Number B3.110, per Table IWB-2500-1, requires a volumetric examination of all pressurizer nozzle-to-vessel welds as shown in Figure IWB-2500-7(b).

3.4 Examination Category C-A

The extent of examination requirement for Examination Category C-A, Item Number C1.10, per Table IWC-2500-1 requires a volumetric examination of essentially 100% of the weld length of the shell circumferential welds as shown in Figure IWC-2500-1.

3.5 Examination Category C-B

The extent of examination requirement for Examination Category C-B, Item Number C2.21, per Table IWC-2500-1, requires a volumetric and surface examination of the nozzle-to-head welds as shown in Figure IWC-2500-4(a). Note 4 in Table IWC-2500-1 states, in the case of multiple vessels of similar design, size, and service (such as steam

generators, heat exchangers), the required examinations may be limited to one vessel or distributed among the vessels.

3.6 ASME Code Case N-460

HNP Unit 1 adopted ASME Code Case N-460, "Alternative Examination Coverage for Class 1 and Class 2 Welds, Section XI, Division 1", which defines "essentially 100%" as greater than 90% coverage of the examination volume or surface area, as applicable. The greater than 90% minimum coverage was applied to all surface and volumetric examination required by ASME Section XI.

4.0 **IMPRACTICALITY OF COMPLIANCE:**

Pursuant to 10 CFR 50.55a(g)(5)(iii), relief is requested on the basis that conformance with ASME Section XI Code requirements is impractical. Due to plant configuration or component geometry, greater than 90% coverage of the required volume and/or area could not be obtained for these welds. The components or plant would have to be redesigned and modified to obtain additional coverage, which is impractical.

Table 1 provides a summary of the examination limitations for each component for which relief is requested. The table also indicates the outage the component was examined, the coverage percentage obtained for each component, and other pertinent design information. This table is the cumulative list of the limited ASME Section XI examinations performed during the third ISI interval.

Enclosure 1 provides limitation calculations and/or coverage plots which were extracted from the non-destructive examination (NDE) summary sheets that detail the examination limitations.

Accordingly, pursuant to 10 CFR 50.55a(g)(5)(iii), Duke Energy has determined that conformance with the code requirement to examine essentially 100% of the weld volume or area is impractical due to various constraints and limitations described in Table 1 and Enclosure 1. Duke Energy requests NRC approval of the proposed alternative as stated below.

5.0 **BURDEN CAUSED BY COMPLIANCE:**

Compliance with the applicable ASME Section XI Code volumetric examination requirements can only be accomplished by redesigning and refabricating the subject and/or surrounding components. Based on this, the ASME Section XI Code requirements are deemed impractical in accordance with 10 CFR 50.55a(g)(5)(iii)

6.0 **PROPOSED ALTERNATIVE AND BASIS FOR USE:**

6.1. Examination Category B-A

HNP Unit 1 has performed the ASME Section XI Code required examinations to the extent practical, maximizing code required coverage. Examinations were conducted using personnel, equipment and procedures qualified in accordance with ASME Section XI,

2001 Edition through the 2003 Addenda. Table 1 details the limitations incurred. Due to the physical interferences causing these limitations, there are no alternative examination techniques currently available to increase coverage, and no alternative weld selection is available to gain additional coverage. Radiography (RT) is not a desired option because RT is limited in the ability to detect service induced flaws.

The system leakage test performed each refueling outage in accordance with Table IWB-2500-1, Examination Category B-P requires a VT-2 visual examination to detect evidence of leakage. This test provides additional assurance of pressure boundary integrity. In addition to the above code required examinations (volumetric and pressure test), reactor building normal sump monitoring and reactor building area radiation monitoring contribute to ensuring pressure boundary integrity by providing means to detect reactor coolant leakage and take prompt corrective actions.

Based on the acceptable results for the coverage completed by the volumetric examination, the pressure testing (VT-2) examinations required by Section XI, and the leakage monitoring, it is Duke's position that the combination of examinations provide a reasonable assurance of quality and safety.

6.2 Examination Category B-B

HNP Unit 1 has performed the ASME Section XI Code required examinations to the extent practical, maximizing code required coverage. Examinations were conducted using personnel, equipment and procedures qualified in accordance with ASME Section XI, 2001 Edition through the 2003 Addenda. Table 1 details the limitations incurred. Due to the physical interferences causing these limitations, there are no alternative examination techniques currently available to increase coverage, and no alternative weld selection is available to gain additional coverage. Radiography (RT) is not a desired option because RT is limited in the ability to detect service induced flaws.

The system leakage test performed each refueling outage in accordance with Table IWB-2500-1, Examination Category B-P requires a VT-2 visual examination to detect evidence of leakage. This test provides additional assurance of pressure boundary integrity. In addition to the above code required examinations (volumetric and pressure test), reactor building normal sump monitoring and reactor building area radiation monitoring contribute to ensuring pressure boundary integrity by providing means to detect reactor coolant leakage and take prompt corrective actions.

Based on the acceptable results for the coverage completed by the volumetric examination, the pressure testing (VT-2) examinations required by Section XI, and the leakage monitoring, it is Duke's position that the combination of examinations provide a reasonable assurance of quality and safety.

6.3 Examination Category B-D

HNP Unit 1 has performed the ASME Section XI Code required examinations to the extent practical, maximizing code required coverage. Examinations were conducted using personnel, equipment and procedures qualified in accordance with ASME Section XI, 2001 Edition through the 2003 Addenda. Table 1 details the limitations incurred. Due to the physical interferences causing these limitations, there are no alternative examination

techniques currently available to increase coverage, and no alternative weld selection is available to gain additional coverage. Radiography (RT) is not a desired option because RT is limited in the ability to detect service induced flaws.

The system leakage test performed each refueling outage in accordance with Table IWB-2500-1, Examination Category B-P requires a VT-2 visual examination to detect evidence of leakage. This test provides additional assurance of pressure boundary integrity. In addition to the above code required examinations (volumetric and pressure test), reactor building normal sump monitoring and reactor building area radiation monitoring contribute to ensuring pressure boundary integrity by providing means to detect reactor coolant leakage and take prompt corrective actions.

Based on the acceptable results for the coverage completed by the volumetric examination, the pressure testing (VT-2) examinations required by Section XI, and the leakage monitoring, it is Duke's position that the combination of examinations provide a reasonable assurance of quality and safety.

6.4 Examination Category C-A

HNP Unit 1 has performed the ASME Section XI Code required examination to the extent practical, maximizing code required coverage. Examinations were conducted using personnel, equipment and procedures qualified in accordance with ASME Section XI, 2001 Edition through the 2003 Addenda. Table 1 details the limitations incurred. Axial scans looking for circumferentially oriented flaws were limited to the shell side only. Circumferential scans looking for axially oriented flaws were complete. Due to the physical interferences causing the limitations, there are no alternative examination techniques currently available to increase coverage, and no alternative weld selection is available to gain additional coverage. Radiography (RT) is not a desired option because RT is limited in the ability to detect service induced flaws.

The volume of coverage obtained during the ultrasonic examination along with ongoing leakage tests once every ISI Period provide reasonable assurance that structural integrity is being maintained.

6.5 Examination Category C-B

HNP Unit 1 has performed the ASME Section XI Code required examinations to the extent practical, maximizing code required coverage. Examinations were conducted using personnel, equipment and procedures qualified in accordance with ASME Section XI, 2001 Edition through the 2003 Addenda. Table 1 details the limitations incurred. Due to the physical interferences causing these limitations, there are no alternative examination techniques currently available to increase the volumetric coverage, and no alternative weld selection is available to gain additional coverage. Radiography (RT) is not a desired option because RT is limited in the ability to detect service induced flaws. Liquid penetrant (PT) examinations were performed on these welds to satisfy the surface examination requirement resulting in 100% coverage obtained and no recordable indications. The PT data is also included in Enclosure 2 for reference.

The volume of coverage obtained during the ultrasonic examination along with ongoing leakage tests once every ISI Period provide reasonable assurance that structural integrity is being maintained.

7.0 DURATION OF PROPOSED ALTERNATIVE:

This request is proposed for the HNP Unit 1, Third Inservice Inspection Interval identified below:

HNP Unit 1, Third Inservice Inspection Interval:

Start Date: May 2, 2007 End Date: May 1, 2018¹

Note 1: The third interval end date was extended 12 months in accordance with IWA-2430(d)(1).

8.0 PRECEDENTS:

- 8.1. Shearon Harris, Unit 1 – Relief Request 2R1-019, 2R1-020, 2R1-021, 2R1-022, 2R2-009, 2R2-010 and 2R2-011 for the Second 10-Year Interval Inservice Inspection Program Plan (ADAMS Accession Number ML093561419).
- 8.2. Robinson, Unit 2 – Relief Request RR-20 for Limited Examinations Performed in the Fourth Ten-Year Inservice Inspection Program Plan (ADAMS Accession Number ML 13178A006).
- 8.3. Catawba Nuclear Station, Units 1 and 2 – Relief Request 17-CN-001 Regarding Category B-J Pressure Retaining Welds for the Third 10-Year Inservice Inspection Interval (ADAMS Accession Number ML18016A178).

9.0 REFERENCES:

- 9.1. 2001 Edition through 2003 Addenda, ASME Code, Section XI, “Rules for Inservice Inspection of Nuclear Power Plant Components”.
- 9.2. ASME Code Case N-460, Alternative Examination Coverage for Class 1 and Class 2 Welds, Section XI, Division 1.

Table 1
Shearon Harris Nuclear Plant, Unit 1
List of Components with Limited Examination Coverage

Exam Category / Item Number	Component ID (Summary #)	Exam Requirements Figure No. and (Method)	Component Description (System) ^[Note 1]	Outage Examined	Material	Nominal Pipe Size (Thickness)	Exam Angle / Frequency/ Mode of Propagation	Percent Coverage Obtained	Appendix VIII Qualified Exam	Remarks (NDE Coverage Plots and Calculations)
B-A B1.30	II-RV-001FTHW-RV-18FA,B,C (H-03772)	Volumetric IWB-2500-4 (UT)	RPV Shell-to-Flange Weld (RPV)	H1R15	Shell: SA-533 GR B CL 1, Flange: SA-508, CL 2	N/A (7.0")	45°/2.25 MHz/ Shear 60°/2.25 MHz/ Shear	71.7%	No	The impracticality was caused by the geometric configuration of the RPV flange transition to the head. Due to the configuration, obtaining the code required coverage is impractical. (Enclosure 2, Pages 1-9)
B-B B2.40	II-SG-001SGB-TSTHW-06-01 (H-03872)	Volumetric IWB-2500-6 (UT)	SG Tubesheet - To-Head Weld (RC)	H1R17	SA-508 Cl 3a	N/A (5.26")	45°/2.25 MHz/ Shear 60°/2.25 MHz/ Shear	Weld Material: 70.1% Base Metal: 75.2%	No	The impracticality was caused by the geometric configuration of the SG inlet nozzle and obstructions cause by the SG supports. Due to the configuration, obtaining the code required coverage is impractical. (Enclosure 2, Pages 10-15)

Table 1
Shearon Harris Nuclear Plant, Unit 1
List of Components with Limited Examination Coverage

Exam Category / Item Number	Component ID (Summary #)	Exam Requirements Figure No. and (Method)	Component Description (System) ^[Note 1]	Outage Examined	Material	Nominal Pipe Size (Thickness)	Exam Angle / Frequency/ Mode of Propagation	Percent Coverage Obtained	Appendix VIII Qualified Exam	Remarks (NDE Coverage Plots and Calculations)
B-D B3.110	II-PZR-01NTHW-10 (H-02997)	Volumetric IWB-2500-7(b) (UT)	Pressurizer Safety Nozzle to Upper Head Weld (RC)	H1R15	Nozzle: SA-508 CL 2 Shell: SA-533 Gr A CL 2	N/A (Minimum Thickness 2.09" including cladding)	0°/2.25 MHz/ Long 45°/2.25 MHz/ Shear 60°/2.25 MHz/ Shear	67.14%	No	The impracticality was caused by the geometric configuration of the PZR safety nozzle transition to the upper head. Due to the configuration, obtaining the code required coverage is impractical. (Enclosure 2, Pages 16-28)
B-D B3.110	II-PZR-01NTHW-11 (H-02998)	Volumetric IWB-2500-7(b) (UT)	Pressurizer Safety Nozzle to Upper Head Weld (RC)	H1R15	Nozzle: SA-508 CL 2 SA-533 Gr A CL 2	N/A (Minimum Thickness 2.09" including cladding)	0°/2.25 MHz/Long 45°/2.25 MHz/ Shear 60°/2.25MHz/ Shear	67.14%	No	The impracticality was caused by the geometric configuration of the PZR safety nozzle transition to the upper head. Due to the configuration, obtaining the code required coverage is impractical. (Enclosure 2, Pages 29-41)

Table 1
Shearon Harris Nuclear Plant, Unit 1
List of Components with Limited Examination Coverage

Exam Category / Item Number	Component ID (Summary #)	Exam Requirements Figure No. and (Method)	Component Description (System) ^[Note 1]	Outage Examined	Material	Nominal Pipe Size (Thickness)	Exam Angle / Frequency/ Mode of Propagation	Percent Coverage Obtained	Appendix VIII Qualified Exam	Remarks (NDE Coverage Plots and Calculations)
B-D B3.110	II-PZR-01NTHW-12 (H-02999)	Volumetric IWB-2500-7(b) (UT)	Pressurizer Safety Nozzle to Upper Head Weld (RC)	H1R15	Nozzle: SA-508 CL 2 SA-533 Gr A CL 2	N/A (Minimum Thickness 2.09" including cladding)	0°/2.25 MHz/Long 45°/2.25 MHz/ Shear 60°/2.25 MHz/ Shear	67.14%	No	The impracticality was caused by the geometric configuration of the PZR safety nozzle transition to the upper head. Due to the configuration, obtaining the code required coverage is impractical. (Enclosure 2, Pages 42-54)
B-D B3.110	II-PZR-01NTHW-09 (H-02996)	Volumetric IWB-2500-7(b) (UT)	Pressurizer Spray Nozzle to Upper Head Weld (RC)	H1R17	Nozzle: SA-508 CL 2 SA-533 Gr A CL 2	N/A (Minimum Thickness 2.69" including cladding)	0°/2.25 MHz/Long 45°/2.25 MHz/ Shear 60°/2.25 MHz/ Shear	67.14%	No	The impracticality was caused by the geometric configuration of the PZR spray nozzle transition to the upper head. Due to the configuration, obtaining the code required coverage is impractical. (Enclosure 2, Pages 55-74)

Table 1
Shearon Harris Nuclear Plant, Unit 1
List of Components with Limited Examination Coverage

Exam Category / Item Number	Component ID (Summary #)	Exam Requirements Figure No. and (Method)	Component Description (System) ^[Note 1]	Outage Examined	Material	Nominal Pipe Size (Thickness)	Exam Angle / Frequency/ Mode of Propagation	Percent Coverage Obtained	Appendix VIII Qualified Exam	Remarks (NDE Coverage Plots and Calculations)
B-D B3.110	II-PZR-01NTHW-13 (H-03000)	Volumetric IWB-2500-7(b) (UT)	Pressurizer Relief Nozzle to Upper Head Weld (RC)	H1R17	Nozzle: SA-508 CL 2 SA-533 Gr A CL 2	N/A (Minimum Thickness 2.09" including cladding)	0°/2.25 MHz/Long 45°/2.25 MHz/ Shear 60°/2.25MHz/ Shear	69.26%	No	The impracticality was caused by the geometric configuration of the PZR relief nozzle transition to the upper head. Due to the configuration, obtaining the code required coverage is impractical. (Enclosure 2, Pages 75-79)
B-D B3.110	II-PZR-01NTHW-08 (H-02995)	Volumetric IWB-2500-7(b) (UT)	Pressurizer Surge Nozzle to Lower Head Weld (RC)	H1R17	Nozzle: SA-508 CL 2 SA-533 Gr A CL 2	N/A (Minimum Thickness 2.74" including cladding)	0°/2.25 MHz/Long 45°/2.25MHz/ Shear 60°/2.25MHz/ Shear	59.1%	No	The impracticality was caused by the geometric configuration of the PZR surge nozzle transition to the lower head. Due to the configuration, obtaining the code required coverage is impractical. (Enclosure 2, Pages 80-84)

Table 1
Shearon Harris Nuclear Plant, Unit 1
List of Components with Limited Examination Coverage

Exam Category / Item Number	Component ID (Summary #)	Exam Requirements Figure No. and (Method)	Component Description (System) ^[Note 1]	Outage Examined	Material	Nominal Pipe Size (Thickness)	Exam Angle / Frequency/ Mode of Propagation	Percent Coverage Obtained	Appendix VIII Qualified Exam	Remarks (NDE Coverage Plots and Calculations)
C-A C1.10	II-RHR-01RHRA-CSW-02A,B,C (H-03713)	Volumetric IWC-2500-1 (UT)	"A" RHR Heat Exchanger Shell Circumferential Weld (RH)	H1R15	SA-240-TP 304	N/A (Minimum Thickness 0.696")	45°/2.25MHz/ Shear 60°/2.25MHz/ Shear	75%	No	The impracticality was caused by the geometric configuration of the flange. Axial scans looking for circumferential flaws were limited to the shell side only due to the adjacent flange on the other side of the weld. Obtaining the code required volume is impractical due to configuration. (Enclosure 2, Pages 85-88)
C-B C2.21	II-BIT-01NTHW-04 (H-01354)	Surface and Volumetric IWC-2500-4(a) (PT and UT)	Boron Injection Tank Inlet Nozzle to Head Weld (SI)	H1R19 (PT) H1R20 (UT)	Nozzle: SA-182 F304 Shell: SA-240 TP304	N/A (2.0")	45°/1.5MHz/ Shear 60°/2.25MHz/ Shear 45°/2.0MHz/ RL 60°/2.0MHz/RL	78.6%	No	The impracticality was caused by the geometric configuration of the BIT inlet nozzle transition to the head. Due to the configuration, obtaining the code required coverage is impractical. (Enclosure 2, Pages 89-98)

Table 1
Shearon Harris Nuclear Plant, Unit 1
List of Components with Limited Examination Coverage

Exam Category / Item Number	Component ID (Summary #)	Exam Requirements Figure No. and (Method)	Component Description (System) ^[Note 1]	Outage Examined	Material	Nominal Pipe Size (Thickness)	Exam Angle / Frequency/ Mode of Propagation	Percent Coverage Obtained	Appendix VIII Qualified Exam	Remarks (NDE Coverage Plots and Calculations)
C-B C2.21	II-BIT-01NTHW-03 (H-01353)	Surface and Volumetric IWC-2500-4(a) (PT and UT)	Boron Injection Tank Outlet Nozzle to Head Weld (SI)	H1R19 (PT) H1R20 (UT)	Nozzle: SA-182 F304 Shell: SA-240 TP304	N/A (2.0")	45°/1.5MHz/ Shear 60°/2.25MHz/ Shear 45°/2.0MHz/ RL 60°/2.0MHz/RL	76.5%	No	The impracticality was caused by the geometric configuration of the BIT head transition to the outlet nozzle. Due to the configuration, obtaining the code required coverage is impractical. (Enclosure 2, Pages 99-108)

Note 1: The following systems and their abbreviations are listed here:

- Reactor Pressure Vessel (RPV)
- Reactor Coolant System (RC)
- Residual Heat Removal (RH)
- Safety Injection (SI)

Enclosure 2

Relief Request I3R-19

Shearon Harris Nuclear Plant, Unit 1

**Third Inservice Inspection (ISI) Interval Limited Coverage Non-Destruction Examination
(NDE) Examination Data**



UT Calibration Examination

Site/Unit: HNP / 1
 Summary No.: H-03772
 Workscope: ISI

Procedure: NDEP-0450
 Procedure Rev.: 3 TR-A
 Work Order No.: 1313525

Outage No.: RFO-15
 Report No.: UT-09-034
 Page: 1 of 9

Code: 2001 Ed 2003 Add Cat./Item: B-A/B1.30 Location: Containment 263'
 Drawing No.: 1-ISI-RV-1 Description: Reactor Vessel Head to Flange Weld
 System ID: RC-1005
 Component ID: II-RV-001FTHW-RV-18FA,B,C Size/Length: 493" Thickness/Diameter: 7"/157" ID
 Limitations: VESSEL HEAD CONFIGURATION Start Time: 1020 Finish Time: 1140

Instrument Settings
 Serial No.: 0134D2
 Manufacturer: Krautkramer Branson
 Model: USN-58L
 Delay: 1.2272 Range: 10"
 M'tl Cal/Vel: 0.2342 Pulsar: SINGLE
 Damping: 1KΩ Reject: 0%
 Rep. Rate: HIGH Freq.: 2.25 MHZ
 Filter: N/A Mode: LONGITUDAL
 Voltage: N/A Other: FULLWAVE
 Ax. Gain (dB): 26.5 Circ. Gain (dB): 26.5
10 Screen Div. = 10 in. of Sound Path
 Linearity Report No.: L-09-001

Search Unit
 Serial No.: C29344
 Manufacturer: KB AeroTech
 Size: 0.75" Shape: Round
 Freq.: 2.25 MHZ Style: Gamma
 Exam Angle: 0° # of Elements: 1
 Mode: Longitudinal
 Measured Angle: N/A
 Wedge Style: N/A
Search Unit Cable
 Type: RG-58
 Length: 6' No. Conn.: 0

Cal. Checks	Time	Date
Initial Cal.	0830	4/24/2009
Inter. Cal.	1020	4/24/2009
Inter. Cal.	1240	4/24/2009
Inter. Cal.	N/A	
Final Cal.	1530	4/24/2009

Couplant
 Cal. Batch: 05225
 Type: Ultragel II
 Mfg.: Sonotech, Inc.
 Exam Batch: 05225
 Type: Ultragel II
 Mfg.: Sonotech, Inc.

Reference Block
 Serial No.: 792221
 Type: CS Rompas

Axial Orientated Search Unit			
Calibration Reflector	Signal Amplitude %	Sweep Division	Sound Path
1/4T SDH	83	1.6	1.641
1/2T SDH	45	3.4	3.376
3/4T SDH	22	5.2	5.163
ID	60	7.1	7.132

Circumferential Orientated Search Unit			
Calibration Reflector	Signal Amplitude %	Sweep Division	Sound Path
N/A	N/A	N/A	N/A

Reference/Simulator Block				
Gain dB	Reflector	Signal Amplitude %	Sweep Division	Sound Path
32.5	SDH	66	0.7	0.736

Calibration Block
 Cal. Block No.: UT-005-1
 Thickness: 7.0 Dia.: 157"
 Cal. Blk. Temp. 66° Temp. Tool: 68951
 Comp. Temp.: 86° Temp. Tool: 68951

Scan Coverage
 Upstream Downstream Scan dB: 50.5
 CW CCW Scan dB: 50.5
 Exam Surface: OD
 Surface Condition: GROUND SMOOTH

Recordable Indication(s): Yes No (If Yes, Ref. Attached Ultrasonic Indication Report.)
 Results: Sat Unsat Eval
 Percent Of Coverage Obtained > 90%: *71.7% Reviewed Previous Data: Yes

Comments: *Verified previously recorded limitations and coverage calculations from report ISI-210T-00-002 (See Extracted Pages Attached). Examination was in a Radiation area.

Examiner	Level	Signature	Date	Reviewer	Signature	Date
Malia, Mark E.	II-PDI	<i>Mark E Malia</i>	4/24/2009	Damon Priestley PGN Lv III	<i>[Signature]</i>	4/29/2009
N/A	N/A			Site Review Scott Larson Level III	<i>[Signature]</i>	4/29/2009
Dugan, Michael P	III-PDI	<i>[Signature]</i>	4/28/2009	ANII Review Nancy Ritchie-Slaughter	<i>Nancy Ritchie-Slaughter</i>	5/5/09



UT Calibration Examination

Site/Unit: HNP / 1
 Summary No.: H-03772
 Workscope: ISI

Procedure: NDEP-0450
 Procedure Rev.: 3 TR-A
 Work Order No.: 1313525

Outage No.: RFO-15
 Report No.: UT-09-034
 Page: 2 of 9

Code: 2001 Ed 2003 Add Cat./Item: B-A/B1.30 Location: Containment 263'
 Drawing No.: 1-ISI-RV-1 Description: Reactor Vessel Head to Flange Weld
 System ID: RC-1005
 Component ID: II-RV-001FTHW-RV-18FA,B,C Size/Length: 493" Thickness/Diameter: 7"/157" ID
 Limitations: VESSEL HEAD CONFIGURATION Start Time: 1140 Finish Time: 1220

Instrument Settings
 Serial No.: 0134D2
 Manufacturer: Krautkramer Branson
 Model: USN-58L
 Delay: 12.1922 Range: 15"
 M'tl Cal/Vel: 0.1270 Pulsar: SINGLE
 Damping: 1KΩ Reject: 0%
 Rep. Rate: HIGH Freq.: 2.25 MHz
 Filter: N/A Mode: SHEARWAVE
 Voltage: N/A Other: FULLWAVE
 Ax. Gain (dB): 44* Circ. Gain (dB): 44*
10 Screen Div. = 15 in. of Sound Path
 Linearity Report No.: L-09-001

Search Unit
 Serial No.: C18133
 Manufacturer: KB AeroTech
 Size: .5" x 1" Shape: Rect.
 Freq.: 2.25 MHz Style: Gamma
 Exam Angle: 45° # of Elements: 1
 Mode: Shearwave
 Measured Angle: 45°
 Wedge Style: LUCITE

Search Unit Cable
 Type: RG-58
 Length: 6' No. Conn.: 0

Cal. Checks	Time	Date
Initial Cal.	0830	4/24/2009
Inter. Cal.	1020	4/24/2009
Inter. Cal.	1240	4/24/2009
Inter. Cal.		
Final Cal.	1530	4/24/2009

Couplant
 Cal. Batch: 05225
 Type: Ultragel II
 Mfg.: Sonotech, Inc.
 Exam Batch: 05225
 Type: Ultragel II
 Mfg.: Sonotech, Inc.

Reference Block
 Serial No.: 792221
 Type: CS Rompas

Axial Orientated Search Unit			
Calibration Reflector	Signal Amplitude %	Sweep Division	Sound Path
1/4T SDH	84	1.6	2.398
1/2T SDH	42	3.3	4.946
3/4T SDH	26	5.2	7.768
5/4T SDH	9	8.6	12.86
ID NOTCH	24	7	10.51

Circumferential Orientated Search Unit			
Calibration Reflector	Signal Amplitude %	Sweep Division	Sound Path

Reference/Simulator Block				
Gain dB	Reflector	Signal Amplitude %	Sweep Division	Sound Path
44	SDH	50	0.7	1.057

Calibration Block
 Cal. Block No.: UT-005-1
 Thickness: 7.0 Dia.: 157"
 Cal. Blk. Temp. 66° Temp. Tool: 68951
 Comp. Temp.: 86° Temp. Tool: 68951
 Upstream Downstream Scan dB: 62
 CW CCW Scan dB: 62
 Exam Surface: OD
 Surface Condition: GROUND SMOOTH

Recordable Indication(s): Yes No (If Yes, Ref. Attached Ultrasonic Indication Report.)

Results: Sat Unsat Eval
 Percent Of Coverage Obtained > 90%: 71.7% Reviewed Previous Data: Yes

Comments: * DB CHANGE FOR 3/4T AND 5/4T = +6 DB. VERIFIED PREVIOUSLY RECORDED LIMITATIONS. SEE ISI REPORT ISI-210T-00-002 COVERAGE CALCULATION.

Examiner	Level	Signature	Date	Reviewer	Signature	Date
Malia, Mark E.	II-PDI	<i>Mark E. Malia</i>	4/24/2009	Damon Priestley PGN Lv III	<i>Damon Priestley</i>	4/29/2009
Examiner	Level	Signature	Date	Site Review	Signature	Date
N/A	N/A			Scott Larson Level III	<i>Scott Larson</i>	4/29/2009
Other	Level	Signature	Date	ANII Review	Signature	Date
Dugan, Michael P	III-PDI	<i>Michael P. Dugan</i>	4/28/2009	Nancy Ritchie-Slaughter	<i>Nancy C. Ritchie-Slaughter</i>	5/1/09

This Document is a QA Record



UT Calibration Examination

Site/Unit: HNP / 1
 Summary No.: H-03772
 Workscope: ISI

Procedure: NDEP-0450
 Procedure Rev.: 3 TR-A
 Work Order No.: 1313525

Outage No.: RFO-15
 Report No.: UT-09-034
 Page: 3 of 9

Code: 2001 Ed 2003 Add Cat./Item: B-A/B1.30 Location: Containment 263'
 Drawing No.: 1-ISI-RV-1 Description: Reactor Vessel Head to Flange Weld
 System ID: RC-1005
 Component ID: II-RV-001FTHW-RV-18FA,B,C Size/Length: 493" Thickness/Diameter: 7"/157" ID
 Limitations: VESSEL HEAD CONFIGURATION Start Time: 1220 Finish Time: 1430

Instrument Settings
 Serial No.: 0134D2
 Manufacturer: Krautkramer Branson
 Model: USN-58L
 Delay: 15.2428 Range: 30"
 M'tl Cal/Vel: 0.1270 Pulsar: SINGLE
 Damping: 1KΩ Reject: 0%
 Rep. Rate: HIGH Freq.: 2.25 MHZ
 Filter: N/A Mode: SHEARWAVE
 Voltage: N/A Other: FULLWAVE
 Ax. Gain (dB): 54* Circ. Gain (dB): 54*
10 Screen Div. = 30 in. of Sound Path
 Linearity Report No.: L-09-001

Search Unit
 Serial No.: C18130
 Manufacturer: KBA
 Size: .50"x1.0" Shape: Rect.
 Freq.: 2.25 MHz Style: GAMMA
 Exam Angle: 60° # of Elements: 1
 Mode: SHEARWAVE
 Measured Angle: 61
 Wedge Style: LUCITE
Search Unit Cable
 Type: RG-58
 Length: 6' No. Conn.: 0

Cal. Checks	Time	Date
Initial Cal.	0830	4/24/2009
Inter. Cal.	1020	4/24/2009
Inter. Cal.	1240	4/24/2009
Inter. Cal.		
Final Cal.	1530	4/24/2009

Couplant
 Cal. Batch: 05225
 Type: Ultragel II
 Mfg.: Sonotech, Inc.
 Exam Batch: 05225
 Type: Ultragel II
 Mfg.: Sonotech, Inc.

Scan Coverage
 Upstream Downstream Scan dB: 72
 CW CCW Scan dB: 72
 Exam Surface: OD
 Surface Condition: GROUND SMOOTH

Reference Block
 Serial No.: 792221
 Type: CS Rompas

Axial Orientated Search Unit			
Calibration Reflector	Signal Amplitude %	Sweep Division	Sound Path
1/4T SDH	82	1.3	3.845
1/2T SDH	43	2.6	7.930
3/4T SDH	20	4.5	13.46
5/4T SDH	7	8.0	24.00
ID NOTCH	10	6.8	19.85

Circumferential Orientated Search Unit			
Calibration Reflector	Signal Amplitude %	Sweep Division	Sound Path

Reference/Simulator Block				
Gain dB	Reflector	Signal Amplitude %	Sweep Division	Sound Path
54	SDH	69	0.5	1.567

Calibration Block
 Cal. Block No.: UT-005-1
 Thickness: 7.0 Dia.: 157"
 Cal. Blk. Temp. 66 Temp. Tool: 68951
 Comp. Temp.: 86 Temp. Tool: 68951

Recordable Indication(s): Yes No (If Yes, Ref. Attached Ultrasonic Indication Report.)
 Results: Sat Unsat Eval
 Percent Of Coverage Obtained > 90%: 71.7% Reviewed Previous Data: Yes

Comments: * DB CHANGE FOR 3/4T AND 5/4T = +7 DB. VERIFIED PREVIOUSLY RECORDED LIMITATIONS. SEE ISI REPORT ISI-210T-00-002 FOR COVERAGE

Examiner	Level	Signature	Date	Reviewer	Signature	Date
Malia, Mark E.	II-PDI	<i>Mark E. Malia</i>	4/24/2009	Damon Priestley PGN Lv III	<i>Damon Priestley</i>	4/29/2009
N/A	N/A			Site Review Scott Larson Level III	<i>Scott Larson</i>	4/29/2009
Dugan, Michael P	III-PDI	<i>Michael P. Dugan</i>	4/28/2009	ANII Review Nancy Ritchie-Slaughter	<i>Nancy C. Ritchie-Slaughter</i>	5/5/09

This Document is a QA Record

Primary No.: H-03772

Sketch or Photo: Y:\Shared\Ideaf\HNP_Data\Outage Scans\RO-15\UT-09-034A.JPG


Data sheet 2107-00-002

SUPPLEMENTAL ULTRASONIC SHEET

FTHW - RV - 18FA, BC.

PAGE 4 OF 12

SKETCH "A" 0° COVERAGE

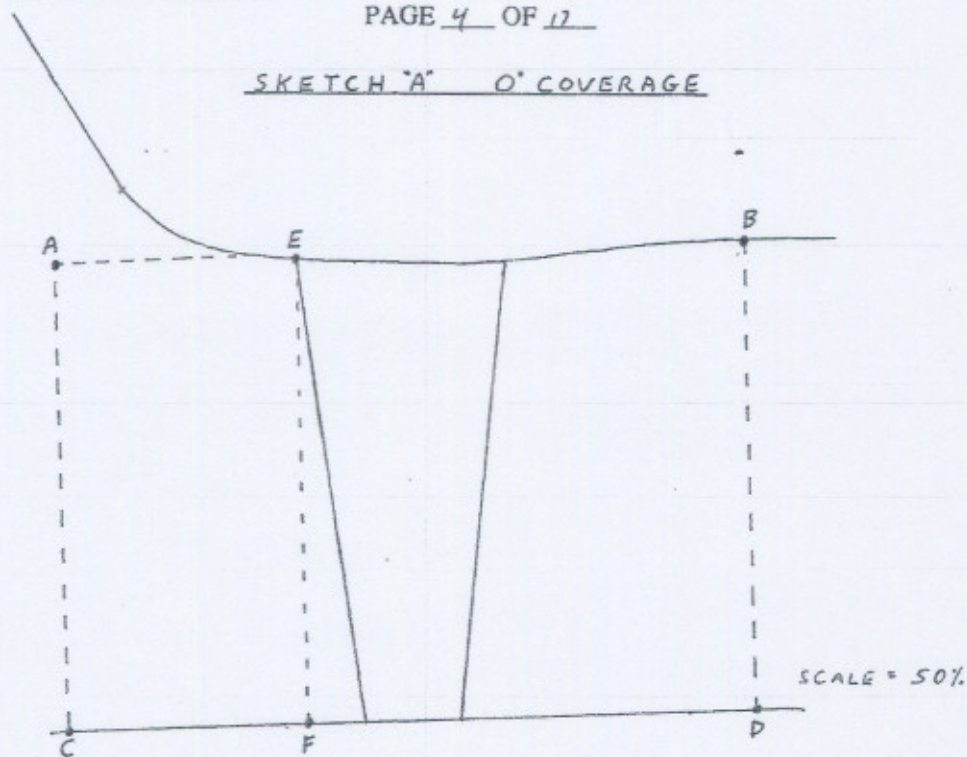

- EXAM AREA
- (ABCD) = 7" x 10" = 70 in²
- 0° EXAM
- (EBFD) = 7" x 6.5" = 45.5 in²
 - 45.5 / 70 = 65%

EXAMINER Simon Cothran LEVEL II DATE 4/21/00
 EXAMINER Michael Pitt LEVEL II DATE 4/21/00

File Mended 4/24/00

Primary No.: H-03772

Sketch or Photo: Y:\Shared\Ideal\HNP_Data\Outage Scans\RO-15\UT-09-034B.JPG


Data sheet 210T-00-002

SUPPLEMENTAL ULTRASONIC SHEET

FTHW - RV-18FA,B,C.

PAGE 5 OF 17

SKETCH "B" CIRC EXAM COVERAGE 45° + 60°

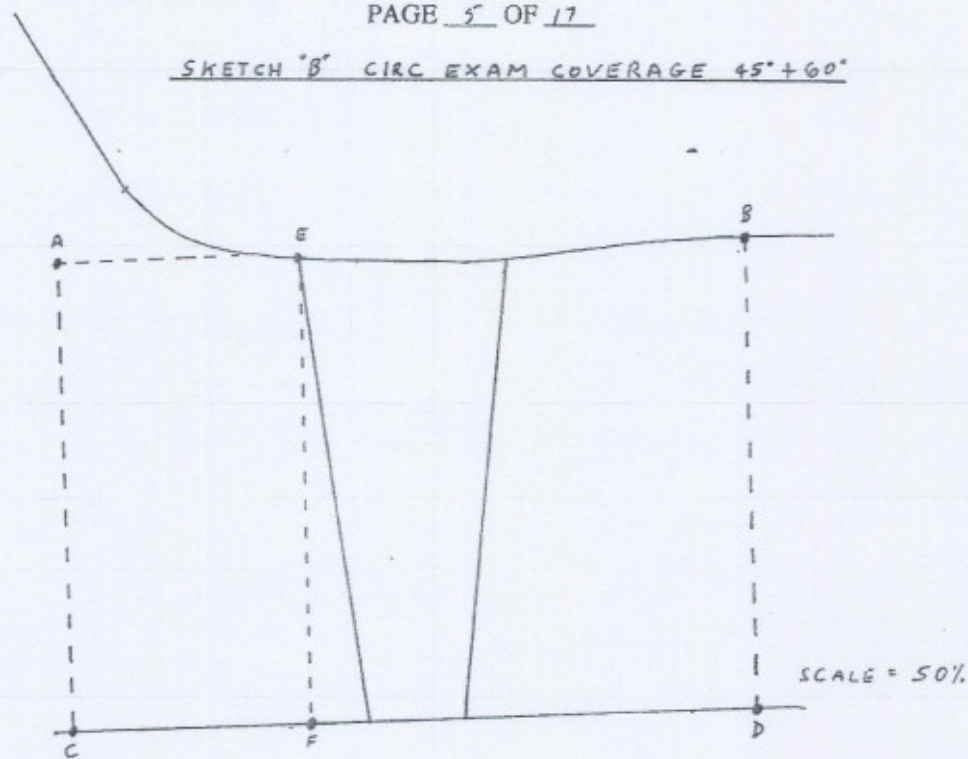

- EXAM AREA
- (ABCD) = 7' x 10' = 70 in²
- CIRC EXAM
- (EBFD) = 7' x 6.5' = 45.5 in²
 - 45.5 / 70 = 65%

EXAMINER Jim Collins LEVEL II DATE 4/21/00
 EXAMINER Michael S. Pate LEVEL II DATE 4/21/00

Del Messersch 4/21/00

Primary No.: H-03772

Sketch or Photo: Y:\Shared\Ideal\HNP_Data\Outage Scans\RO-15\UT-09-034C.JPG


Data sheet 2/07-00-002

SUPPLEMENTAL ULTRASONIC SHEET

FTHW-RV-18FA,B,C.

PAGE 6 OF 17

SKETCH "C" AXIAL EXAM OF WELD 45" + 60"

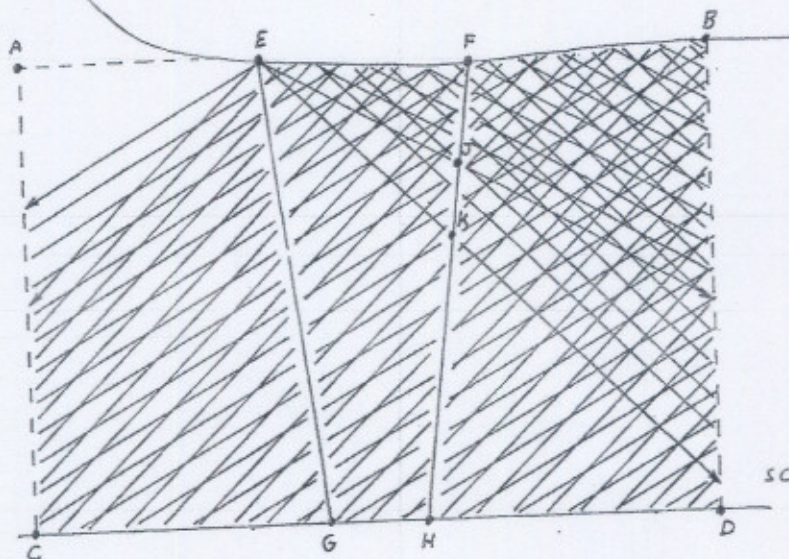

EXAM AREA

• (ABCD) = 7' x 10' = 70 in²

WELD AREA

• (EFGH) = 7 [(3' + 1.4') / 2] = 15.4 in²

• 15.4 / 70 = 0.22

• WELD AREA = 22% OF EXAM AREA

EXAMINER Simon Crothers LEVEL II DATE 4/21/00

EXAMINER Michael C. Pitt LEVEL II DATE 4/21/00

Seal Marked 4/24/01

Primary No.: H-03772

Sketch or Photo: Y:\Shared\Ideal\HNP_Data\Outage Scans\RO-15\UT-09-034D.JPG


Data sheet 2105-00-002

SUPPLEMENTAL ULTRASONIC SHEET

FTHW-RV-18FA,B,C.

PAGE 7 OF 11

SKETCH "D" AXIAL EXAM OF BASE METAL 45°+60°

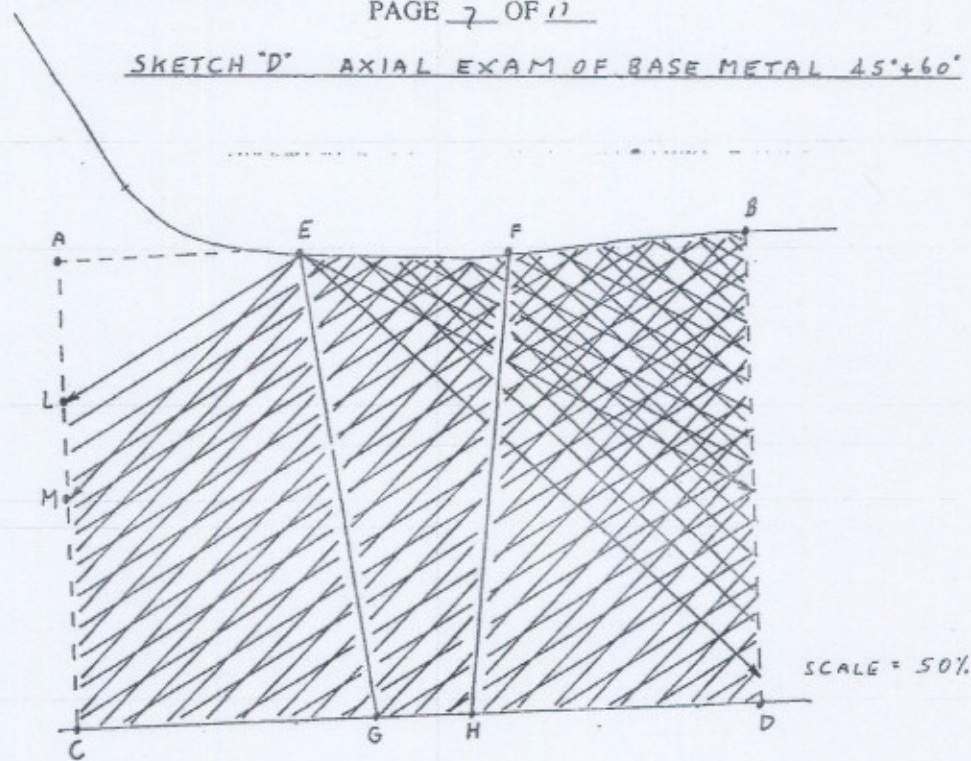

EXAM AREA
 • (ABCD) = 7' x 10' = 70 in²

BASE METAL AREA
 • (AECG) + (FBHD) = 70 in² - WELD AREA = 54.6 in²
 • BASE METAL = 78% OF EXAM AREA.

EXAMINER Jim Collins LEVEL II DATE 4/21/00
 EXAMINER Michael S. Pitt LEVEL II DATE 4/21/00

Hal Mendenhall 4/24/00

Summary No.: H-03772

Sketch or Photo: Y:\Shared\Ideal\HNP_Data\Outage Scans\RO-15\UT-09-034E.JPG

Date skoot 2105-00-002

SUPPLEMENTAL ULTRASONIC SHEET

FTHW-RV-18FA, B, C.

PAGE 8 OF 17

AXIAL EXAM COVERAGE CALC.

WELD: REQUIREMENT = 2 ANGLES X 2 DIRECTIONS = 4 BEAMS

EXAM AREA: (SKETCH 'C') = 15.4 in²

- 4 BEAMS (EFJ) = $(3.2 \times 1.4) / 2 = 2.24 \text{ in}^2$
 $2.24 / 15.4 = 15\%$ $15\% \times 4/4 \text{ BEAMS} = 15\%$
- 3 BEAMS (EJK) = $(4 \times 0.8) / 2 = 3.20 \text{ in}^2$
 $3.20 / 15.4 = 21\%$ $21\% \times 3/4 \text{ BEAMS} = 16\%$
- 2 BEAMS (EKGH) = $100\% - 15\% - 21\% = 64\%$
 $64\% \times 2/4 \text{ BEAMS} = 32\%$
- TOTAL = $15\% + 16\% + 32\% = 63\%$

BASE METAL: REQUIREMENT = ANY COMBINATION ANGLES/DIRECTIONS = 2 BEAMS

EXAM AREA: (SKETCH 'D') = 54.6 in²

- UNEXAMINED (AEL) = $(3.5 \times 2) / 2 = 3.5 \text{ in}^2$
 $3.5 / 54.6 = 6\%$
- 1 BEAM (LEM) = $(5 \times 1) / 2 = 2.5 \text{ in}^2$
 $2.5 / 54.6 = 5\%$ $5\% \times 1/2 \text{ BEAMS} = 2.5\%$
- 2 BEAMS = (MECG) + (FBHD) = $100\% - 6\% - 5\% = 89\%$
- TOTAL = $2.5\% + 89\% = 91.5\%$

EXAMINER Simon Coates LEVEL II DATE 4/21/00
 EXAMINER Michael Pelt LEVEL II DATE 4/21/00

Del Murch 4/21/00

Summary No.: H-03772

Sketch or Photo: Y:\Shared\Ideas\HNP_Data\Outage Scans\RO-15\UT-09-034F.JPG

Data sheet 2105-00-002

SUPPLEMENTAL ULTRASONIC SHEET

FTHW-RV-18 FA, B, C.

PAGE 9 OF 17

COVERAGE SUMMARY

O (SKETCH "A") = 65%

CIRC EXAM (SKETCH B) = 65%

AXIAL EXAM

- WELD (SKETCH "C") = 63%
- BASE METAL (SKETCH "D") = 91.5%
- TOTAL = (63% x 22%) + (91.5% x 78%) = 85%

Total Coverage = $\frac{65 + 65 + 85}{3} = 71.7\%$

EXAMINER Simon Collins LEVEL II DATE 4/21/00
 EXAMINER Michael C. Pate LEVEL II DATE 4/21/00

Del. Murchak 4/24/00



UT Calibration/Examination

Site/Unit: HNP / 1
 Summary No.: H-03872
 Workscope: ISI

Procedure: NDEP-0450
 Procedure Rev.: 4
 Work Order No.: 2050436

Outage No.: RFO-17
 Report No.: UT-12-022
 Page: 1 of 6

Code: 2001 Edition, 2003 Addenda Cat./Item: B-B/B2.40 Location: Containment 257'
 Drawing No.: 1-JSI-SG-2 Description: Steam Generator "B" Tube Sheet to Head Weld
 System ID: RC-3005
 Component ID: II-SG-001SGB-TSTHW-06-1 Size/Length: 428" Thickness/Diameter: 5.26"
 Limitations: SUPPORTS & INLET NOZZLE, SEE SUPPLEMENTAL REPORTS Start Time: 1245 Finish Time: 1515

Instrument Settings
 Serial No.: 0134L2 Manufacturer: Krautkramer Branson Model: USN 58L Linearity: L-12-004
 Delay: 0.8412 μs Range: 10.000" M'tl Cal/Vel: 0.2322"/μs Energy: High
 Damping: 1000 Ohms Reject: 0% PRF Mode: Auto High SU Freq.: 2.25 MHz
 Disp. Start: IP Rectify: Full Wave Inst. Freq.: 2.25 MHz

Ax. Gain (dB): 33 Circ. Gain (dB): 33
1 Screen Div. = 1 in. of Sound Path

Calibration Block
 Cal. Block No.: UT-063-1
 Thickness: 5.25" Dia.: FLAT
 Cal. Bk. Temp.: 80° Temp. Tool: 277569
 Comp. Temp.: 91° Temp. Tool: 277569

Search Unit
 Serial No.: K27132 Manufacturer: KB AeroTech Size: 0.75" Model: Alpha
 Freq.: 2.25 MHz Center Freq.: N/A Exam Angle: 0° Squint Angle: N/A
 Measured Angle: 0° Mode: LONG Exit Point: N/A # of Elements: 1
 Config.: SINGLE Focus: N/A Shape: ROUND Contour: FLAT
 Wedge Style: N/A

Search Unit Cable
 Type: RG58 Length: 12' No. Conn.: 0

Scan Coverage
 Upstream Downstream Scan dB: 63
 CW CCW Scan dB: 63
 Exam Surface: OUTSIDE DIAMETER
 Surface Condition: GROUND FLUSH

Cal. Checks	Time	Date
Initial Cal.	1200	5/4/2012
Inter. Cal.	N/A	
Inter. Cal.	N/A	
Inter. Cal.	N/A	
Final Cal.	1540	5/4/2012

Couplant
 Cal. Batch: 05325
 Type: Ultragel II
 Mfg.: Sonotech, Inc.
 Exam Batch: 05325
 Type: Ultragel II
 Mfg.: Sonotech, Inc.

Reference Block
 Serial No.: 6045-83
 Type: CS Rompas

Axial Orientated Search Unit			
Calibration Reflector	Signal Amplitude %	Sweep Division	Sound Path
1/4 T	80%	1.2	1.200"
1/2 T	70%	2.5	2.506"
3/4 T	39%	3.8	3.812"
*BW	57%	5.4	5.398"
N/A	N/A	N/A	N/A

Circumferential Orientated Search Unit			
Calibration Reflector	Signal Amplitude %	Sweep Division	Sound Path
N/A	N/A	N/A	N/A

Reference/Simulator Block				
Gain dB	Reflector	Signal Amplitude %	Sweep Division	Sound Path
33	FSDH	50%	0.7	0.690"
N/A	N/A	N/A	N/A	N/A

Recordable Indication(s): Yes No (If Yes, Ref. Attached Ultrasonic Indication Report.)
 Results: Sat Unsat Eval
 Percent Of Coverage Obtained > 90%: **70.1% Reviewed Previous Data: YES

Comments: *6 dB, **SEE ATTACHED COVERAGE CALCULATIONS FOR MORE DETAIL. SUPPLEMENTAL REPORTS BASED ON PREVIOUS DATA FROM REPORT NO. UT-04-023.

Examiner	Level	II-PDI	Signature	Date	Reviewer	Signature	Date
Malia, Mark			<i>Mark Malia</i>	5/4/2012	George Buck Level III	<i>George Buck</i>	5/5/2012
Examiner	Level	N/A	Signature	Date	Site Review	Signature	Date
N/A					James Salton	<i>James Salton</i>	5/5/2012
Other	Level	N/A	Signature	Date	ANII Review	Signature	Date
N/A					Robert Winegarden ANII	<i>Robert Winegarden</i>	5/7/2012



UT Calibration/Examination

Site/Unit: HNP / 1
 Summary No.: H-03872
 Workscope: ISI

Procedure: NDEP-0450
 Procedure Rev.: 4
 Work Order No.: 2050436

Outage No.: RFO-17
 Report No.: UT-12-022
 Page: 2 of 6

Code: 2001 Edition, 2003 Addenda Cat./Item: B-B/B2.40 Location: Containment 257'
 Drawing No.: 1-ISI-SG-2 Description: Steam Generator "B" Tube Sheet to Head Weld
 System ID: RC-3005
 Component ID: II-SG-001SGB-TSTHW-06-1 Size/Length: 428" Thickness/Diameter: 5.26"
 Limitations: SUPPORTS & INLET NOZZLE, SEE SUPPLEMENTAL REPORT Start Time: 1245 Finish Time: 1515

Instrument Settings
 Serial No.: 021063 Manufacturer: General Electric Model: USN 58Lsw Linearity: L-12-001
 Delay: 17.203 µs Range: 15.000" M'tl Cal/Vel: 0.1280"/µs Pulsar Type: Square
 Damping: 500 Ohms Reject: 0% PRF: Auto High SU Freq.: 2.25 MHz
 Frequency: 2.25 MHz Rectify: Fullwave Voltage: 450 Pulse Width: 220
 Ax. Gain (dB): 40 Circ. Gain (dB): N/A
1 Screen Div. = 1.5 in. of Sound Path

Search Unit
 Serial No.: M20228 Manufacturer: KB AeroTech Size: 0.5" x 1" Model: Gamma
 Freq.: 2.25 MHz Center Freq.: N/A Exam Angle: 60° Squint Angle: N/A
 Measured Angle: 63° Mode: SHEAR Exit Point: 0.65" # of Elements: 1
 Config.: SINGLE Focus: N/A Shape: RECT. Contour: N/A
 Wedge Style: NON INTEGRAL

Cal. Checks	Time	Date
Initial Cal.	1023	5/4/2012
Inter. Cal.	1245	5/4/2012
Inter. Cal.	N/A	
Inter. Cal.	N/A	
Final Cal.	1545	5/4/2012

Couplant
 Cal. Batch: 05325
 Type: Ultragel II
 Mfg.: Sonotech, Inc.
 Exam Batch: 05325
 Type: Ultragel II
 Mfg.: Sonotech, Inc.

Axial Orientated Search Unit			
Calibration Reflector	Signal Amplitude %	Sweep Division	Sound Path
1/4 T	80%	1.8	2.65"
1/2 T	48%	3.6	5.38"
3/4 T	25%	5.4	8.15"
ID	10%	7.6	11.4"
5/4 T	16%	9.8	14.7"

Circumferential Orientated Search Unit			
Calibration Reflector	Signal Amplitude %	Sweep Division	Sound Path
N/A	N/A	N/A	N/A

Search Unit Cable
 Type: RG174 Length: 6' No. Conn.: 0

Scan Coverage
 Upstream Downstream Scan dB: 70
 CW CCW Scan dB: 70
 Exam Surface: OUTSIDE DIAMETER
 Surface Condition: GROUND FLUSH

Reference Block
 Serial No.: 792221
 Type: CS Rompas

Reference/Simulator Block				
Gain dB	Reflector	Signal Amplitude %	Sweep Division	Sound Path
48	FSDH	80%	1.6	1.51"
N/A	N/A	N/A	N/A	N/A

Recordable Indication(s): Yes No (If Yes, Ref. Attached Ultrasonic Indication Report.)
 Results: Sat Unsat Eval
 Percent Of Coverage Obtained > 90%: **70.1% Reviewed Previous Data: YES

Comments: ****SEE ATTACHED COVERAGE CALCULATIONS FOR MORE DETAIL. SUPPLEMENTAL REPORTS BASED ON PREVIOUS DATA FROM REPORT NO. UT-04-023.**

Examiner	Level	Signature	Date	Reviewer	Signature	Date
Mahoney, Patrick V.	II	<i>[Signature]</i>	5/4/2012	George Buck Level III	<i>[Signature]</i>	5/5/2012
Examiner	Level	Signature	Date	Site Review	Signature	Date
N/A	N/A			James Salton	<i>[Signature]</i>	5/5/2012
Other	Level	Signature	Date	ANII Review	Signature	Date
N/A	N/A			Robert Winegarden ANII	<i>[Signature]</i>	5/7/2012



UT Calibration/Examination

Site/Unit: HNP / 1
 Summary No.: H-03872
 Workscope: ISI

Procedure: NDEP-0450
 Procedure Rev.: 4
 Work Order No.: 2050436

Outage No.: RFO-17
 Report No.: UT-12-022
 Page: 3 of 6

Code: 2001 Edition, 2003 Addenda Cat./Item: B-B/B2.40 Location: Containment 257'
 Drawing No.: 1-ISI-SG-2 Description: Steam Generator "B" Tube Sheet to Head Weld
 System ID: RC-3005
 Component ID: II-SG-001SGB-TSTHW-06-1 Size/Length: 428" Thickness/Diameter: 5.26"
 Limitations: SUPPORTS & INLET NOZZLE, SEE SUPPLEMENTAL REPORTS Start Time: 1245 Finish Time: 1515

Instrument Settings
 Serial No.: 021063
 Manufacturer: General Electric
 Model: USN 58Lsw Linearity: L-12-001
 Delay: 12.6941 μs Range: 10.000"
 M'tl Cal/Vel: 0.1280"/μs Pulsar Type: Square
 Damping: 500 Ohms Reject: 0%
 PRF: Auto High SU Freq.: 2.25 MHz
 Frequency: 2.25 MHz Rectify: Fullwave
 Voltage: 450 Pulse Width: 220

Ax. Gain (dB): 33 Circ. Gain (dB): N/A
1 Screen Div. = 1.0 in. of Sound Path

Calibration Block
 Cal. Block No.: UT-063-1
 Thickness: 5.25" Dia.: FLAT
 Cal. Blk. Temp.: 80° Temp. Tool: 277510
 Comp. Temp.: 91° Temp. Tool: 277510

Recordable Indication(s): Yes No (If Yes, Ref. Attached Ultrasonic Indication Report.)
 Results: Sat Unsat Eval
 Percent Of Coverage Obtained > 90%: **70.1% Reviewed Previous Data: YES

Search Unit
 Serial No.: C18133
 Manufacturer: KB AeroTech
 Size: 0.5" x 1" Model: Gamma
 Freq.: 2.25 MHz Center Freq.: N/A
 Exam Angle: 45° Squint Angle: N/A
 Measured Angle: 45° Mode: SHEAR
 Exit Point: 0.65" # of Elements: 1
 Config.: SINGLE Focus: N/A
 Shape: RECT. Contour: N/A
 Wedge Style: NON INTEGRAL

Search Unit Cable
 Type: RG58 Length: 6' No. Conn.: 0

Scan Coverage
 Upstream Downstream Scan dB: 66
 CW CCW Scan dB: 66
 Exam Surface: OUTSIDE DIAMETER
 Surface Condition: GROUND FLUSH

Cal. Checks	Time	Date
Initial Cal.	1015	5/4/2012
Inter. Cal.	N/A	
Inter. Cal.	1415	5/4/2012
Inter. Cal.	N/A	
Final Cal.	1540	5/4/2012

Couplant
 Cal. Batch: 05325
 Type: Ultragel II
 Mfg.: Sonotech, Inc.
 Exam Batch: 05325
 Type: Ultragel II
 Mfg.: Sonotech, Inc.

Reference Block
 Serial No.: 792221
 Type: CS Rompas

Axial Orientated Search Unit			
Calibration Reflector	Signal Amplitude %	Sweep Division	Sound Path
1/4 T	80%	1.8	1.79"
1/2 T	51%	3.6	3.66"
3/4 T	34%	5.5	5.5"
ID	12%	7.8	7.78"
5/4 T	24%	9.8	9.8"

Circumferential Orientated Search Unit			
Calibration Reflector	Signal Amplitude %	Sweep Division	Sound Path
N/A	N/A	N/A	N/A

Reference/Simulator Block				
Gain dB	Reflector	Signal Amplitude %	Sweep Division	Sound Path
39	FSDH	80%	1.0	1.06"
N/A	N/A	N/A	N/A	N/A

Comments: ****SEE ATTACHED COVERAGE CALCULATION FOR MORE DETAIL. SUPPLEMENTAL REPORTS BASED ON PREVIOUS DATA FROM REPORT NO. UT-04-023.**

Examiner	Level	Signature	Date	Reviewer	Signature	Date
Mahoney, Patrick V.	II	<i>Patrick Mahoney</i>	5/4/2012	George Buck Level III	<i>George Buck</i>	5/5/2012
Examiner	Level	Signature	Date	Site Review	Signature	Date
N/A	N/A			James Salton	<i>James Salton</i>	5/5/2012
Other	Level	Signature	Date	ANII Review	Signature	Date
N/A	N/A			Robert Winegarden ANII	<i>Robert Winegarden</i>	5/7/2012



Supplemental Report

Report No.: UT-12-022

Page: 4 of 6

Summary No.: H-03872

Sketch or Photo: Y:\Shared\Ideas\HNP_Data\DataSheet_Info\UT-12-022-2.jpg

WELD MATERIAL

0 deg Planar

Scan 76.600 % Length X 100.000 % volume of length / 100 = 76.600 % total for 0 deg

45 deg

Scan 1 76.600 % Length X 100.000 % volume of length / 100 = 76.600 % total for Scan 1

Scan 2 76.600 % Length X 59.540 % volume of length / 100 = 45.608 % total for Scan 2

Scan 3 76.600 % Length X 100.000 % volume of length / 100 = 76.600 % total for Scan 3

Scan 4 76.600 % Length X 100.000 % volume of length / 100 = 76.600 % total for Scan 4

Add totals and divide by # scans = 68.852 % total for 45 deg

Other deg 60

Scan 1 76.600 % Length X 100.000 % volume of length / 100 = 76.600 % total for Scan 1

Scan 2 76.600 % Length X 38.730 % volume of length / 100 = 29.667 % total for Scan 2

Scan 3 76.600 % Length X 100.000 % volume of length / 100 = 76.600 % total for Scan 3

Scan 4 76.600 % Length X 100.000 % volume of length / 100 = 76.600 % total for Scan 4

Add totals and divide by # scans = 64.867 % total for 60 deg

Percent complete coverage

Add totals for each angle and scan required and divide by # of angles to determine;

70.106 % Total for complete exam

Note:

Supplemental coverage may be achieved by use of other angles / methods. When used, the coverage for volume not obtained with angles as noted above shall be calculated and added to the total to provide the percent total for the complete examination.

Site Field Supervisor: Edmund Donovan

Date: 5/4/2012

This Document is a QA Record



Supplemental Report

Report No.: UT-12-022

Page: 5 of 6

Summary No.: H-03872

Sketch or Photo: Y:\Shared\Ideas\HNP_Data\DataSheet_Info\UT-12-022-3.jpg

BASE METAL

0 deg Planar

Scan 76.600 % Length X 94.960 % volume of length / 100 = 72.739 % total for 0 deg

45 deg

Scan 1 76.600 % Length X 99.130 % volume of length / 100 = 75.934 % total for Scan 1

Scan 2 _____ % Length X _____ % volume of length / 100 = _____ % total for Scan 2

Scan 3 76.600 % Length X 100.000 % volume of length / 100 = 76.600 % total for Scan 3

Scan 4 76.600 % Length X 100.000 % volume of length / 100 = 76.600 % total for Scan 4

Add totals and divide by # scans = 76.378 % total for 45 deg

Other deg 60

Scan 1 76.600 % Length X 99.540 % volume of length / 100 = 76.248 % total for Scan 1

Scan 2 _____ % Length X _____ % volume of length / 100 = _____ % total for Scan 2

Scan 3 76.600 % Length X 100.000 % volume of length / 100 = 76.600 % total for Scan 3

Scan 4 76.600 % Length X 100.000 % volume of length / 100 = 76.600 % total for Scan 4

Add totals and divide by # scans = 76.483 % total for 60 deg

Percent complete coverage

Add totals for each angle and scan required and divide by # of angles to determine;

75.200 % Total for complete exam

Note:

Supplemental coverage may be achieved by use of other angles / methods. When used, the coverage for volume not obtained with angles as noted above shall be calculated and added to the total to provide the percent total for the complete examination.

Site Field Supervisor: Edmund Donovan

Date: 5/4/2012


This Document is a QA Record

Limitation Record

Site/Unit:	<u>HNP / 1</u>	Procedure:	<u>NDEP-0450</u>	Outage No.:	<u>RFO-17</u>
Summary No.:	<u>H-03872</u>	Procedure Rev.:	<u>4</u>	Report No.:	<u>UT-12-022</u>
Workscope:	<u>ISI</u>	Work Order No.:	<u>2050436</u>	Page:	<u>6</u> of <u>6</u>

Description of Limitation:

STEAM GENERATOR SUPPORTS AND INLET NOZZLE.

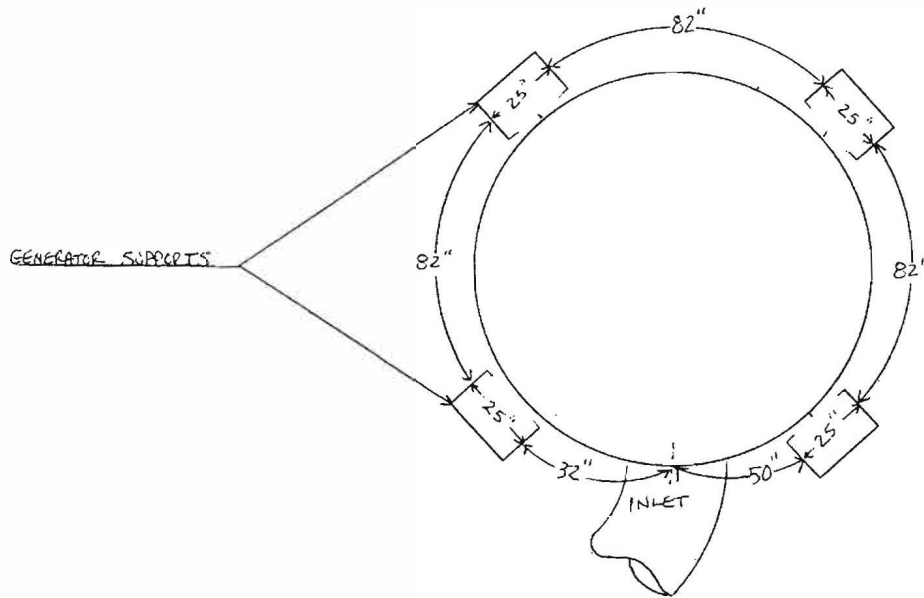

TOTAL CIRCUMFERENCE - 428" - 100%
 TOTAL OBSTRUCTION (4) x 25" = 100" - 23.4%
 TOTAL SCANNABLE CIRC 328" - 76.6%



UT Calibration Examination

Site/Unit: HNP / 1
 Summary No.: H-02997
 Workscope: ISI

Procedure: NDEP-0450
 Procedure Rev.: 3 TR-A
 Work Order No.: 1313525

Outage No.: RFO-15
 Report No.: UT-09-038
 Page: 1 of 13

Code: 2001 Ed 2003 Add Cat./Item: B-D/B3.110 Location: CTMT 302'
 Drawing No.: 1-ISI-PZR-1 Description: Nozzle to Head
 System ID: RC-2050
 Component ID: II-PZR-01NTHW-10 Size/Length: 3.15" / 47.1" Thickness/Diameter: 3.35" / 15.0"
 Limitations: NOZZLE TO HEAD CONFIGURATION Start Time: 1400 Finish Time: 1545

Instrument Settings
 Serial No.: 0134D2
 Manufacturer: Krautkramer Branson
 Model: USN-58L
 Delay: 1.3306 Range: 5.0"
 M'tl Cal/Vel: 0.2358 Pulsar: SINGLE
 Damping: 1KQ Reject: 0%
 Rep. Rate: HIGH Freq.: 2.25 MHZ
 Filter: N/A Mode: LOGITUDINAL
 Voltage: N/A Other: FULLWAVE
 Ax. Gain (dB): 29 Circ. Gain (dB): 29
10 Screen Div. = 5 in. of Sound Path
 Linearity Report No.: L-09-001

Search Unit
 Serial No.: C29344
 Manufacturer: KB AeroTech
 Size: 0.75 Shape: Round
 Freq.: 2.25 MHZ Style: Gamma
 Exam Angle: 0° # of Elements: 1
 Mode: Longitudinal
 Measured Angle: N/A
 Wedge Style: N/A

Search Unit Cable
 Type: RG-158
 Length: 6' No. Conn.: 0

Cal. Checks	Time	Date
Initial Cal.	1030	4/25/2009
Inter. Cal.	1400	4/25/2009
Inter. Cal.	1545	4/25/2009
Inter. Cal.		
Final Cal.	1730	4/25/2009

Couplant
 Cal. Batch: 05225
 Type: Ultragel II
 Mfg.: Sonotech, Inc.
 Exam Batch: 05225
 Type: Ultragel II
 Mfg.: Sonotech, Inc.

Reference Block
 Serial No.: 792221
 Type: CS Rompas

Axial Orientated Search Unit			
Calibration Reflector	Signal Amplitude %	Sweep Division	Sound Path
1/4 T	66	1.6	0.790
1/2 T	82	3.2	1.670
3/4 T	58	5.1	2.554
ID	>100%	7.2	3.562

Circumferential Orientated Search Unit			
Calibration Reflector	Signal Amplitude %	Sweep Division	Sound Path
N/A	N/A	N/A	N/A

Reference/Simulator Block				
Gain dB	Reflector	Signal Amplitude %	Sweep Division	Sound Path
29	SDH	52	0.7	0.727

Calibration Block
 Cal. Block No.: UT-050-1
 Thickness: 3.50 Dia.: Flat
 Cal. Blk. Temp.: 78° Temp. Tool: 68951
 Comp. Temp.: 88° Temp. Tool: 68951
 Upstream Downstream Scan dB: 41
 CW CCW Scan dB: N/A
 Exam Surface: OD
 Surface Condition: GROUND SMOOTH

Recordable Indication(s): Yes No (If Yes, Ref. Attached Ultrasonic Indication Report.)

Results: Sat Unsat Eval
 Percent Of Coverage Obtained > 90%: *67.14% Reviewed Previous Data: Yes

Comments: ***Verified previously recorded limitations and coverage calculations from report #210-98-02 (See Extracted Pages Attached). Examination was in a Radiation area.**

Examiner	Level	II-PDI	Signature	Date	Reviewer	Signature	Date
Malia, Mark E.			<i>Mark E. Malia</i>	4/25/2009	Damon Priestley PGN Lv III	<i>Damon Priestley</i>	4/29/2009
Examiner	Level	N/A	Signature	Date	Site Review	Signature	Date
N/A					Michael W. Blew	<i>Michael W. Blew</i>	4/29/2009
Other	Level	III-PDI	Signature	Date	ANII Review	Signature	Date
Dugan, Michael P			<i>Michael P. Dugan</i>	4/28/2009	Nancy Ritchie-Slaughter	<i>Nancy Ritchie-Slaughter</i>	5/5/09



UT Calibration Examination

Site/Unit: HNP / 1
 Summary No.: H-02997
 Workscope: ISI

Procedure: NDEP-0450
 Procedure Rev.: 3 TR-A
 Work Order No.: 1313525

Outage No.: RFO-15
 Report No.: UT-09-038
 Page: 2 of 13

Code: 2001 Ed 2003 Add Cat./Item: B-D/B3.110 Location: CTMT 302'
 Drawing No.: 1-ISI-PZR-1 Description: Nozzle to Head
 System ID: RC-2050
 Component ID: II-PZR-01NTHW-10 Size/Length: 3.15" / 47.1" Thickness/Diameter: 3.35" / 15.0"
 Limitations: NOZZLE TO HEAD CONFIGURATION Start Time: 1400 Finish Time: 1545

Instrument Settings
 Serial No.: 0134D2
 Manufacturer: Krautkramer Branson
 Model: USN-58L
 Delay: 12.1922 Range: 10
 M'tl Cal/Vel: 0.1270 Pulsar: SINGLE
 Damping: 1KΩ Reject: 0%
 Rep. Rate: HIGH Freq.: 2.25 MHZ
 Filter: N/A Mode: SHEARWAVE
 Voltage: N/A Other: FULLWAVE
 Ax. Gain (dB): 42 Circ. Gain (dB): N/A
10 Screen Div. = 10 in. of Sound Path
 Linearity Report No.: L-09-001

Search Unit
 Serial No.: C18133
 Manufacturer: KB AeroTech
 Size: .5" x 1" Shape: Rect.
 Freq.: 2.25 MHz Style: Gamma
 Exam Angle: 45° # of Elements: 1
 Mode: Shear
 Measured Angle: 45°
 Wedge Style: SWS
Search Unit Cable
 Type: RG-58
 Length: 6' No. Conn.: 0

Cal. Checks	Time	Date
Initial Cal.	1035	4/25/2009
Inter. Cal.	1415	4/25/2009
Inter. Cal.	1600	4/25/2009
Inter. Cal.		
Final Cal.	1730	4/25/2009

Couplant
 Cal. Batch: 05225
 Type: Ultragel II
 Mfg.: Sonotech, Inc.
 Exam Batch: 05225
 Type: Ultragel II
 Mfg.: Sonotech, Inc.

Reference Block
 Serial No.: 792221
 Type: CS Rompas

Axial Orientated Search Unit			
Calibration Reflector	Signal Amplitude %	Sweep Division	Sound Path
1/4 T	85	1.2	1.159
1/2 T	62	2.4	2.383
3/4 T	40	3.6	3.649
ID NOTCH	13	5.2	5.146
5/4 T	10	6.1	6.00

Circumferential Orientated Search Unit			
Calibration Reflector	Signal Amplitude %	Sweep Division	Sound Path

Reference/Simulator Block				
Gain dB	Reflector	Signal Amplitude %	Sweep Division	Sound Path
42	SDH	45	1.0	1.024

Calibration Block
 Cal. Block No.: UT-050-1
 Thickness: 3.50 Dia.: Flat
 Cal. Blk. Temp.: 78° Temp. Tool: 68951
 Comp. Temp.: 88° Temp. Tool: 68951

Scan Coverage
 Upstream Downstream Scan dB: 62
 CW CCW Scan dB: 62
 Exam Surface: OD
 Surface Condition: GROUND SMOOTH

Recordable Indication(s): Yes No (If Yes, Ref. Attached Ultrasonic Indication Report.)

Results: Sat Unsat Eval

Comments: **VERIFIED PREVIOUSLY RECORDED LIMITATIONS. SEE REPORT #210-98-02 FOR COVERAGE CALCULATION. Db DIFFERENCE FOR 3/4T TO 5/4T = 14dB.**

Percent Of Coverage Obtained > 90%: 67.14% Reviewed Previous Data: Yes

Examiner	Level	II-PDI	Signature	Date	Reviewer	Signature	Date
Malia, Mark E.			<i>Mark E Malia</i>	4/25/2009	Damon Priestley PGN Lv III	<i>Damon Priestley</i>	4/29/2009
Examiner	Level	N/A	Signature	Date	Site Review	Signature	Date
N/A					Michael W. Blew	<i>Michael W. Blew</i>	4/29/2009
Other	Level	III-PDI	Signature	Date	ANII Review	Signature	Date
Dugan, Michael P			<i>Michael P Dugan</i>	4/29/2009	Nancy Ritchie-Slaughter	<i>Nancy C Ritchie-Slaughter</i>	5/5/09

This Document is a QA Record



UT Calibration Examination

Site/Unit: HNP / 1
 Summary No.: H-02997
 Workscope: ISI

Procedure: NDEP-0450
 Procedure Rev.: 3 TR-A
 Work Order No.: 1313525

Outage No.: RFO-15
 Report No.: UT-09-038
 Page: 3 of 13

Code: 2001 Ed 2003 Add Cat./Item: B-D/B3.110 Location: CTMT 302'
 Drawing No.: 1-ISI-PZR-1 Description: Nozzle to Head
 System ID: RC-2050
 Component ID: II-PZR-01NTHW-10 Size/Length: 3.15" / 47.1" Thickness/Diameter: 3.35" / 15.0"
 Limitations: NOZZLE TO HEAD CONFIGURATION Start Time: 1400 Finish Time: 1545

Instrument Settings
 Serial No.: 0134D2
 Manufacturer: Krautkramer Branson
 Model: USN-58L
 Delay: 15.2428 Range: 10"
 M'tl Cal/Vel: 0.1270 Pulsar: SINGLE
 Damping: 1KΩ Reject: 0%
 Rep. Rate: HIGH Freq.: 2.25 MHZ
 Filter: N/A Mode: SHEARWAVE
 Voltage: N/A Other: FULLWAVE
 Ax. Gain (dB): 49/63* Circ. Gain (dB): 49/63*
10 Screen Div. = 10 in. of Sound Path
 Linearity Report No.: L-09-001

Search Unit
 Serial No.: C18130
 Manufacturer: KBA
 Size: .50"x1.0" Shape: Rect.
 Freq.: 2.25 MHz Style: GAMMA
 Exam Angle: 60° # of Elements: 1
 Mode: Shear
 Measured Angle: 61°
 Wedge Style: SWS

Search Unit Cable
 Type: RG-58
 Length: 6' No. Conn.: 0

Cal. Checks	Time	Date
Initial Cal.	1040	4/25/2009
Inter. Cal.	1430	4/25/2009
Inter. Cal.	1615	4/25/2009
Inter. Cal.		
Final Cal.	1730	4/25/2009

Couplant
 Cal. Batch: 05225
 Type: Ultragel II
 Mfg.: Sonotech, Inc.
 Exam Batch: 05225
 Type: Ultragel II
 Mfg.: Sonotech, Inc.

Reference Block
 Serial No.: 792221
 Type: CS Rompas

Axial Orientated Search Unit			
Calibration Reflector	Signal Amplitude %	Sweep Division	Sound Path
1/4 T	83	1.8	1.823
1/2 T	49	3.6	3.598
3/4 T	31	5.4	5.38
ID NOTCH	11	7.3	7.298
5/4 T	10	9.4	9.40

Circumferential Orientated Search Unit			
Calibration Reflector	Signal Amplitude %	Sweep Division	Sound Path

Reference/Simulator Block				
Gain dB	Reflector	Signal Amplitude %	Sweep Division	Sound Path
49	SDH	21	1.6	1.557

Calibration Block
 Cal. Block No.: UT-050-1
 Thickness: 3.50 Dia.: Flat
 Cal. Blk. Temp. 78° Temp. Tool: 68951
 Comp. Temp.: 80° Temp. Tool: 68951
 Upstream Downstream Scan dB: 69
 CW CCW Scan dB: 69
 Exam Surface: OD
 Surface Condition: GROUND SMOOTH

Recordable Indication(s): Yes No (If Yes, Ref. Attached Ultrasonic Indication Report.)

Results: Sat Unsat Eval
 Percent Of Coverage Obtained > 90%: 67.14% Reviewed Previous Data: Yes

Comments: **VERIFIED PREVIOUSLY RECORDED LIMITATIONS. SEE REPORT #210-98-02 FOR COVERAGE CALCULATION. Db DIFFERENCE FOR 3/4T TO 5/4T = 14dB.**

Examiner	Level	Signature	Date	Reviewer	Signature	Date
Malia, Mark E.	II-PDI	<i>Mark E. Malia</i>	4/25/2009	Damon Priestley PGN Lv III	<i>[Signature]</i>	4/29/2009
N/A	N/A			Michael W. Blew	<i>MWB</i>	4/29/2009
Dugan, Michael P	III-PDI	<i>[Signature]</i>	4/29/2009	Nancy Ritchie-Slaughter	<i>Nancy C Ritchie-Slaughter</i>	5/5/09


This Document is a QA Record

Primary No.: H-02997

Sketch or Photo: Y:\Shared\Ideal\HNP_Data\Outage Scans\RO-15\UT-09-038A.JPG

DATA SHEET # 2.10.98-02
 PAGE 2 OF 15
 ISO# 1-JST-P2R-1
 WELD# UT#W-10

WELD LENGTH = 47.1 in
 REQUIRED EXAM VOLUME = (ABEF)(47.1) = 749.4 in³
 VOLUME NOT EXAMINED = (ABCD)(47.1) = 252.5 in³
 % INCOMPLETE = $\left[\frac{252.5}{749.4} \right] 100 = 33.7\%$
 % COMPLETE = 100 - 33.7 = 66.3%

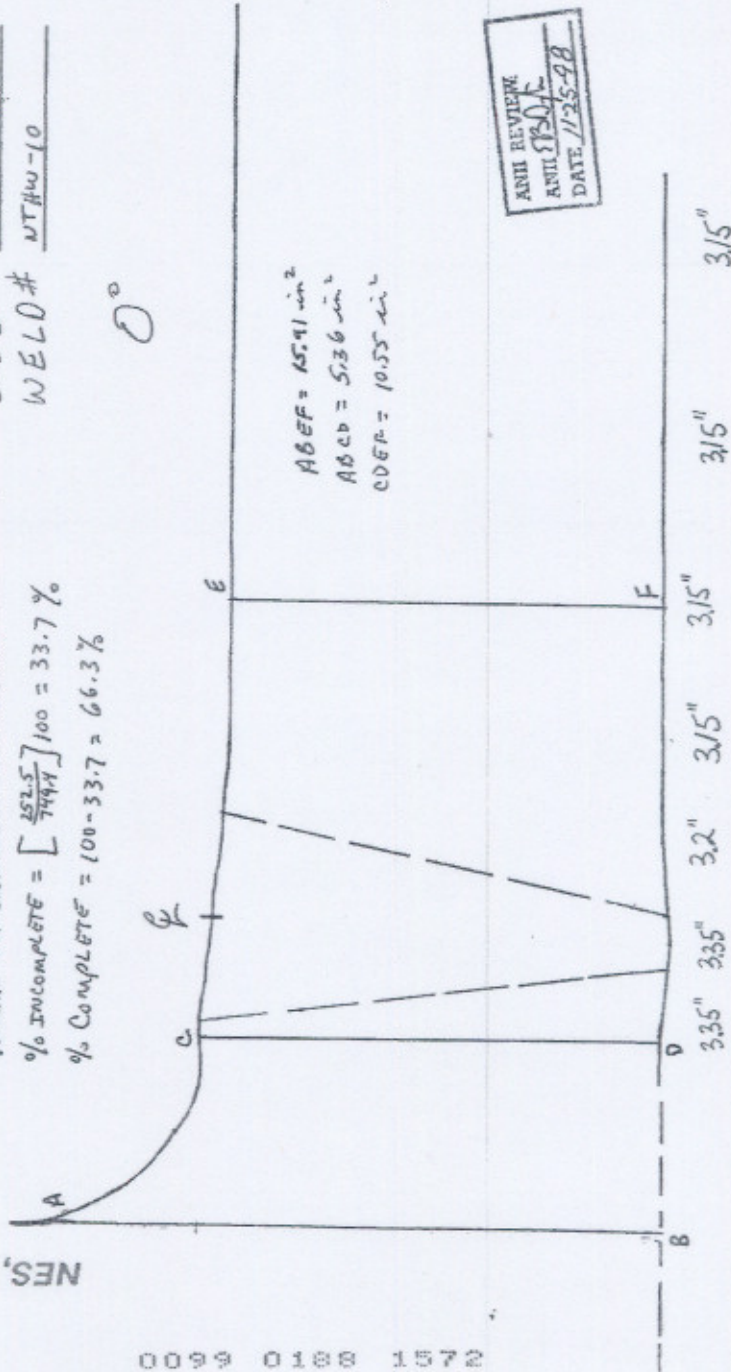

EXAMINER Edmund Dorgan LEVEL II DATE 10-30-98
 EXAMINER Delly Mudgett LEVEL III DATE 12-22-98
 REVIEWER Scott Jones LEVEL III DATE 11-3-98


NES, Inc.

0099 0188 1572

Primary No.: H-02997

Sketch or Photo: Y:\Shared\IdeallHNP_Data\Outage Scans\RO-15\UT-09-038B.JPG

5/11/11-98
 DATA SHEET # 210.93.02.98.02
 PAGE 6 OF 15
 ISO# 1-EST-PZR-1
 WELD# NTHW-10

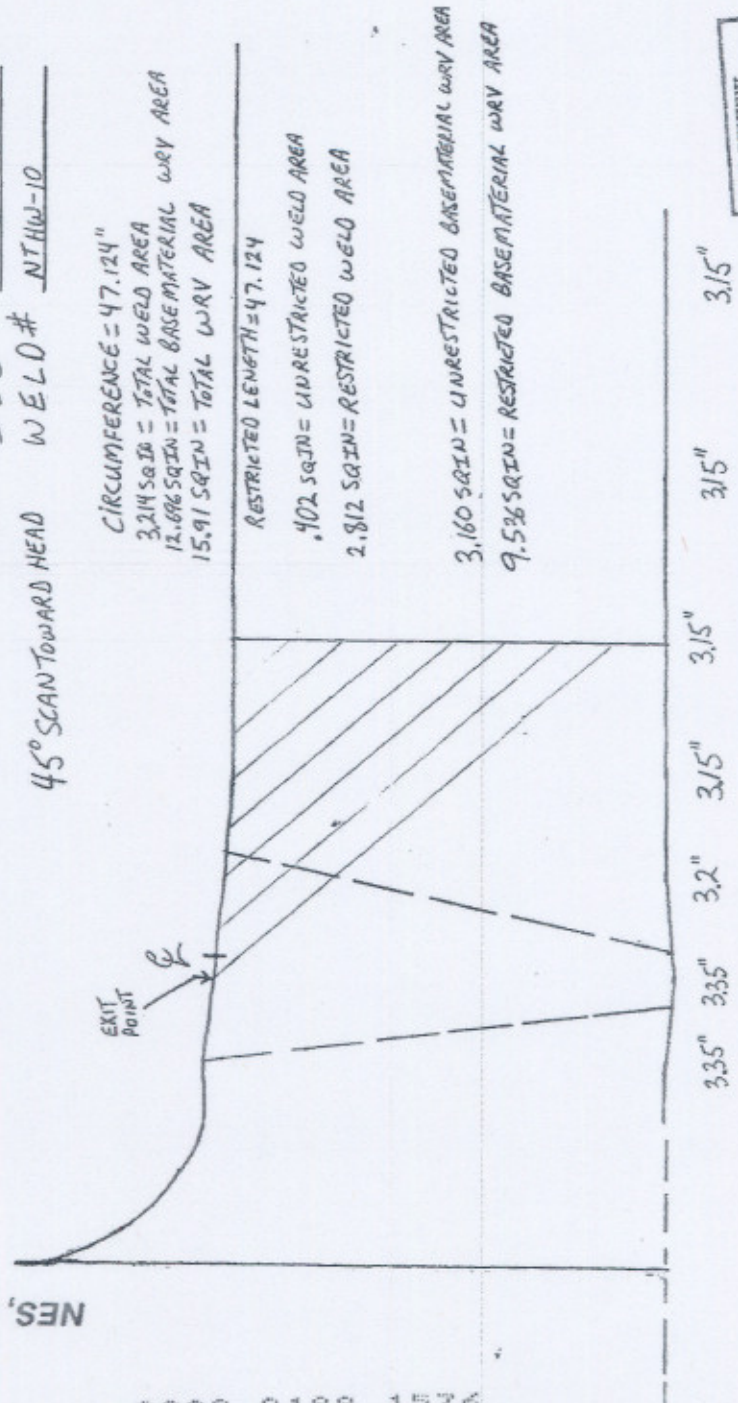

ANTI REVIEW
 ANTI SPILL
 DATE 11-25-98

EXAMINER I. Huh LEVEL II DATE 10/30/98
 EXAMINER Jeffrey Brey LEVEL II DATE 10/30/98
 REVIEWER Scott Pearson LEVEL III DATE 11-3-98

DB
 11-14-98

NES, Inc.

0099 0188 1576

Primary No.: H-02997

Sketch or Photo: Y:\Shared\Ideal\HNP_Data\Outage Scans\RO-15\UT-09-038C.JPG


DATA SHEET # 210-98-~~202~~²¹¹⁻⁹⁸
 PAGE 2 OF 15
 ISO# 1-ISS-PZR-1
 WELD# NTHW-10

CIRCUMFERENCE = 47.124"

45° SCAN TOWARD NOZZLE

NES, Inc.

0099 0100 1547

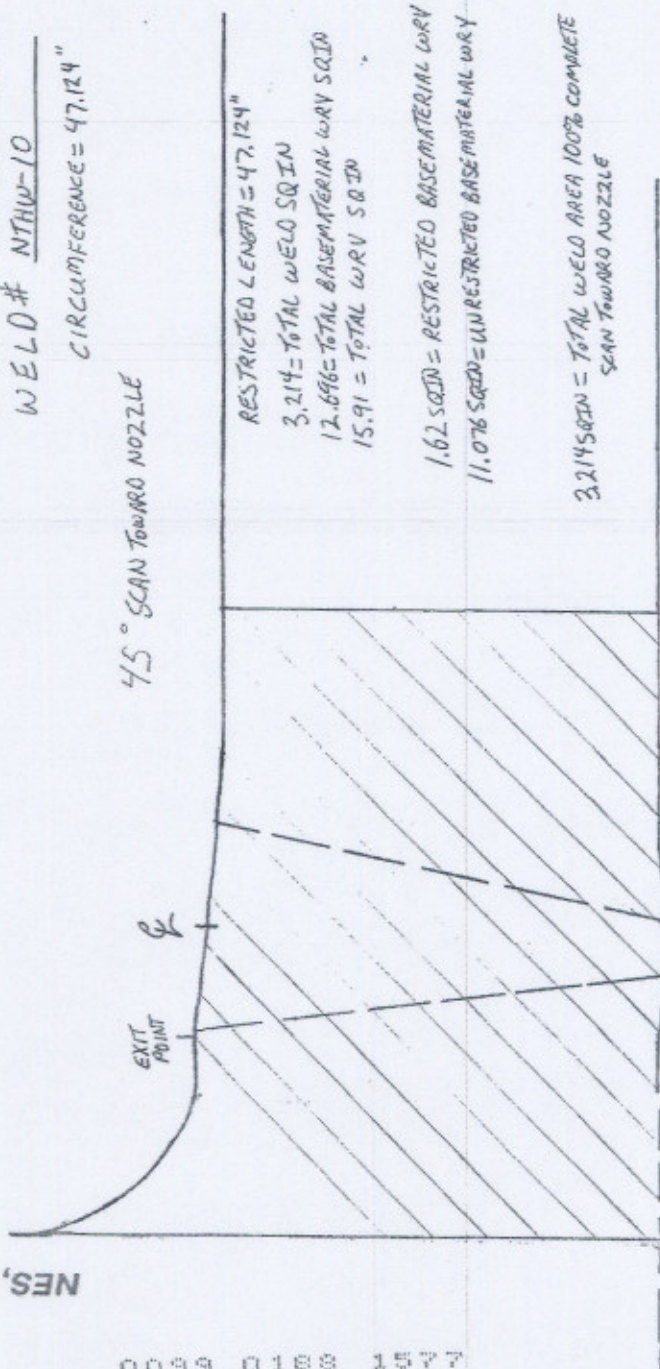

ANII REVIEW
 ANII 8/11/08
 DATE 11-25-08

EXAMINER I. Huh LEVEL II DATE 10/20/07
 EXAMINER [Signature] LEVEL II DATE 10/20/08
 REVIEWER [Signature] LEVEL III DATE 11-2-08

QCB 11-R-08

Primary No.: H-02997

Sketch or Photo: Y:\Shared\Ideal\HNP_Data\Outage Scans\RO-15\UT-09-038D.JPG

DATA SHEET # 210-98-202
 PAGE 8 OF 15
 ISO# 1-51-P2A1
 WELD# NTHW-10

CIRCUMFERENCE = 47.124
 HEAD SIDE AREA = 6.222 SQ IN BASE MATERIAL WRV
 NOZZLE SIDE AREA = 6.474 SQ IN BASE MATERIAL WRV
 HEAD SIDE WELD AREA = 1.607 SQ IN
 NOZZLE SIDE WELD AREA = 1.607 SQ IN


RESTRICTED LENGTH = 47.124

5.297 SQ IN = RESTRICTED BASE MATERIAL WRV AREA


1.177 SQ IN = UNRESTRICTED BASE MATERIAL WRV AREA

NOZZLE SIDE WELD IS 100% COMPLETE

HEAD SIDE WELD + BASE MATERIAL WRV IS 100% COMPLETE

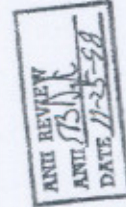

45° CIRC SCAN

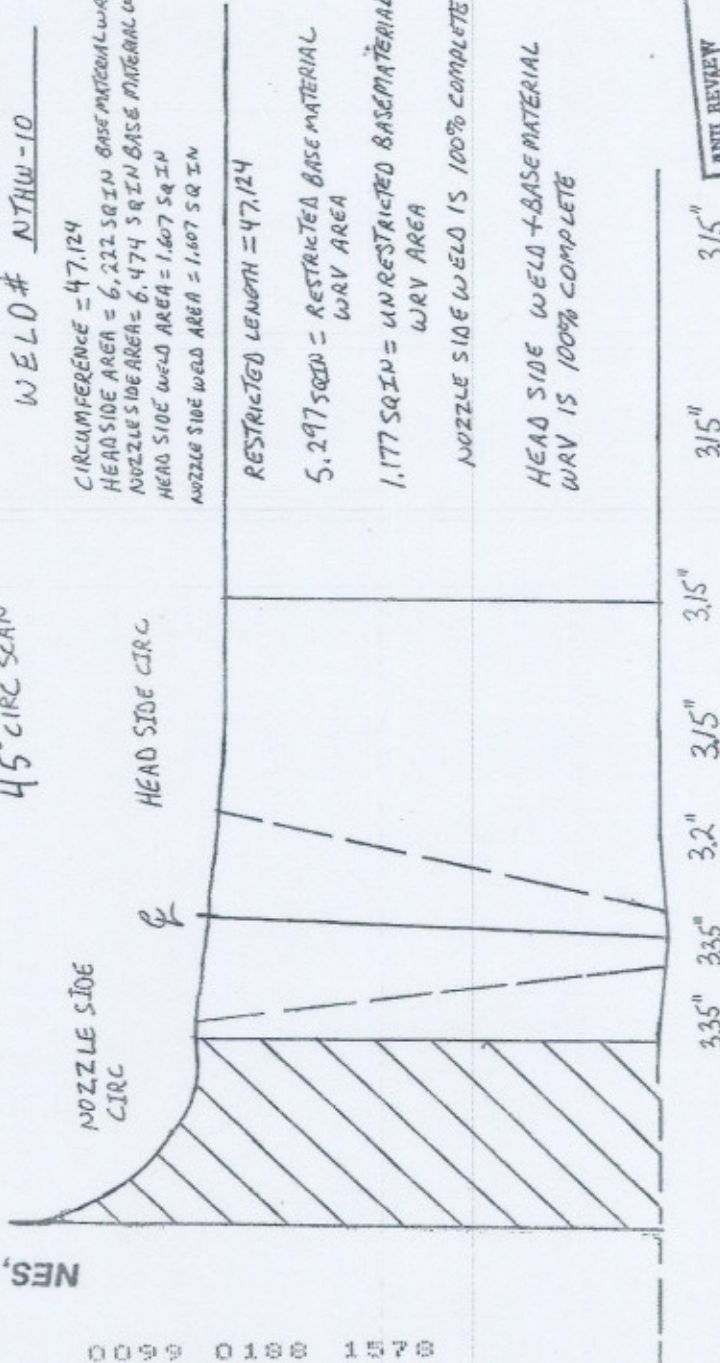

EXAMINER T. Hule LEVEL II DATE 12/30/98
 EXAMINER David Byg LEVEL I DATE 10/30/98
 REVIEWER Scott D. ... LEVEL III DATE 11-25-98

DB-ab
 11-18-98


NES, Inc.

0000 0100 1500

Primary No.: H-02997

Sketch or Photo: Y:\Shared\Ideas\HNP_Data\Outage Scans\RO-15\UT-09-038E.JPG

DATA SHEET # 210-98-102
 PAGE 12 OF 15
 ISO# 1-SSI-P2R-1
 WELD # NTHW-10

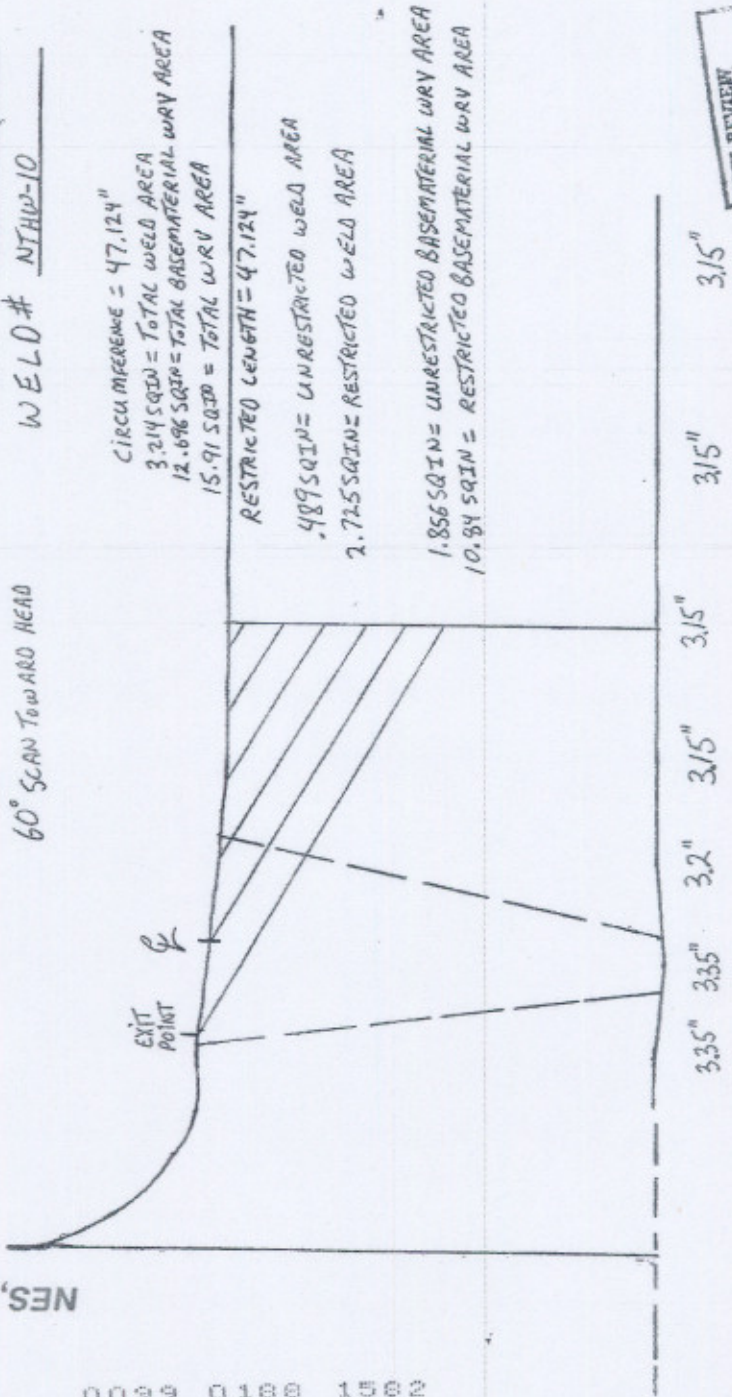

AND REVIEW
 DATE 12-5-98

EXAMINER Paul S. Bleck LEVEL II DATE 10/30/98
 EXAMINER N/A LEVEL N/A DATE N/A
 REVIEWER Scott Lane LEVEL III DATE 11-3-98

dup
 11-19-98

NES, Inc.

0000 0100 1000

Primary No.: H-02997

Sketch or Photo: Y:\Shared\Ideas\HNP_Data\Outage Scans\RO-15\UT-09-038F.JPG

DATA SHEET # 210-98-02
 PAGE 13 OF 15
 ISO# F-155I-P2R-1
 WELD# NTAW-10


60° SCAN TOWARD NOZZLE

CIRCUMFERENCE = 47.124"
 3.214 = TOTAL WELD SQIN
 12.696 = TOTAL BASE MATERIAL WRV SQIN
 15.91 = TOTAL WRV SQIN

RESTRICTED LENGTH IS 47.124"

1.26 SQIN = RESTRICTED BASE MATERIAL WRV
 11.436 SQIN = UNRESTRICTED BASE MATERIAL WRV

3.214 SQIN = TOTAL WELD AREA 100% COMPLETE
 SCAN TOWARD NOZZLE

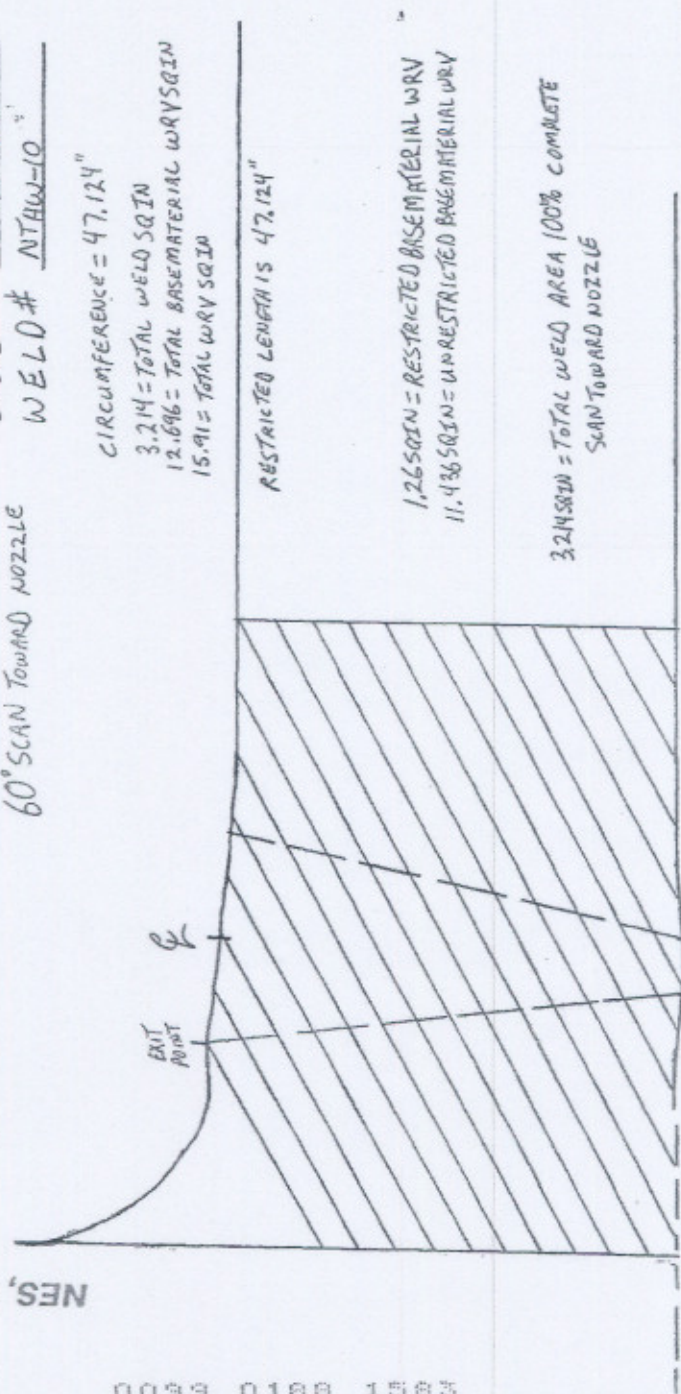

HAND REVIEWED
 AND RE-TESTED
 DATE 11-25-08

EXAMINER Paul S. Bleche LEVEL II DATE 10/30/08
 EXAMINER N/A LEVEL N/A DATE N/A
 REVIEWER Shawn LEVEL III DATE 11-2-08

DRAG

NES, Inc.

00000100010000

Primary No.: H-02997


Sketch or Photo: Y:\Shared\Ideal\HNP_Data\Outage Scans\RO-15\UT-09-038G.JPG

DATA SHEET # 210-98-02
 PAGE 14 OF 15
 ISO# 1-SSI-P2A-1
 WELD# NTHW-10

CIRCUMFERENCE = 47.124"
 HEAD SIDE AREA = 6.222 SQ IN BASE MATERIAL WRV
 NOZZLE SIDE AREA = 6.474 SQ IN BASE MATERIAL WRV
 HEAD SIDE WELD AREA = 1.607 SQ IN
 NOZZLE SIDE WELD AREA = 1.607 SQ IN

RESTRICTED LENGTH = 47.124"
 5.297 SQ IN = RESTRICTED BASE MATERIAL WRV AREA
 1.177 SQ IN = UNRESTRICTED BASE MATERIAL WRV AREA
 NOZZLE SIDE WELD IS 100% COMPLETE
 HEAD SIDE WELD + BASE MATERIAL WRV IS 100% COMPLETE

ANTI REVIEW
 ANTI P.S.I.
 DATE 1-25-98

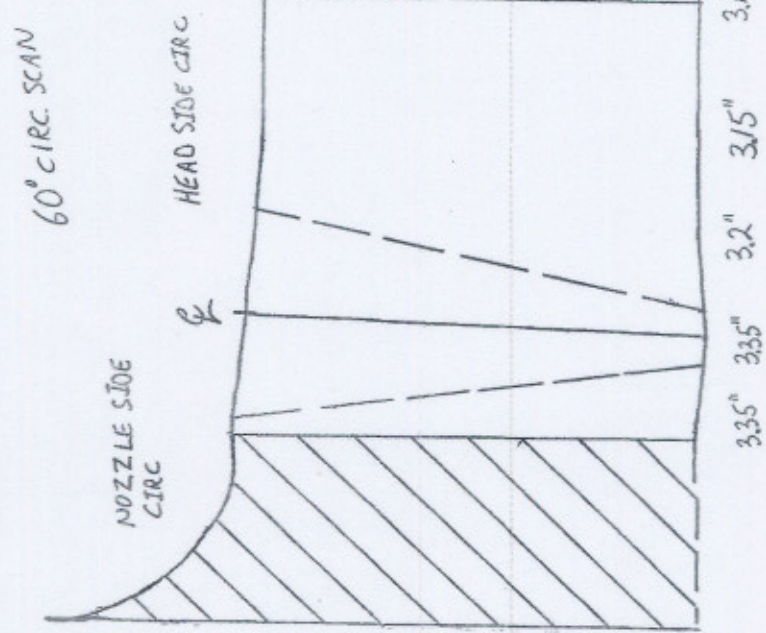

EXAMINER Paul S. Bleche LEVEL II DATE 10/30/97
 EXAMINER N/A LEVEL N/A DATE N/A
 REVIEWER [Signature] LEVEL III DATE 11-2-98

Dr. B. AB
 11-14-98

NES, Inc.

0099 0100 1504

COVERAGE CALCULATION SHEET

P 3 of 15
ISO 1-ISI-PUR-1
DATA SHEET# 210-98-02

WELD NO.:NTHW-10							0 DEGREE ONLY						
	TOTAL WELD LENGTH (INCHES)	WELD LENGTH EXAMINED RESTRICTED (INCHES)	LENGTH EXAMINED RESTRICTED %	WELD LENGTH EXAMINED UNRESTRICTED (INCHES)	WELD LENGTH EXAMINED UNRESTRICTED %	CROSS SECTION AREA (SQ. INCHES)	RESTRICTED CROSS SECTION AREA EXAMINED (SQ. INCHES)	TOTAL CROSS SECTION RESTRICTED COVERAGE %	UNRESTRICTED CROSS SECTION AREA EXAMINED (SQ. INCHES)	TOTAL CROSS SECTION UNRESTRICTED COVERAGE %	TOTAL RESTRICTED COVERAGE (LENGTH X CROSS SECTION) %	TOTAL UNRESTRICTED COVERAGE (LENGTH X CROSS SECTION) %	TOTAL COVERAGE (RESTRICTED + UNRESTRICTED) %
HEAD SIDE BASE MATERIAL AXIAL COVERAGE	47.12	47.12	100.00%	0	0.00%	15.91	10.55	66.31%	0	0.00%	66.31%	0.00%	66.31%

Adrian Black, CPL III, 11-19-98

ANII REVIEW
ANII *SB Dyer*
DATE *11-25-98*

COVERAGE CALCULATION SHEET

P9 of 15

ISO # 1-ISI-PZR-1

DATA SHEET # 210-98-02

WELD NO.:NTHW-10	45 DEGREE												
	TOTAL WELD LENGTH (INCHES)	WELD LENGTH EXAMINED RESTRICTED (INCHES)	LENGTH EXAMINED RESTRICTED %	WELD LENGTH EXAMINED UNRESTRICTED (INCHES)	WELD LENGTH EXAMINED UNRESTRICTED %	CROSS SECTION AREA (SQ. INCHES)	RESTRICTED CROSS SECTION AREA EXAMINED (SQ. INCHES)	TOTAL CROSS SECTION RESTRICTED COVERAGE %	UNRESTRICTED CROSS SECTION AREA EXAMINED (SQ. INCHES)	TOTAL CROSS SECTION UNRESTRICTED COVERAGE %	TOTAL RESTRICTED COVERAGE (LENGTH X CROSS SECTION) %	TOTAL UNRESTRICTED COVERAGE (LENGTH X CROSS SECTION) %	TOTAL COVERAGE (RESTRICTED + UNRESTRICTED) %
TOWARD HEAD BASE MATERIAL AXIAL COVERAGE	47.12	47.12	100.00%	0	0.00%	12.696	3.16	24.89%	0	0.00%	24.89%	0.00%	24.89%
TOWARD HEAD WELD AXIAL COVERAGE	47.12	47.12	100.00%	0	0.00%	3.214	0.402	12.51%	0	0.00%	12.51%	0.00%	12.51%
TOWARD NOZZLE BASE MATERIAL AXIAL COVERAGE	47.12	47.12	100.00%	0	0.00%	12.696	11.076	87.24%	0	0.00%	87.24%	0.00%	87.24%
TOWARD NOZZLE WELD AXIAL COVERAGE	47.12	0	0.00%	47.12	100.00%	3.214	0	0.00%	3.214	100.00%	0.00%	100.00%	100.00%
HEAD SIDE CIRC COVERAGE WELD	47.12	0	0.00%	47.12	100.00%	1.607	0	0.00%	1.607	100.00%	0.00%	100.00%	100.00%
HEAD SIDE CIRC COVERAGE BASE MATERIAL	47.12	0	0.00%	47.12	100.00%	6.222	0	0.00%	6.222	100.00%	0.00%	100.00%	100.00%
NOZZLE SIDE CIRC COVERAGE WELD	47.12	0	0.00%	47.12	100.00%	1.607	0	0.00%	1.607	100.00%	0.00%	100.00%	100.00%
NOZZ SIDE CIRC COVERAGE BASE MATERIAL	47.12	47.12	100.00%	0	0.00%	6.474	1.177	18.18%	0	0.00%	18.18%	0.00%	18.18%
TOTAL WELD VOLUME COVERAGE													67.85%

Checked by Black CPL III, 11-19-98

ANII REVIEW
 ANII B. W. G.
 11-19-98

COVERAGE CALCULATION SHEET

P15 of 15
ISO# 1-ISI-PZR-1
DATA SHEET# 210-98-02

WELD NO.:NTHW-10	60 DEGREE												
	TOTAL WELD LENGTH (INCHES)	WELD LENGTH EXAMINED RESTRICTED (INCHES)	LENGTH EXAMINED RESTRICTED %	WELD LENGTH EXAMINED UNRESTRICTED (INCHES)	WELD LENGTH EXAMINED UNRESTRICTED %	CROSS SECTION AREA (SQ. INCHES)	RESTRICTED CROSS SECTION AREA EXAMINED (SQ. INCHES)	TOTAL CROSS SECTION RESTRICTED COVERAGE %	UNRESTRICTED CROSS SECTION AREA EXAMINED (SQ. INCHES)	TOTAL CROSS SECTION UNRESTRICTED COVERAGE %	TOTAL RESTRICTED COVERAGE (LENGTH X CROSS SECTION) %	TOTAL UNRESTRICTED COVERAGE (LENGTH X CROSS SECTION) %	TOTAL COVERAGE (RESTRICTED + UNRESTRICTED) %
TOWARD HEAD BASE MATERIAL AXIAL COVERAGE	47.12	47.12	100.00%	0	0.00%	12.696	1.856	14.62%	0	0.00%	14.62%	0.00%	14.62%
TOWARD HEAD WELD AXIAL COVERAGE	47.12	47.12	100.00%	0	0.00%	3.214	0.489	15.21%	0	0.00%	15.21%	0.00%	15.21%
TOWARD NOZZLE BASE MATERIAL AXIAL COVERAGE	47.12	47.12	100.00%	0	0.00%	12.696	11.436	90.08%	0	0.00%	90.08%	0.00%	90.08%
TOWARD NOZZLE WELD AXIAL COVERAGE	47.12	0	0.00%	47.12	100.00%	3.214	0	0.00%	3.214	100.00%	0.00%	100.00%	100.00%
HEAD SIDE CIRC COVERAGE WELD	47.12	0	0.00%	47.12	100.00%	1.607	0	0.00%	1.607	100.00%	0.00%	100.00%	100.00%
HEAD SIDE CIRC COVERAGE BASEMATERIAL	47.12	0	0.00%	47.12	100.00%	6.222	0	0.00%	6.222	100.00%	0.00%	100.00%	100.00%
NOZZLE SIDE CIRC COVERAGE WELD	47.12	0	0.00%	47.12	100.00%	1.607	0	0.00%	1.607	100.00%	0.00%	100.00%	100.00%
NOZZLE SIDE CIRC COVERAGE BASEMATERIAL	47.12	47.12	100.00%	0	0.00%	6.474	1.177	18.18%	0	0.00%	18.18%	0.00%	18.18%
TOTAL WELD VOLUME COVERAGE													67.26%

Edwin Black, CPL III, 11-19-98

REVIEW



UT Calibration Examination

Site/Unit: HNP / 1
 Summary No.: H-02998
 Workscope: ISI

Procedure: NDEP-0450
 Procedure Rev.: 3 TR-A
 Work Order No.: 1313525

Outage No.: RFO-15
 Report No.: UT-09-039
 Page: 1 of 13

Code: 2001 Ed 2003 Add Cat./Item: B-D/B3.110 Location: CTMT 302'
 Drawing No.: 1-ISI-PZR-1 Description: Nozzle to Head
 System ID: RC-2050
 Component ID: II-PZR-01NTHW-11 Size/Length: 3.15" / 47.1" Thickness/Diameter: 3.35" / 15.0"
 Limitations: NOZZLE TO HEAD CONFIGURATION Start Time: 1400 Finish Time: 1545

Instrument Settings
 Serial No.: 0134D2
 Manufacturer: Krautkramer Branson
 Model: USN-58L
 Delay: 1.3306 Range: 5.0"
 M'tl Cal/Vel: 0.2358 Pulsar: SINGLE
 Damping: 1KΩ Reject: 0%
 Rep. Rate: HIGH Freq.: 2.25 MHZ
 Filter: N/A Mode: LOGITUDINAL
 Voltage: N/A Other: FULLWAVE
 Ax. Gain (dB): 29 Circ. Gain (dB): 29
10 Screen Div. = 5 in. of Sound Path
 Linearity Report No.: L-09-001

Search Unit
 Serial No.: C29344
 Manufacturer: KB AeroTech
 Size: 0.75 Shape: Rect. Round
 Freq.: 2.25 MHz Style: Gamma
 Exam Angle: 0° # of Elements: 1
 Mode: Longitudinal
 Measured Angle: N/A
 Wedge Style: N/A

Search Unit Cable
 Type: RG-58 A/U
 Length: 6' No. Conn.: 0

Cal. Checks	Time	Date
Initial Cal.	1030	4/25/2009
Inter. Cal.	1400	4/25/2009
Inter. Cal.	1545	4/25/2009
Inter. Cal.		
Final Cal.	1730	4/25/2009

Couplant
 Cal. Batch: 05225
 Type: Ultragel II
 Mfg.: Sonotech, Inc.
 Exam Batch: 05225
 Type: Ultragel II
 Mfg.: Sonotech, Inc.

Reference Block
 Serial No.: 792221
 Type: CS Rompas

Axial Orientated Search Unit			
Calibration Reflector	Signal Amplitude %	Sweep Division	Sound Path
1/4 T	66	1.6	0.790
1/2 T	82	3.2	1.670
3/4 T	58	5.1	2.554
ID	>100%	7.2	3.562

Circumferential Orientated Search Unit			
Calibration Reflector	Signal Amplitude %	Sweep Division	Sound Path
N/A	N/A	N/A	N/A

Reference/Simulator Block				
Gain dB	Reflector	Signal Amplitude %	Sweep Division	Sound Path
29	SDH	52	0.7	0.727

Calibration Block
 Cal. Block No.: UT-050-1
 Thickness: 3.50 Dia.: FLAT
 Cal. Blk. Temp.: 78° Temp. Tool: 68951
 Comp. Temp.: 88° Temp. Tool: 68951
 Upstream Downstream Scan dB: 41
 CW CCW Scan dB: N/A
 Exam Surface: OD
 Surface Condition: GROUND SMOOTH

Recordable Indication(s): Yes No (If Yes, Ref. Attached Ultrasonic Indication Report.)
 Results: Sat Unsat Eval
 Percent Of Coverage Obtained > 90%: *67.14% Reviewed Previous Data: Yes

Comments: ***Verified previously recorded limitations and coverage calculations from report #210-98-03 (See Extracted Pages Attached). Examination was in a Radiation area.**

Examiner	Level	Signature	Date	Reviewer	Signature	Date
Malia, Mark E.	II-PDI	<i>Mark E. Malia</i>	4/25/2009	Damon Priestley PGN Lv III	<i>Damon Priestley</i>	4/29/2009
Examiner	Level	Signature	Date	Site Review	Signature	Date
N/A	N/A			Scott Larson Level III	<i>Scott Larson</i>	4/29/2009
Other	Level	Signature	Date	ANII Review	Signature	Date
Dugan, Michael P	III-PDI	<i>Michael P. Dugan</i>	4/29/2009	Nancy Ritchie-Slaughter	<i>Nancy C. Ritchie-Slaughter</i>	5/5/09



UT Calibration Examination

Site/Unit: HNP / 1
 Summary No.: H-02998
 Workscope: ISI

Procedure: NDEP-0450
 Procedure Rev.: 3 TR-A
 Work Order No.: 1313525

Outage No.: RFO-15
 Report No.: UT-09-039
 Page: 2 of 13

Code: 2001 Ed 2003 Add Cat./Item: B-D/B3.110 Location: CTMT 302'
 Drawing No.: 1-ISI-PZR-1 Description: Nozzle to Head
 System ID: RC-2050
 Component ID: II-PZR-01NTHW-11 Size/Length: 3.15" / 47.1" Thickness/Diameter: 3.35" / 15.0"
 Limitations: NOZZLE TO HEAD CONFIGURATION Start Time: 1400 Finish Time: 1545

Instrument Settings
 Serial No.: 0134D2
 Manufacturer: Krautkramer Branson
 Model: USN-58L
 Delay: 12.1922 Range: 10
 M'tl Cal/Vel: 0.1270 Pulser: SINGLE
 Damping: 1KQ Reject: 0%
 Rep. Rate: HIGH Freq.: 2.25 MHZ
 Filter: N/A Mode: SHEARWAVE
 Voltage: N/A Other: FULLWAVE
 Ax. Gain (dB): 42/56 Circ. Gain (dB): 42/56
10 Screen Div. = 10 in. of Sound Path
 Linearity Report No.: L-09-001

Search Unit
 Serial No.: C18133
 Manufacturer: KB AeroTech
 Size: .5" x 1" Shape: Rect.
 Freq.: 2.25 MHZ Style: Gamma
 Exam Angle: 45° # of Elements: 1
 Mode: SHEARWAVE
 Measured Angle: 45°
 Wedge Style: SWS
Search Unit Cable
 Type: RG-58 A/U
 Length: 6' No. Conn.: 0

Cal. Checks	Time	Date
Initial Cal.	1035	4/25/2009
Inter. Cal.	1415	4/25/2009
Inter. Cal.	1600	4/25/2009
Inter. Cal.		
Final Cal.	1730	4/25/2009

Couplant
 Cal. Batch: 05225
 Type: Ultragel II
 Mfg.: Sonotech, Inc.
 Exam Batch: 05225
 Type: Ultragel II
 Mfg.: Sonotech, Inc.

Reference Block
 Serial No.: 792221
 Type: CS Rompas

Axial Orientated Search Unit			
Calibration Reflector	Signal Amplitude %	Sweep Division	Sound Path
1/4 T	85	1.2	1.159
1/2 T	62	2.4	2.383
3/4 T	40	3.6	3.649
ID NOTCH	13	5.2	5.146
5/4 T	10	6.1	6.00

Circumferential Orientated Search Unit			
Calibration Reflector	Signal Amplitude %	Sweep Division	Sound Path

Reference/Simulator Block				
Gain dB	Reflector	Signal Amplitude %	Sweep Division	Sound Path
42	SDH	45	1.0	1.024

Calibration Block
 Cal. Block No.: UT-050-1
 Thickness: 3.50 Dia.: FLAT
 Cal. Blk. Temp.: 78° Temp. Tool: 68951
 Comp. Temp.: 88 Temp. Tool: 68951
 Exam Surface: OD
 Surface Condition: GROUND SMOOTH

Scan Coverage
 Upstream Downstream Scan dB: 62
 CW CCW Scan dB: 62
 Exam Surface: OD
 Surface Condition: GROUND SMOOTH

Recordable Indication(s): Yes No (If Yes, Ref. Attached Ultrasonic Indication Report.)
 Results: Sat Unsat Eval
 Percent Of Coverage Obtained > 90%: 67.14% Reviewed Previous Data: Yes

Comments: VERIFIED PREVIOUSLY RECORDED LIMITATIONS. SEE REPORT #210-98-03 FOR COVERAGE CALCULATION.
dB difference for 3/4 T to 5/4 T = 14dB

Examiner	Level	Signature	Date	Reviewer	Signature	Date
Malia, Mark E.	II-PDI	<i>Mark E Malia</i>	4/25/2009	Damon Priestley PGN Lv III	<i>Damon Priestley</i>	4/29/2009
N/A	N/A			Scott Larson Level III	<i>Scott Larson</i>	4/29/2009
Dugan, Michael P	III-PDI	<i>Michael P Dugan</i>	4/29/2009	Nancy Ritchie-Slaughter	<i>Nancy C Ritchie Slaughter</i>	5/5/09



UT Calibration Examination

Site/Unit: HNP / 1
 Summary No.: H-02998
 Workscope: ISI

Procedure: NDEP-0450
 Procedure Rev.: 3 TR-A
 Work Order No.: 1313525

Outage No.: RFO-15
 Report No.: UT-09-039
 Page: 3 of 13

Code: 2001 Ed 2003 Add Cat./Item: B-D/B3.110 Location: CTMT 302'
 Drawing No.: 1-ISI-PZR-1 Description: Nozzle to Head
 System ID: RC-2050
 Component ID: II-PZR-01NTHW-11 Size/Length: 3.15" / 47.1" Thickness/Diameter: 3.35" / 15.0"
 Limitations: NOZZLE TO HEAD CONFIGURATION Start Time: 1400 Finish Time: 1545

Instrument Settings
 Serial No.: 0134D2
 Manufacturer: Krautkramer Branson
 Model: USN-58L
 Delay: 15.2428 Range: 10"
 M'tl Cal/Vel: 0.1270 Pulser: SINGLE
 Damping: 1KΩ Reject: 0%
 Rep. Rate: HIGH Freq.: 2.25 MHZ
 Filter: N/A Mode: SHEARWAVE
 Voltage: N/A Other: FULLWAVE
 Ax. Gain (dB): 49/63* Circ. Gain (dB): 49/63*
10 Screen Div. = 10 in. of Sound Path
 Linearity Report No.: L-09-001

Search Unit
 Serial No.: C18130
 Manufacturer: KBA
 Size: .50"x1.0" Shape: Rect.
 Freq.: 2.25 MHZ Style: GAMMA
 Exam Angle: 60° # of Elements: 1
 Mode: SHEARWAVE
 Measured Angle: 61°
 Wedge Style: SWS
Search Unit Cable
 Type: RG-58
 Length: 6' No. Conn.: 0

Cal. Checks	Time	Date
Initial Cal.	1040	4/25/2009
Inter. Cal.	1430	4/25/2009
Inter. Cal.	1615	4/25/2009
Inter. Cal.		
Final Cal.	1730	4/25/2009

Couplant
 Cal. Batch: 05225
 Type: Ultragel II
 Mfg.: Sonotech, Inc.
 Exam Batch: 05225
 Type: Ultragel II
 Mfg.: Sonotech, Inc.

Reference Block
 Serial No.: 792221
 Type: CS Rompas

Axial Orientated Search Unit			
Calibration Reflector	Signal Amplitude %	Sweep Division	Sound Path
1/4 T	83	1.8	1.823
1/2 T	49	3.6	3.598
3/4 T	31	5.4	5.38
ID NOTCH	11	7.3	7.298
5/4 T	10	9.4	9.04

Circumferential Orientated Search Unit			
Calibration Reflector	Signal Amplitude %	Sweep Division	Sound Path

Reference/Simulator Block				
Gain dB	Reflector	Signal Amplitude %	Sweep Division	Sound Path
49	SDH	21	1.6	1.557

Calibration Block
 Cal. Block No.: UT-050-1
 Thickness: 3.50 Dia.: FLAT
 Cal. Blk. Temp.: 78° Temp. Tool: 68951
 Comp. Temp.: 88° Temp. Tool: 68951
 Recordable Indication(s): Yes No (If Yes, Ref. Attached Ultrasonic Indication Report.)

Scan Coverage
 Upstream Downstream Scan dB: 69
 CW CCW Scan dB: 69
 Exam Surface: OD
 Surface Condition: GROUND SMOOTH


Results: Sat Unsat Eval
 Percent Of Coverage Obtained > 90%: 67.14% Reviewed Previous Data: Yes

Comments: *VERIFIED PREVIOUSLY RECORDED INDICATIONS. SEE REPORT # 210-98-03 FOR COVERAGE CALCULATIONS. DB difference for 3/4 T to 5/4 T = 1/4 dB.*

Examiner	Level	Signature	Date	Reviewer	Signature	Date
Malia, Mark E.	II-PDI	<i>Mark E Malia</i>	4/25/2009	Damon Priestley PGN Lv III	<i>Damon Priestley</i>	4/29/2009
N/A	N/A			Site Review Scott Larson Level III	<i>Scott Larson</i>	4/29/2009
Dugan, Michael P	III-PDI	<i>Michael P Dugan</i>	4/29/2009	ANII Review Nancy Ritchie-Slaughter	<i>Nancy Ritchie-Slaughter</i>	5/5/09


Summary No.: H-02998

Sketch or Photo: Y:\Shared\Ideall\HNP_Data\Outage Scans\RO-15\UT-09-039A.JPG

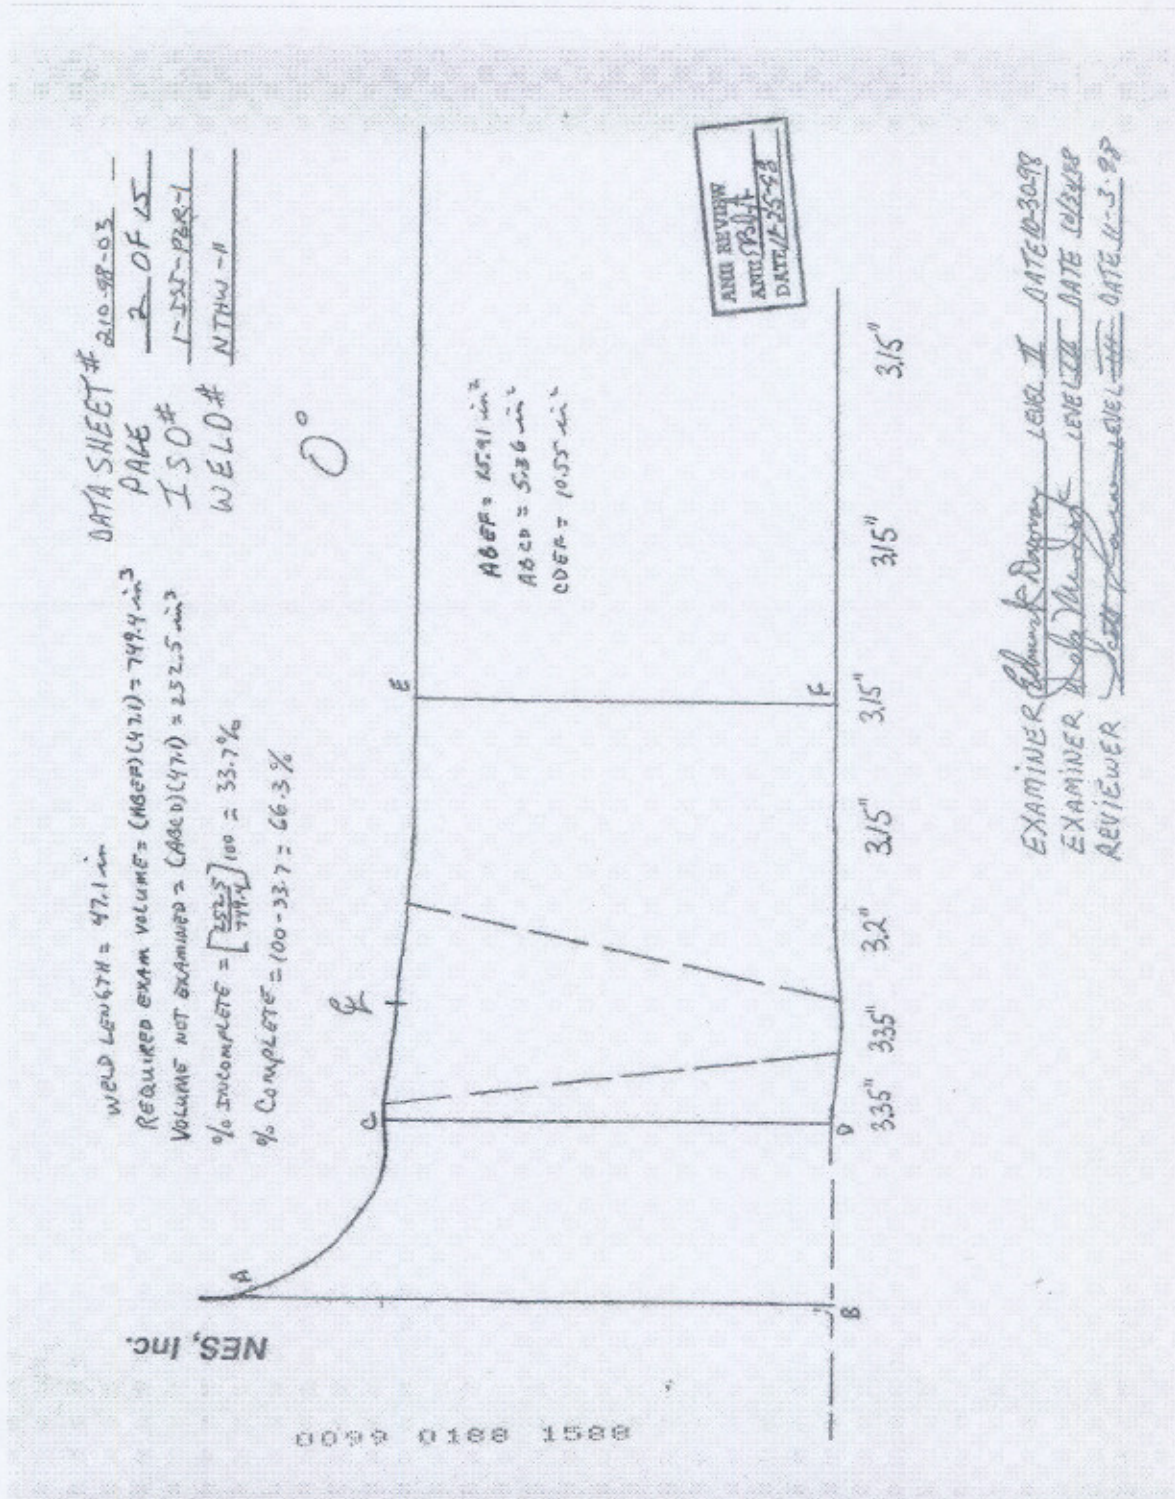


Primary No.: H-02998

Sketch or Photo: Y:\Shared\Ideal\HNP_Data\Outage Scans\RO-15\UT-09-039B.JPG

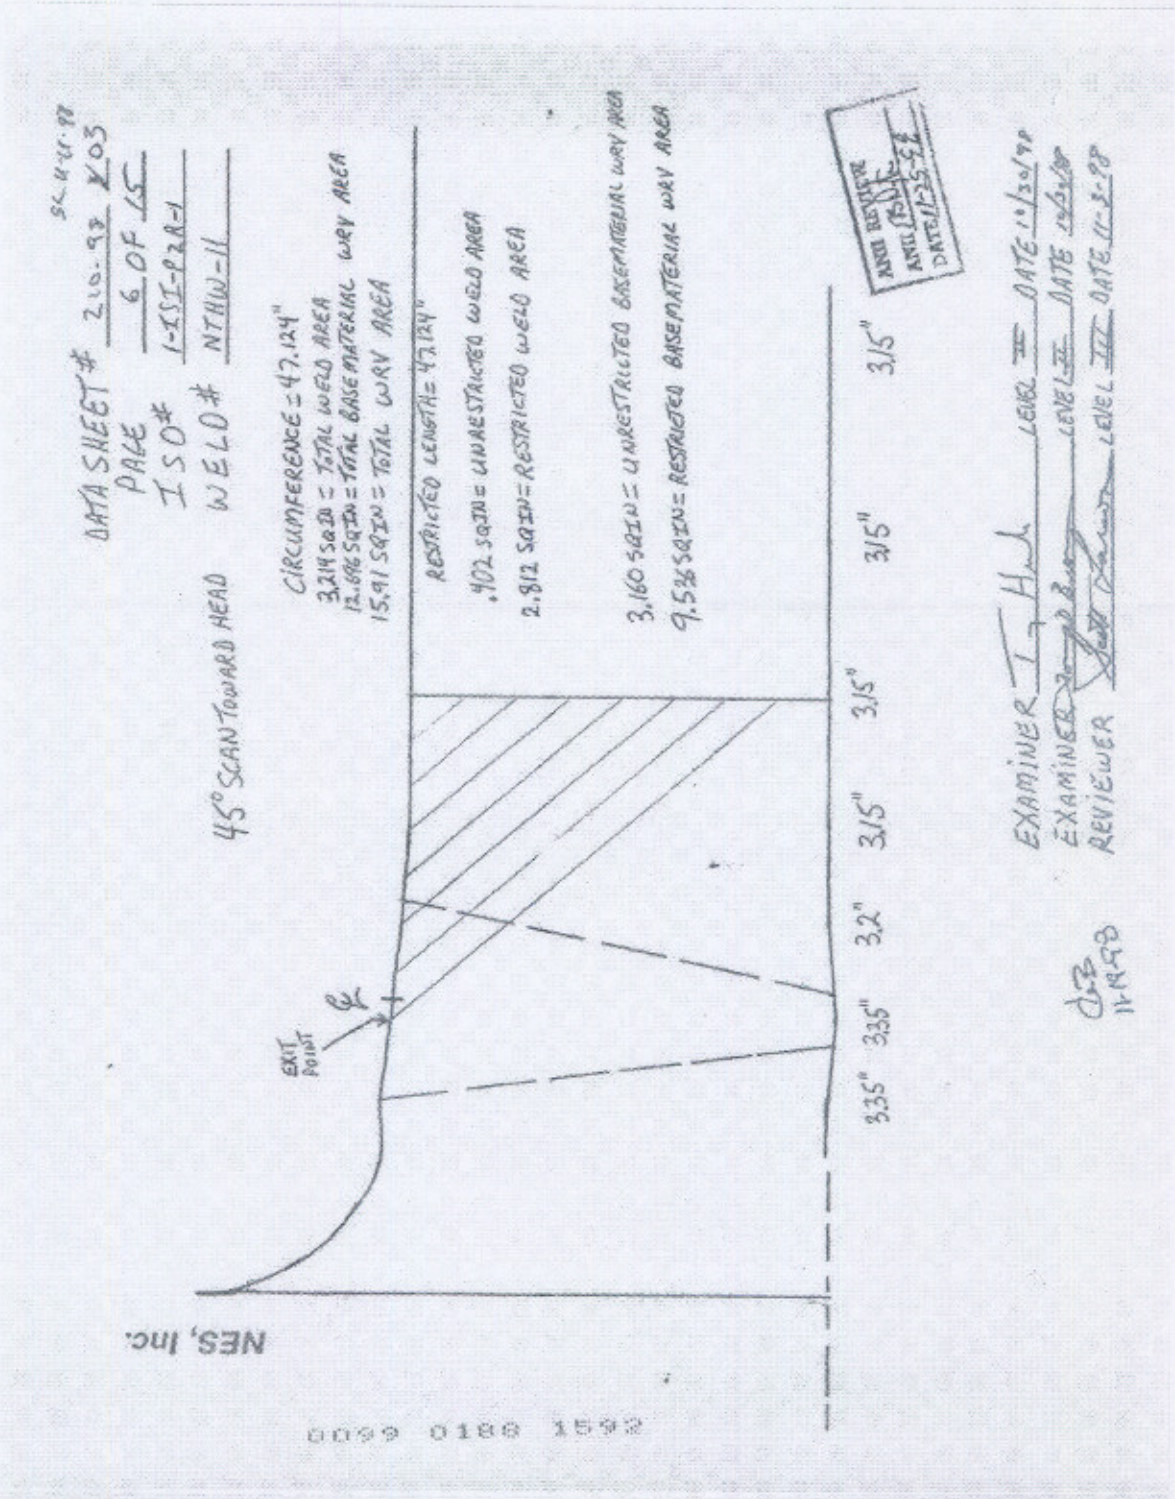


Summary No.: H-02998

Sketch or Photo: Y:\Shared\Ideal\HNP_Data\Outage Scans\RO-15\UT-09-039C.JPG

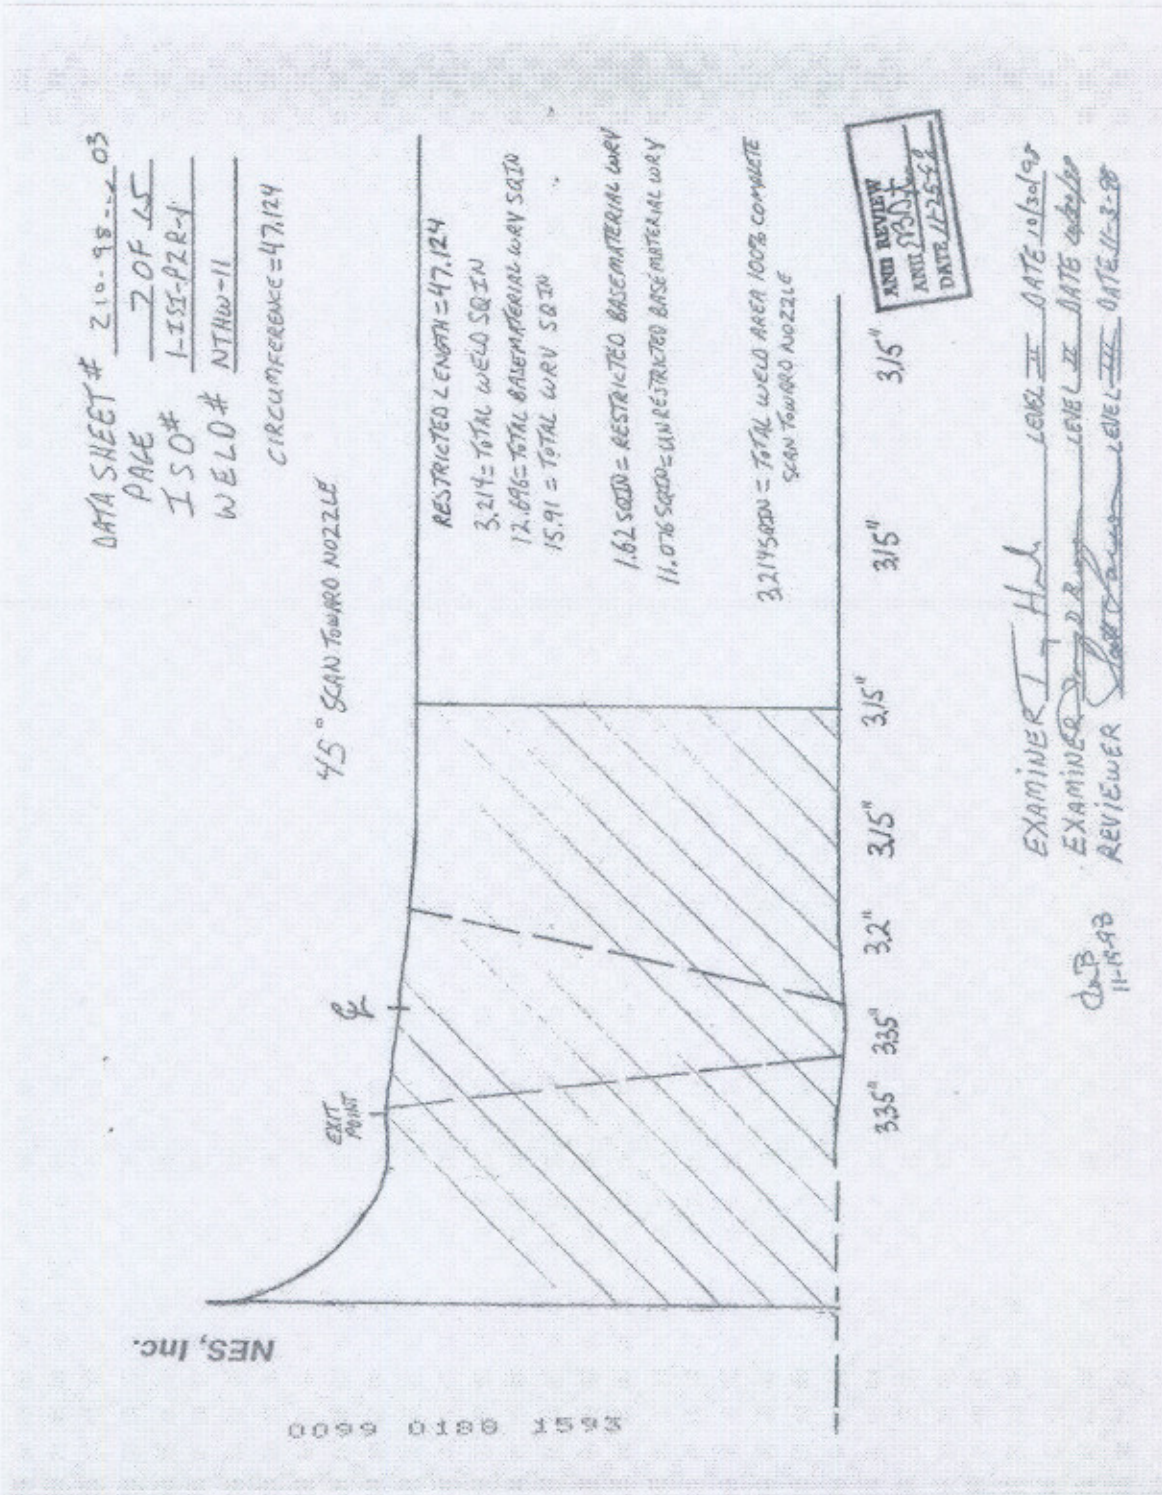


Primary No.: H-02998

Sketch or Photo: Y:\Shared\Ideas\HNP_Data\Outage Scans\RO-15\UT-09-039D.JPG

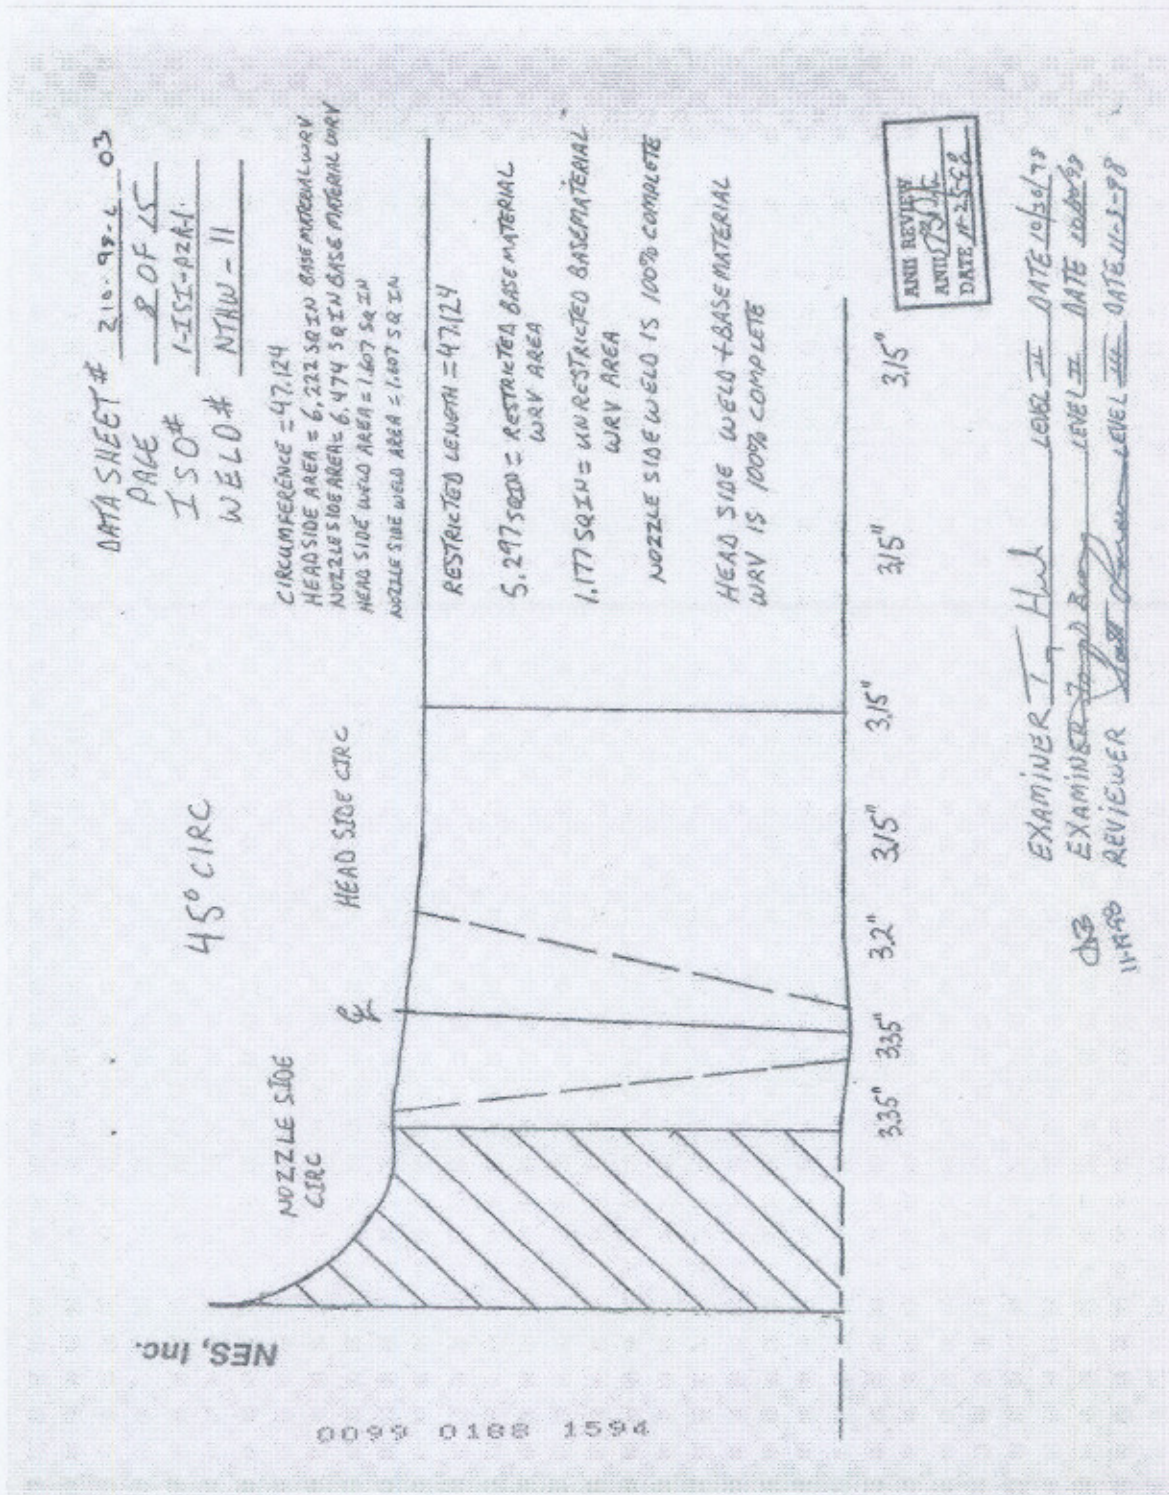


Summary No.: H-02998

Sketch or Photo: Y:\Shared\Ideal\HNP_Data\Outage Scans\RO-15\UT-09-039E.JPG

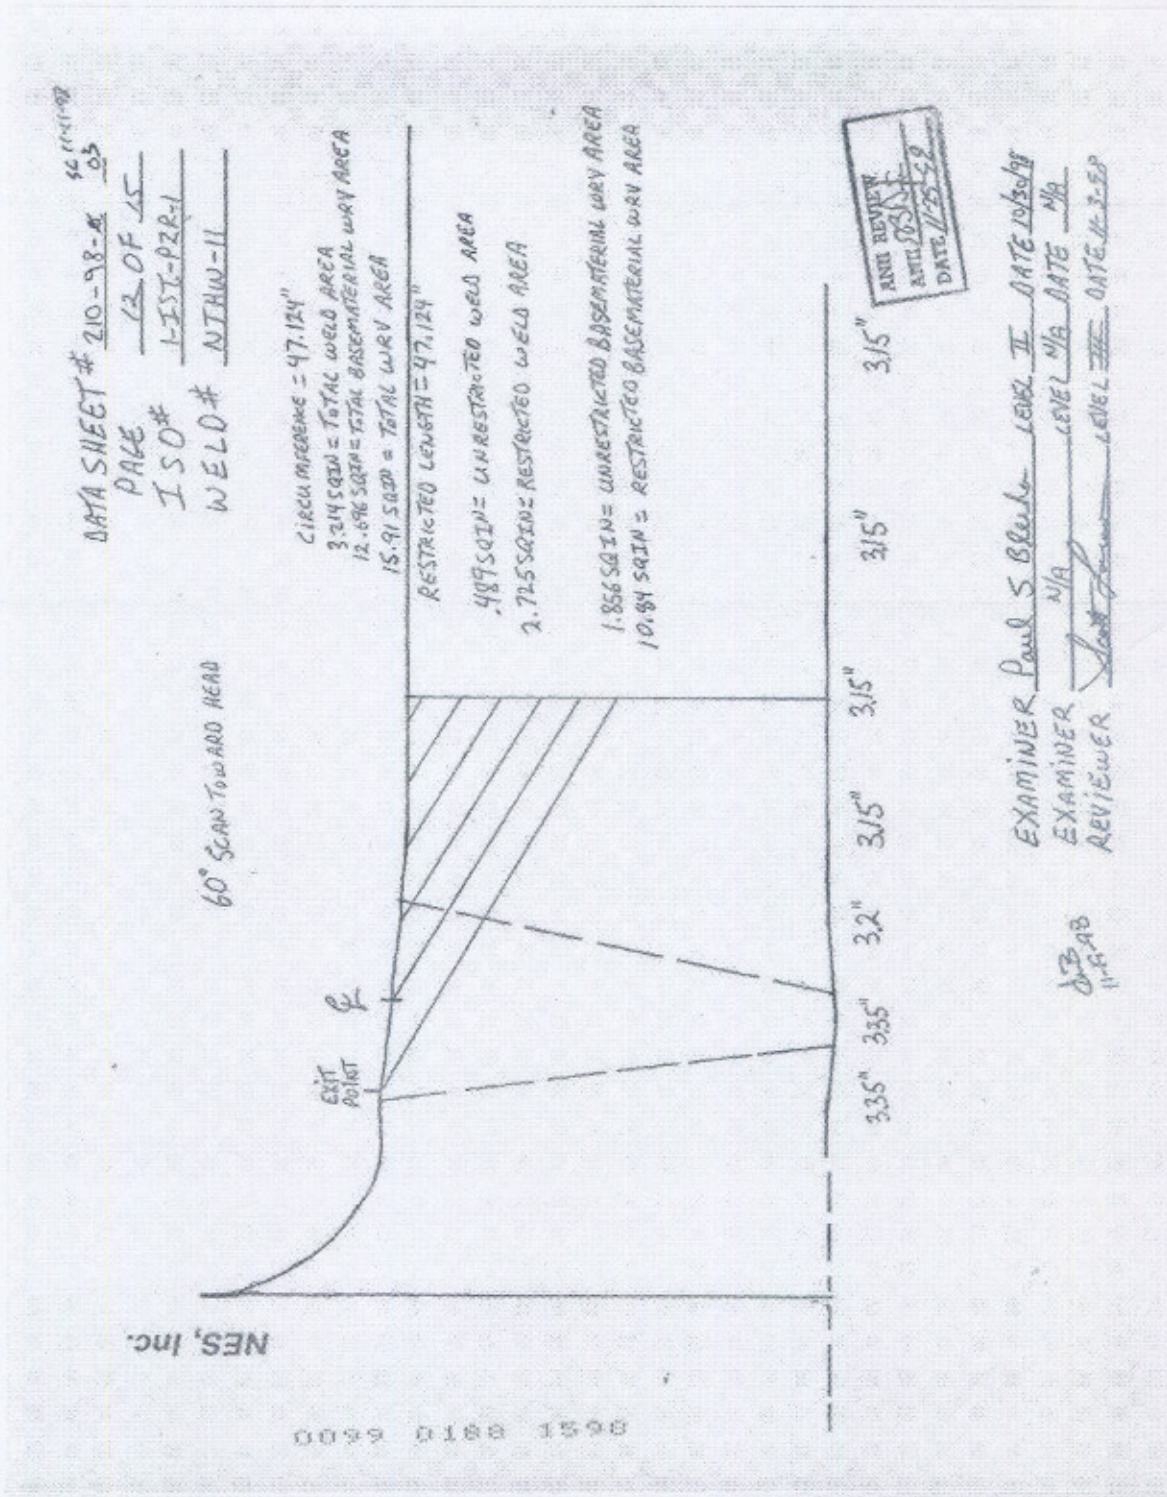


Primary No.: H-02998

Sketch or Photo: Y:\Shared\Ideas\HNP_Data\Outage Scans\RO-15\UT-09-039F.JPG

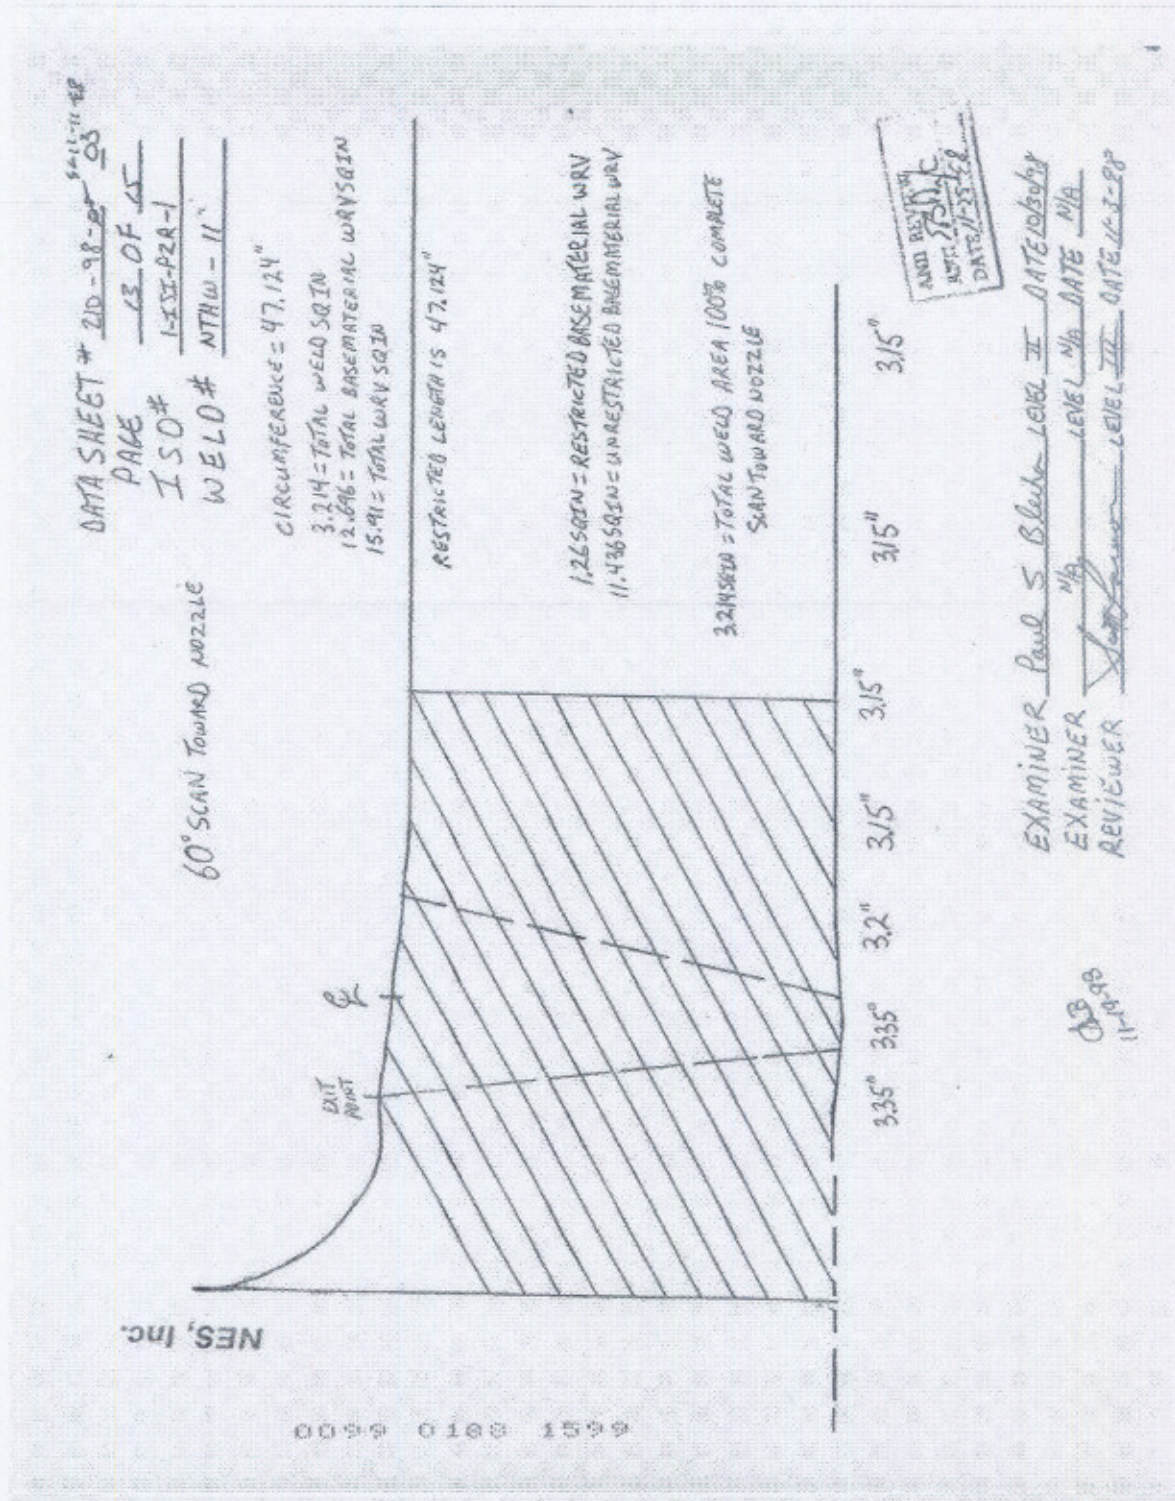

Primary No.: H-02998

Sketch or Photo: Y:\Shared\Ideal\HNP_Data\Outage Scans\RO-15\UT-09-039G.JPG

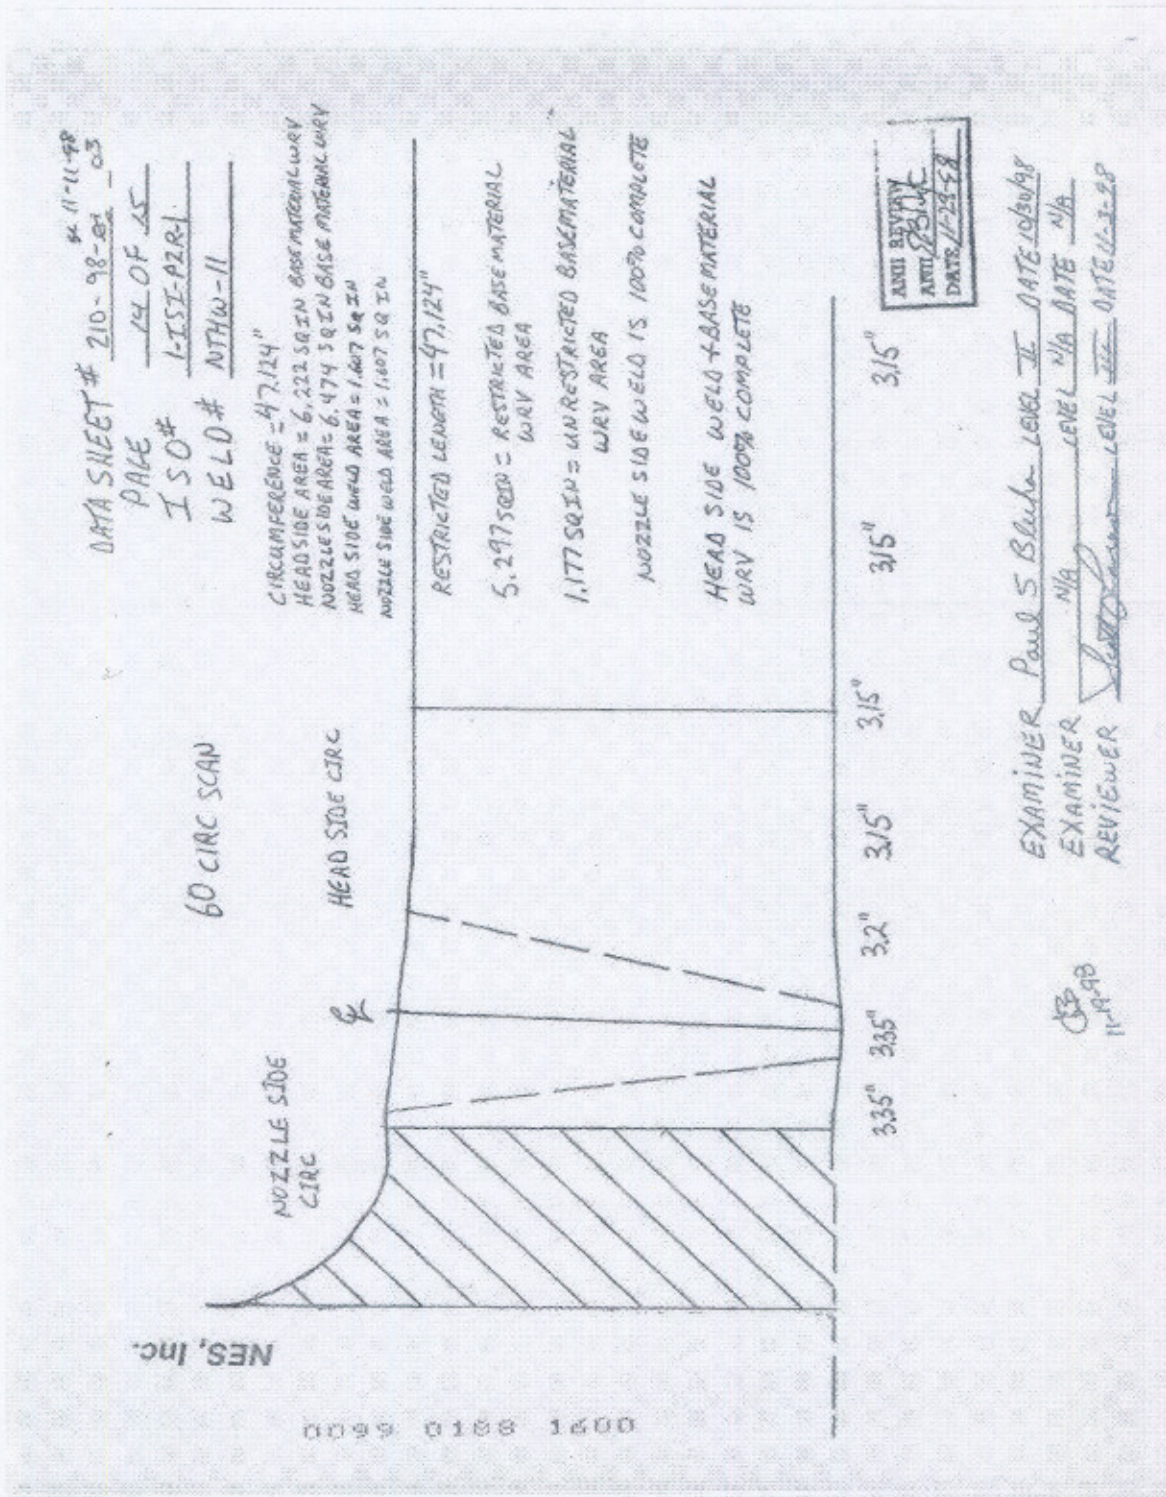

COVERAGE CALCULATION SHEET

P 9 of 15

ISO# 1-ISE-PZR-1

DATA SHT# 210-98-03

0600
0100
0200
0300
0400
0500
0600

WELD NO.:NTHW-11	45 DEGREE												
	TOTAL WELD LENGTH (INCHES)	WELD LENGTH EXAMINED RESTRICTED (INCHES)	LENGTH EXAMINED RESTRICTED %	WELD LENGTH EXAMINED UNRESTRICTED (INCHES)	WELD LENGTH EXAMINED UNRESTRICTED %	CROSS SECTION AREA (SQ. INCHES)	RESTRICTED CROSS SECTION AREA EXAMINED (SQ. INCHES)	TOTAL CROSS SECTION RESTRICTED COVERAGE %	UNRESTRICTED CROSS SECTION AREA EXAMINED (SQ. INCHES)	TOTAL CROSS SECTION UNRESTRICTED COVERAGE %	TOTAL RESTRICTED COVERAGE (LENGTH X CROSS SECTION) %	TOTAL UNRESTRICTED COVERAGE (LENGTH X CROSS SECTION) %	TOTAL COVERAGE (RESTRICTED + UNRESTRICTED) %
TOWARD HEAD BASE MATERIAL AXIAL COVERAGE	47.12	47.12	100.00%	0	0.00%	12.696	3.16	24.89%	0	0.00%	24.89%	0.00%	24.89%
TOWARD HEAD WELD AXIAL COVERAGE	47.12	47.12	100.00%	0	0.00%	3.214	0.402	12.51%	0	0.00%	12.51%	0.00%	12.51%
TOWARD NOZZLE BASE MATERIAL AXIAL COVERAGE	47.12	47.12	100.00%	0	0.00%	12.696	11.076	87.24%	0	0.00%	87.24%	0.00%	87.24%
TOWARD NOZZLE WELD AXIAL COVERAGE	47.12	0	0.00%	47.12	100.00%	3.214	0	0.00%	3.214	100.00%	0.00%	100.00%	100.00%
HEAD SIDE CIRC COVERAGE WELD	47.12	0	0.00%	47.12	100.00%	1.607	0	0.00%	1.607	100.00%	0.00%	100.00%	100.00%
HEAD SIDE CIRC COVERAGE BASEMATERIAL	47.12	0	0.00%	47.12	100.00%	6.222	0	0.00%	6.222	100.00%	0.00%	100.00%	100.00%
NOZZLE SIDE CIRC COVERAGE WELD	47.12	0	0.00%	47.12	100.00%	1.607	0	0.00%	1.607	100.00%	0.00%	100.00%	100.00%
NOZZ SIDE CIRC COVERAGE BASEMATERIAL	47.12	47.12	100.00%	0	0.00%	6.474	1.177	18.18%	0	0.00%	18.18%	0.00%	18.18%
TOTAL WELD VOLUME COVERAGE													67.85%

Adwin Black, CPL VII, 11-19-98

ANII REVIEW

COVERAGE CALCULATION SHEET

P15 of 15
ISO# 1-ISI-PZR-1
DATA SHT# 210-98-03

WELD NO.: NTHW-11	60 DEGREE												
	TOTAL WELD LENGTH (INCHES)	WELD LENGTH EXAMINED RESTRICTED (INCHES)	LENGTH EXAMINED RESTRICTED %	WELD LENGTH EXAMINED UNRESTRICTED (INCHES)	WELD LENGTH EXAMINED UNRESTRICTED %	CROSS SECTION AREA (SQ. INCHES)	RESTRICTED CROSS SECTION AREA EXAMINED (SQ. INCHES)	TOTAL CROSS SECTION RESTRICTED COVERAGE %	UNRESTRICTED CROSS SECTION AREA EXAMINED (SQ. INCHES)	TOTAL CROSS SECTION UNRESTRICTED COVERAGE %	TOTAL RESTRICTED COVERAGE (LENGTH X CROSS SECTION) %	TOTAL UNRESTRICTED COVERAGE (LENGTH X CROSS SECTION) %	TOTAL COVERAGE (RESTRICTED + UNRESTRICTED) %
TOWARD HEAD BASE MATERIAL AXIAL COVERAGE	47.12	47.12	100.00%	0	0.00%	12.696	1.856	14.62%	0	0.00%	14.62%	0.00%	14.62%
TOWARD HEAD WELD AXIAL COVERAGE	47.12	47.12	100.00%	0	0.00%	3.214	0.489	15.21%	0	0.00%	15.21%	0.00%	15.21%
TOWARD NOZZLE BASE MATERIAL AXIAL COVERAGE	47.12	47.12	100.00%	0	0.00%	12.696	11.436	90.08%	0	0.00%	90.08%	0.00%	90.08%
TOWARD NOZZLE WELD AXIAL COVERAGE	47.12	0	0.00%	47.12	100.00%	3.214	0	0.00%	3.214	100.00%	0.00%	100.00%	100.00%
HEAD SIDE CIRC COVERAGE WELD	47.12	0	0.00%	47.12	100.00%	1.607	0	0.00%	1.607	100.00%	0.00%	100.00%	100.00%
HEAD SIDE CIRC COVERAGE BASE MATERIAL	47.12	0	0.00%	47.12	100.00%	6.222	0	0.00%	6.222	100.00%	0.00%	100.00%	100.00%
NOZZLE SIDE CIRC COVERAGE WELD	47.12	0	0.00%	47.12	100.00%	1.607	0	0.00%	1.607	100.00%	0.00%	100.00%	100.00%
NOZZLE SIDE CIRC COVERAGE BASE MATERIAL	47.12	47.12	100.00%	0	0.00%	8.474	1.177	18.18%	0	0.00%	18.18%	0.00%	18.18%
TOTAL WELD VOLUME COVERAGE													67.26%

Calvin M. Black, CPA III, 11-19-98

ANN REVIEW
[Signature]



UT Calibration Examination

Site/Unit: HNP / 1
 Summary No.: H-02999
 Workscope: ISI

Procedure: NDEP-0450
 Procedure Rev.: 3 TR-A
 Work Order No.: 1313525

Outage No.: RFO-15
 Report No.: UT-09-040
 Page: 1 of 13

Code: 2001 Ed 2003 Add Cat./Item: B-D/B3.110 Location: CTMT 302'
 Drawing No.: 1-ISI-PZR-1 Description: Nozzle to Head
 System ID: RC-2050
 Component ID: II-PZR-01NTHW-12 Size/Length: 3.15" / 47.1" Thickness/Diameter: 3.35" / 15.0"
 Limitations: NOZZLE TO HEAD CONFIGURATION Start Time: 1545 Finish Time: 1630

Instrument Settings
 Serial No.: 0134D2 Manufacturer: Krautkramer Branson Model: USN-58L
 Delay: 1.3306 Range: 5.0" M'tl Cal/Vel: 0.2358 Pulser: SINGLE
 Damping: 1KΩ Reject: 0% Rep. Rate: HIGH Freq.: 2.25 MHZ
 Filter: N/A Mode: LOGITUDINAL Voltage: N/A Other: FULLWAVE
 Ax. Gain (dB): 29 Circ. Gain (dB): 29
10 Screen Div. = 5 in. of Sound Path
 Linearity Report No.: L-09-001

Search Unit
 Serial No.: C29344 Manufacturer: KB AeroTech Size: 0.75 Shape: Round
 Freq.: 2.25 MHz Style: Gamma Exam Angle: 0° # of Elements: 1
 Mode: Longitudinal Measured Angle: N/A Wedge Style: N/A
Search Unit Cable
 Type: RG-58 U Length: 6' No. Conn.: 0

Cal. Checks	Time	Date
Initial Cal.	1030	4/25/2009
Inter. Cal.	1400	4/25/2009
Inter. Cal.	1545	4/25/2009
Inter. Cal.		
Final Cal.	1730	4/25/2009

Couplant
 Cal. Batch: 05225
 Type: Ultragel II
 Mfg.: Sonotech, Inc.
 Exam Batch: 05225
 Type: Ultragel II
 Mfg.: Sonotech, Inc.

Axial Orientated Search Unit			
Calibration Reflector	Signal Amplitude %	Sweep Division	Sound Path
1/4 T	66	1.6	0.790
1/2 T	82	3.2	1.670
3/4 T	58	5.1	2.554
ID	>100%	7.2	3.562

Circumferential Orientated Search Unit			
Calibration Reflector	Signal Amplitude %	Sweep Division	Sound Path
N/A	N/A	N/A	N/A

Calibration Block
 Cal. Block No.: UT-050-1 Thickness: 3.50 Dia.: FLAT
 Cal. Blk. Temp. 78° Temp. Tool: 68951 Comp. Temp.: 88 Temp. Tool: 68951
 Upstream Downstream Scan dB: 41
 CW CCW Scan dB: N/A
 Exam Surface: OD Surface Condition: GROUND SMOOTH

Reference Block
 Serial No.: 792221
 Type: CS Rompas

Reference/Simulator Block				
Gain dB	Reflector	Signal Amplitude %	Sweep Division	Sound Path
29	SDH	52	0.7	0.727

Recordable Indication(s): Yes No (If Yes, Ref. Attached Ultrasonic Indication Report.)
 Results: Sat Unsat Eval
 Percent Of Coverage Obtained > 90%: *67.14% Reviewed Previous Data: Yes

Comments: ***Verified previously recorded limitations and coverage calculations from report #210-98-04 (See Extracted Pages Attached). Examination was in a Radiation area.**

Examiner	Level	II-PDI	Signature	Date	Reviewer	Signature	Date
Malia, Mark E.			<i>Mark E Malia</i>	4/25/2009	Damon Priestley PGN Lv III	<i>[Signature]</i>	4/29/2009
Examiner	Level	N/A	Signature	Date	Site Review	Signature	Date
N/A					Michael W. Blew	<i>[Signature]</i>	4/29/2009
Other	Level	III-PDI	Signature	Date	ANII Review	Signature	Date
Dugan, Michael P			<i>[Signature]</i>	4/29/2009	Nancy Ritchie-Slaughter	<i>Nancy Ritchie-Slaughter</i>	5/5/09



UT Calibration Examination

Site/Unit: HNP / 1
 Summary No.: H-02999
 Workscope: ISI

Procedure: NDEP-0450
 Procedure Rev.: 3 TR-A
 Work Order No.: 1313525

Outage No.: RFO-15
 Report No.: UT-09-040
 Page: 2 of 13

Code: 2001 Ed 2003 Add Cat./Item: B-D/B3.110 Location: CTMT 302'
 Drawing No.: 1-ISI-PZR-1 Description: Nozzle to Head
 System ID: RC-2050
 Component ID: II-PZR-01NTHW-12 Size/Length: 3.15" / 47.1" Thickness/Diameter: 3.35" / 15.0"
 Limitations: NOZZLE TO HEAD CONFIGURATION Start Time: 1545 Finish Time: 1630

Instrument Settings
 Serial No.: 0134D2
 Manufacturer: Krautkramer Branson
 Model: USN-58L
 Delay: 12.1922 Range: 10
 M'tl Cal/Vel: 0.1270 Pulsar: SINGLE
 Damping: 1KΩ Reject: 0%
 Rep. Rate: HIGH Freq.: 2.25 MHZ
 Filter: N/A Mode: SHEARWAVE
 Voltage: N/A Other: FULLWAVE
 Ax. Gain (dB): 42/56 Circ. Gain (dB): 42/56
10 Screen Div. = 10 in. of Sound Path
 Linearity Report No.: L-09-001

Search Unit
 Serial No.: C18133
 Manufacturer: KB AeroTech
 Size: .5" x 1" Shape: Rect.
 Freq.: 2.25 MHz Style: Gamma
 Exam Angle: 45° # of Elements: 1
 Mode: SHEARWAVE
 Measured Angle: 45°
 Wedge Style: SWS

Search Unit Cable
 Type: RG-58 U
 Length: 6' No. Conn.:

Cal. Checks	Time	Date
Initial Cal.	1035	4/25/2009
Inter. Cal.	1415	4/25/2009
Inter. Cal.	1600	4/25/2009
Inter. Cal.		
Final Cal.	1730	4/25/2009

Couplant
 Cal. Batch: 05225
 Type: Ultragel II
 Mfg.: Sonotech, Inc.
 Exam Batch: 05225
 Type: Ultragel II
 Mfg.: Sonotech, Inc.

Reference Block
 Serial No.: 792221
 Type: CS Rompas

Axial Orientated Search Unit			
Calibration Reflector	Signal Amplitude %	Sweep Division	Sound Path
1/4 T	85	1.2	1.159
1/2 T	62	2.4	2.383
3/4 T	40	3.6	3.649
ID NOTCH	13	5.2	5.146
5/4 T*	10%	6.1	6.00

Circumferential Orientated Search Unit			
Calibration Reflector	Signal Amplitude %	Sweep Division	Sound Path

Reference/Simulator Block				
Gain dB	Reflector	Signal Amplitude %	Sweep Division	Sound Path
42	SDH	45	1.0	1.024

Calibration Block
 Cal. Block No.: UT-050-1
 Thickness: 3.50 Dia.: FLAT
 Cal. Blk. Temp. 78° Temp. Tool: 68951
 Comp. Temp.: 88° Temp. Tool: 68951

Scan Coverage
 Upstream Downstream Scan dB: 62
 CW CCW Scan dB: 62
 Exam Surface: OD
 Surface Condition: GROUND SMOOTH

Recordable Indication(s): Yes No (If Yes, Ref. Attached Ultrasonic Indication Report.)
 Results: Sat Unsat Eval
 Percent Of Coverage Obtained > 90%: 67.14% Reviewed Previous Data: Yes

Comments: VERIFIED PREVIOUSLY RECORDED LIMITATIONS. SEE REPORT #210-98-04 FOR COVERAGE CALCULATION.
Db difference for 3/4 T to 5/4 T = 14dB

Examiner	Level	Signature	Date	Reviewer	Signature	Date
Malia, Mark E.	II-PDI	<i>Mark E Malia</i>	4/25/2009	Damon Priestley PGN Lv III	<i>Damon Priestley</i>	4/29/2009
N/A	N/A			Michael W. Blew	<i>M W Blew</i>	4/29/2009
Dugan, Michael P	III-PDI	<i>Shirley Dugan</i>	4/29/2009	Nancy Ritchie-Slaughter	<i>Nancy C Ritchie Slaughter</i>	5/5/09



UT Calibration Examination

Site/Unit: HNP / 1
 Summary No.: H-02999
 Workscope: ISI

Procedure: NDEP-0450
 Procedure Rev.: 3 TR-A
 Work Order No.: 1313525

Outage No.: RFO-15
 Report No.: UT-09-040
 Page: 3 of 13

Code: 2001 Ed 2003 Add Cat./Item: B-D/B3.110 Location: CTMT 302'
 Drawing No.: 1-ISI-PZR-1 Description: Nozzle to Head
 System ID: RC-2050
 Component ID: II-PZR-01NTHW-12 Size/Length: 3.15" / 47.1" Thickness/Diameter: 3.35" / 15.0"
 Limitations: NOZZLE TO HEAD CONFIGURATION Start Time: 1545 Finish Time: 1630

Instrument Settings

Serial No.: 0134D2
 Manufacturer: Krautkramer Branson
 Model: USN-58L
 Delay: 15.2428 Range: 10"
 M'tl Cal/Vel: 0.1270 Pulsar: SINGLE
 Damping: 1KQ Reject: 0%
 Rep. Rate: HIGH Freq.: 2.25 MHZ
 Filter: N/A Mode: SHEARWAVE
 Voltage: N/A Other: FULLWAVE
 Ax. Gain (dB): 49/63* Circ. Gain (dB): 49/63*
10 Screen Div. = 10 in. of Sound Path

Search Unit

Serial No.: C18130
 Manufacturer: KBA
 Size: .50"x1.0" Shape: Rect.
 Freq.: 2.25 MHz Style: GAMMA
 Exam Angle: 60° # of Elements: 1
 Mode: SHEARWAVE
 Measured Angle: 61°
 Wedge Style: SWS

Cal. Checks	Time	Date
Initial Cal.	1040	4/25/2009
Inter. Cal.	1430	4/25/2009
Inter. Cal.	1615	4/25/2009
Inter. Cal.		
Final Cal.	1730	4/25/2009

Axial Orientated Search Unit

Calibration Reflector	Signal Amplitude %	Sweep Division	Sound Path
1/4 T	83	1.8	1.823
1/2 T	49	3.6	3.598
3/4 T	31	5.4	5.38
ID NOTCH	11	7.3	7.298
5/4 T*	10	9.4	9.04

Couplant

Cal. Batch: 05225
 Type: Ultragel II
 Mfg.: Sonotech, Inc.
 Exam Batch: 05225
 Type: Ultragel II
 Mfg.: Sonotech, Inc.

Circumferential Orientated Search Unit

Calibration Reflector	Signal Amplitude %	Sweep Division	Sound Path

Search Unit Cable

Type: RG-58
 Length: 6' No. Conn.: 0

Scan Coverage

Upstream Downstream Scan dB: 69
 CW CCW Scan dB: 69
 Exam Surface: OD
 Surface Condition: GROUND SMOOTH

Reference Block

Serial No.: 792221
 Type: CS Rompas

Reference/Simulator Block

Gain dB	Reflector	Signal Amplitude %	Sweep Division	Sound Path
49	SDH	21	1.6	1.557

Calibration Block

Cal. Block No.: UT-050-1
 Thickness: 3.50 Dia.: FLAT
 Cal. Blk. Temp.: 78° Temp. Tool: 68951
 Comp. Temp.: 88° Temp. Tool: 68951

Recordable Indication(s): Yes No (If Yes, Ref. Attached Ultrasonic Indication Report.)

Results: Sat Unsat Eval

Percent Of Coverage Obtained > 90%: 67.14% Reviewed Previous Data: Yes

Comments: VERIFIED PREVIOUSLY RECORDED LIMITATIONS. SEE REPORT #210-98-04 FOR COVERAGE CALCULATION.

Db difference for 3/4 T to 5/4 T = 14 dB *DP* *4-30-09*


Examiner	Level	Signature	Date	Reviewer	Signature	Date
Malia, Mark E.	II-PDI	<i>Mark E Malia</i>	4/25/2009	Damon Priestley PGN Lv III	<i>DP</i>	4/29/2009
N/A	N/A			Michael W. Blew	<i>MWBlew</i>	4/29/2009
Dugan, Michael P	III-PDI	<i>Shel Dugan</i>	4/29/2009	Nancy Ritchie-Slaughter	<i>Nancy C Ritchie Slaughter</i>	5/5/09

Primary No.: H-02999

Sketch or Photo: Y:\Shared\Ideal\HNP_Data\Outage Scans\RO-15\UT-09-040A.JPG

DATA SHEET # 210-98-04
 PAGE 2 OF 25
 ISO # 1-FIS-PER-1
 WELD # NTHW-12

WELD LENGTH = 47.1 in
 REQUIRED EXAM VOLUME = (ABEF) (47.1) = 749.4 in²
 VOLUME NOT EXAMINED = (ACED) (47.1) = 252.5 in²
 $\% \text{ INCOMPLETE} = \left[\frac{252.5}{749.4} \right] 100 = 33.7\%$
 $\% \text{ COMPLETE} = 100 - 33.7 = 66.3\%$

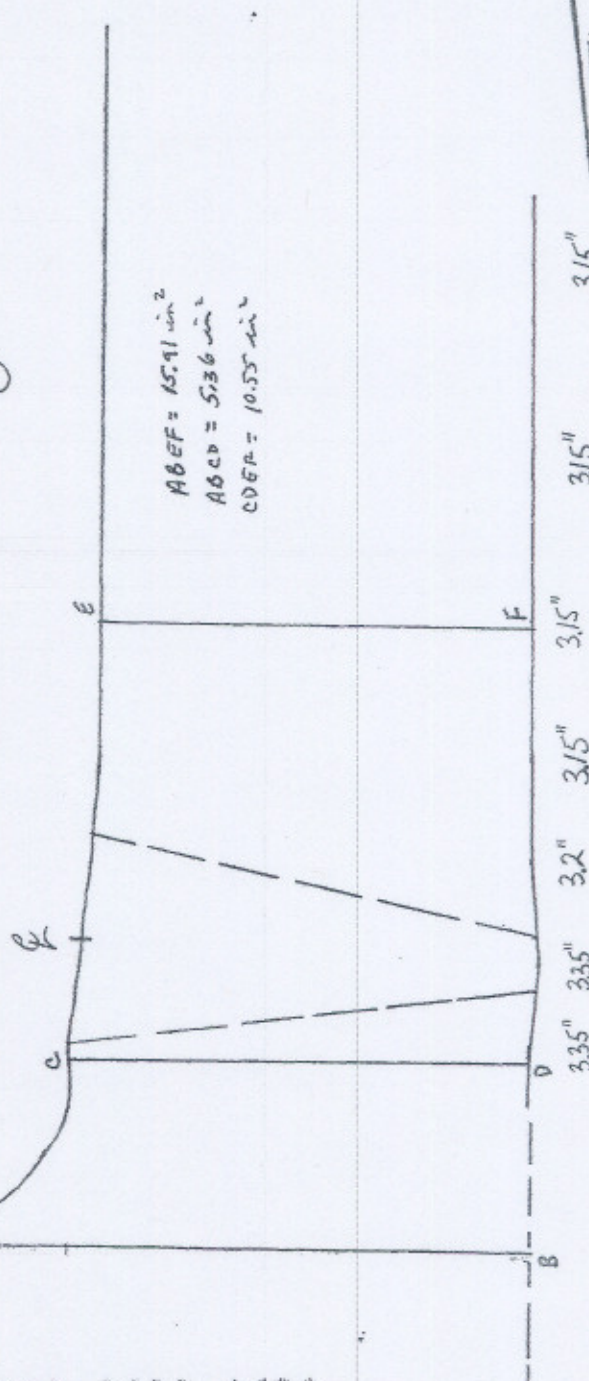

ANTI REVIEW
 AMEL EB
 DATE 11-25-98

EXAMINER Shawn R. Brown LEVEL II DATE 10-30-98
 EXAMINER Dele Mays LEVEL II DATE 10-29-98
 REVIEWER Scott Travers LEVEL III DATE 11-2-98

CSB
 11-9-98


NES, Inc.

0099 0188 1504

Primary No.: H-02999

Sketch or Photo: Y:\Shared\Ideal\HNP_Data\Outage Scans\RO-15\UT-09-040B.JPG

DATA SHEET # 210-98-04
 PAGE 6 OF 15
 ISO # 1-ISI-PZR-1
 WELD # NTHW-12

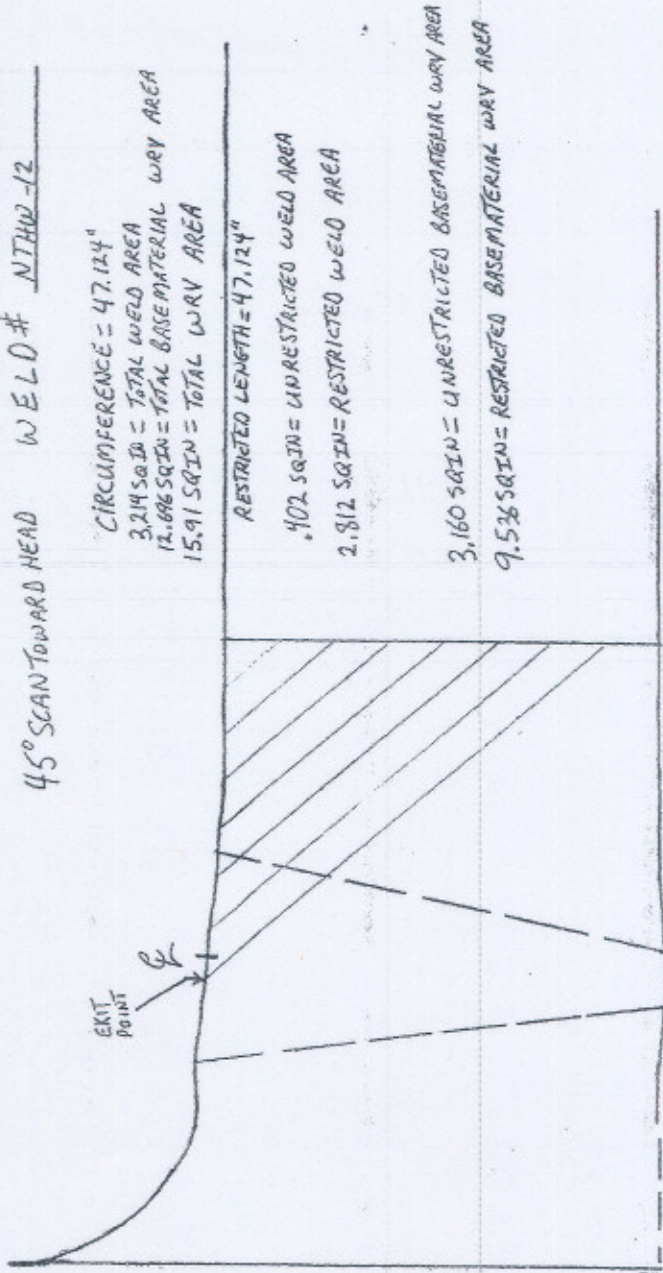

CIRCUMFERENCE = 47.124"
 3.214 SQIN = TOTAL WELD AREA
 12.686 SQIN = TOTAL BASE MATERIAL WRY AREA
 15.91 SQIN = TOTAL WRY AREA
 RESTRICTED LENGTH = 47.124"
 .402 SQIN = UNRESTRICTED WELD AREA
 2.812 SQIN = RESTRICTED WELD AREA
 3.160 SQIN = UNRESTRICTED BASE MATERIAL WRY AREA
 9.538 SQIN = RESTRICTED BASE MATERIAL WRY AREA

AMT REVIEW
 AMT DATE
 DATE 11-25-98

EXAMINER I. H. H. LEVEL II DATE 10/30/98
 EXAMINER J. B. B. LEVEL II DATE 10/30/98
 REVIEWER S. C. C. LEVEL III DATE 11-2-98

11-19-98

NES, Inc.

0000 0000 0000 0000

Summary No.: H-02999

Sketch or Photo: Y:\Shared\Ideal\HNP_Data\Outage Scans\RO-15\UT-09-040C.JPG

SC 11-11-98
DATA SHEET # 210-98-6-04

PAGE 2 OF 15

ISO # MSI-P2R-1


WELD # NTWU-12

CIRCUMFERENCE = 47.124"

45° SCAN TOWARD NOZZLE

NES, Inc.

0099 0100 1609

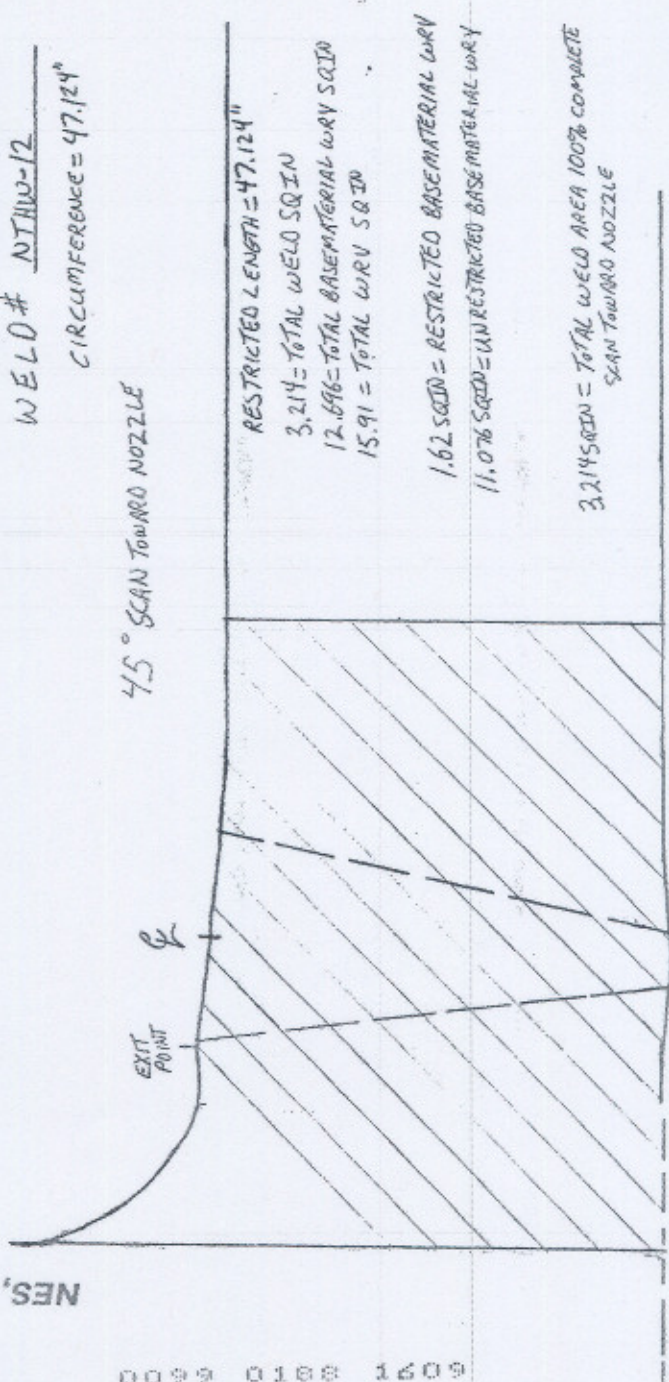


FINAL REVIEW
ASST. S. J. C.
DATE 11-23-98

EXAMINER T. Hulse LEVEL II DATE 11/30/98
EXAMINER Joseph D. Bay LEVEL III DATE 11/30/98
REVIEWER Scott L. Hulse LEVEL III DATE 11-2-98

duj
11-9-98

Primary No.: H-02999

Sketch or Photo: Y:\Shared\Ideal\HNP_Data\Outage Scans\RO-15\UT-09-040D.JPG

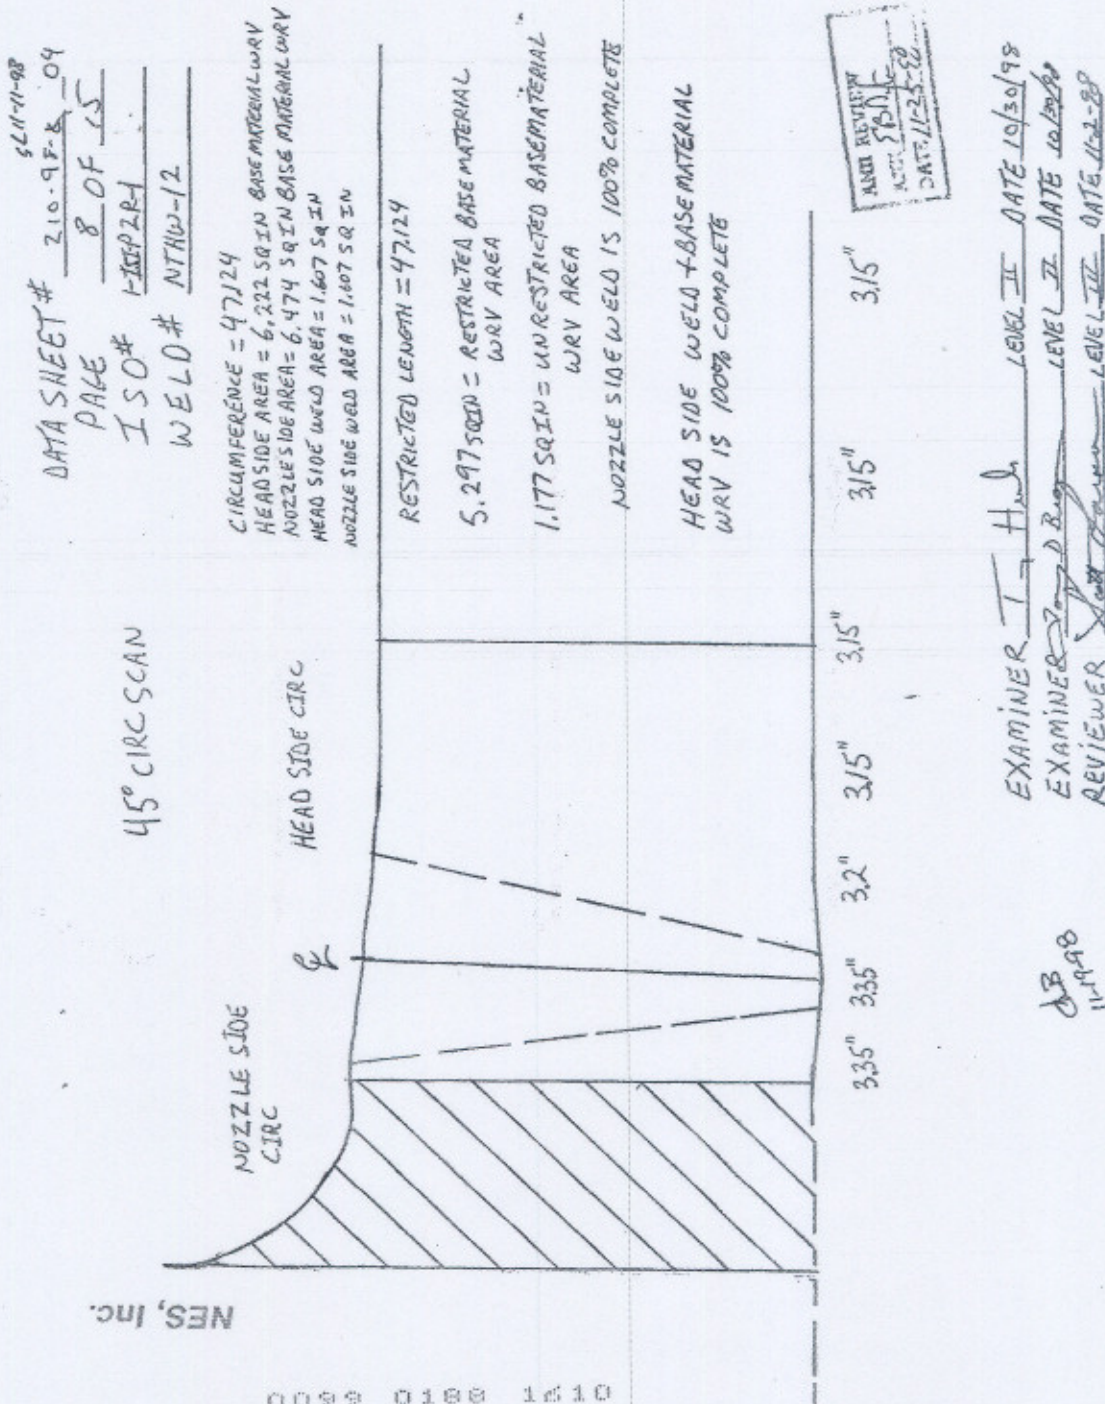


NES, Inc.

0000 0100 1010

Primary No.: H-02999

Sketch or Photo: Y:\Shared\Ideal\HNP_Data\Outage Scans\RO-15\UT-09-040E.JPG

DATA SHEET # 210-98-04
 PAGE 12 OF 15
 ISO# 1-ISE-PZR-1
 WELD# NTHW-12

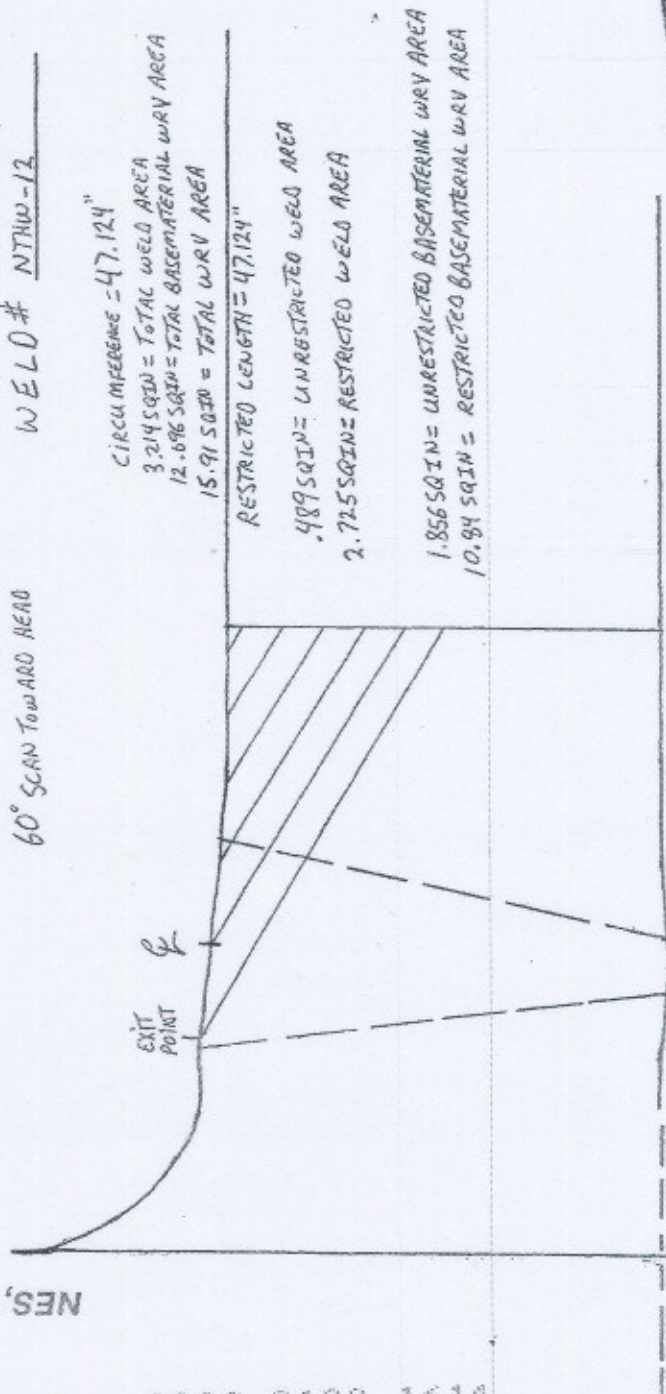

AMH REVIEW
 DATE 11-25-08

EXAMINER Paul S Blake LEVEL II DATE 10/30/08
 EXAMINER N/A LEVEL N/A DATE N/A
 REVIEWER John LEVEL III DATE 11-2-08

JB
 11-19-08

NES, Inc.

0000 0100 1614

DATA SHEET# 210-98-04 ^{SC 11-11-98}
 PAGE 14 OF 15
 ISO# 1-ESI-P2A-1
 WELD# NTHW-12

CIRCUMFERENCE = 47.124"
 HEAD SIDE AREA = 6.222 SQ IN BASE MATERIAL WRV
 NOZZLE SIDE AREA = 6.474 SQ IN BASE MATERIAL WRV
 HEAD SIDE WELD AREA = 1.607 SQ IN
 NOZZLE SIDE WELD AREA = 1.607 SQ IN

RESTRICTED LENGTH = 47.124"

5.297 SQ IN = RESTRICTED BASE MATERIAL WRV AREA


1.177 SQ IN = UNRESTRICTED BASE MATERIAL WRV AREA

NOZZLE SIDE WELD IS 100% COMPLETE

HEAD SIDE WELD + BASE MATERIAL WRV IS 100% COMPLETE

NES, Inc.

0099 0188 1616

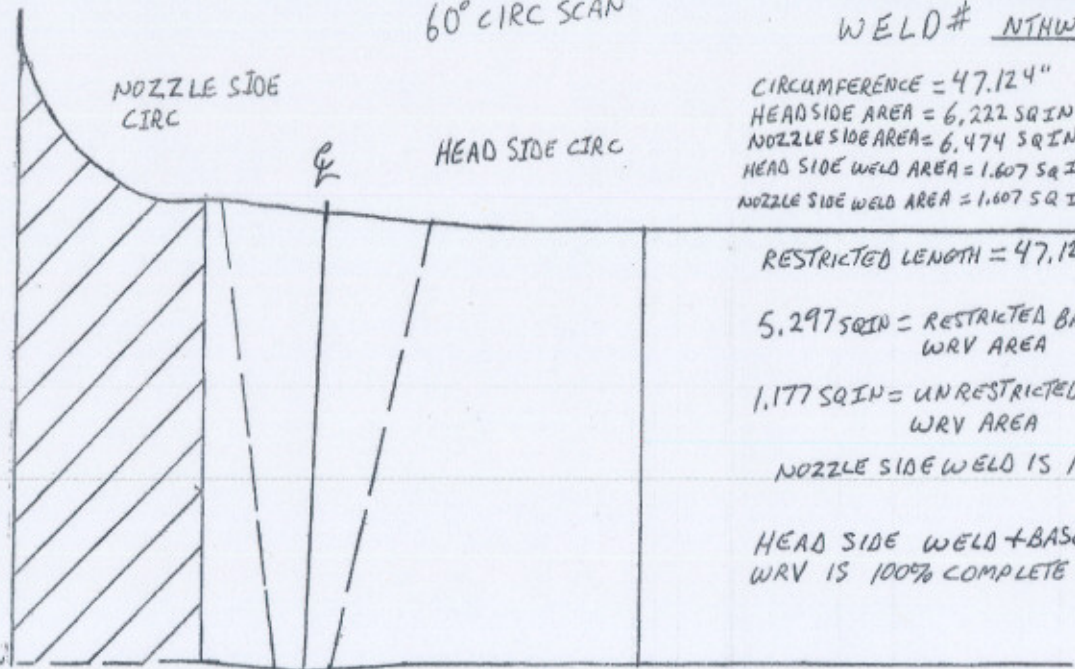

ANTI REVIEW
 ANTI *PSB*
 DATE 11-25-98

EXAMINER Paul S Blache LEVEL II DATE 10/30/98
 EXAMINER N/A LEVEL N/A DATE N/A
 REVIEWER Scott L... LEVEL III DATE 11-2-98

CSB
 11-19-98

COVERAGE CALCULATION SHEET

P 3 of 15

ISO# 1-ISI-PZR-1

DATA SHEET# 210-98-04

0099 0188 1809

WELD NO.:NTHW-12	0 DEGREE ONLY												
TOTAL WELD LENGTH (INCHES)	WELD LENGTH EXAMINED RESTRICTED (INCHES)	LENGTH EXAMINED RESTRICTED %	WELD LENGTH EXAMINED UNRESTRICTED (INCHES)	WELD LENGTH EXAMINED UNRESTRICTED %	CROSS SECTION AREA (SQ. INCHES)	RESTRICTED CROSS SECTION AREA EXAMINED (SQ. INCHES)	TOTAL CROSS SECTION RESTRICTED COVERAGE %	UNRESTRICTED CROSS SECTION AREA EXAMINED (SQ. INCHES)	TOTAL CROSS SECTION UNRESTRICTED COVERAGE %	TOTAL RESTRICTED COVERAGE (LENGTH X CROSS SECTION) %	TOTAL UNRESTRICTED COVERAGE (LENGTH X CROSS SECTION) %	TOTAL COVERAGE (RESTRICTED + UNRESTRICTED) %	
HEAD SIDE BASE MATERIAL AXIAL COVERAGE	47.12	47.12	100.00%	0	0.00%	15.91	10.55	66.31%	0	0.00%	66.31%	0.00%	66.31%

Johnnie Black, CPL III, 11-19-98

ANII REVIEW
 BY *EB Dwyer*
 DATE *11-25-98*

COVERAGE CALCULATION SHEET

P15 of 15
ISO# 1-ISI-PZR-1
DATA SHEET# 210-98-0A

WELD NO.:NTHW-12	60 DEGREE												
	TOTAL WELD LENGTH (INCHES)	WELD LENGTH EXAMINED RESTRICTED (INCHES)	LENGTH EXAMINED RESTRICTED %	WELD LENGTH EXAMINED UNRESTRICTED (INCHES)	WELD LENGTH EXAMINED UNRESTRICTED %	CROSS SECTION AREA (SQ. INCHES)	RESTRICTED CROSS SECTION AREA EXAMINED (SQ. INCHES)	TOTAL CROSS SECTION RESTRICTED COVERAGE %	UNRESTRICTED CROSS SECTION AREA EXAMINED (SQ. INCHES)	TOTAL CROSS SECTION UNRESTRICTED COVERAGE %	TOTAL RESTRICTED COVERAGE (LENGTH X CROSS SECTION) %	TOTAL UNRESTRICTED COVERAGE (LENGTH X CROSS SECTION) %	TOTAL COVERAGE (RESTRICTED + UNRESTRICTED) %
TOWARD HEAD BASE MATERIAL AXIAL COVERAGE	47.12	47.12	100.00%	0	0.00%	12.696	1.856	14.62%	0	0.00%	14.62%	0.00%	14.62%
TOWARD HEAD WELD AXIAL COVERAGE	47.12	47.12	100.00%	0	0.00%	3.214	0.489	15.21%	0	0.00%	15.21%	0.00%	15.21%
TOWARD NOZZLE BASE MATERIAL AXIAL COVERAGE	47.12	47.12	100.00%	0	0.00%	12.696	11.438	90.08%	0	0.00%	90.08%	0.00%	90.08%
TOWARD NOZZLE WELD AXIAL COVERAGE	47.12	0	0.00%	47.12	100.00%	3.214	0	0.00%	3.214	100.00%	0.00%	100.00%	100.00%
HEAD SIDE CIRC COVERAGE WELD	47.12	0	0.00%	47.12	100.00%	1.607	0	0.00%	1.607	100.00%	0.00%	100.00%	100.00%
HEAD SIDE CIRC COVERAGE BASE MATERIAL	47.12	0	0.00%	47.12	100.00%	6.222	0	0.00%	6.222	100.00%	0.00%	100.00%	100.00%
NOZZLE SIDE CIRC COVERAGE WELD	47.12	0	0.00%	47.12	100.00%	1.607	0	0.00%	1.607	100.00%	0.00%	100.00%	100.00%
NOZZLE SIDE CIRC COVERAGE BASE MATERIAL	47.12	47.12	100.00%	0	0.00%	6.474	1.177	18.18%	0	0.00%	18.18%	0.00%	18.18%
TOTAL WELD VOLUME COVERAGE													67.26%

Edwin Black, CP III, 11-19-98



UT Calibration/Examination

Site/Unit: HNP / 1 Procedure: NDEP-0450 Outage No.: RFO-17
 Summary No.: H-02996 Procedure Rev.: 4 Report No.: UT-12-010
 Workscope: ISI Work Order No.: 2050436 Page: 1 of 4

Code: 2001 Edition, 2003 Addenda Cat./Item: B-D/B3.110 Location: Containment 302'
 Drawing No.: 1-ISI-PZR-1 Description: Nozzle to Head
 System ID: RC-2050
 Component ID: II-PZR-01NTHW-09 Size/Length: _____ Thickness/Diameter: 3.50"
 Limitations: EXAM LIMITED TO HEAD SIDE ONLY, SEE PREVIOUS DATA 210-98-01 Start Time: 1515 Finish Time: 1730

Instrument Settings
 Serial No.: 0134L2 Manufacturer: Krautkramer Branson
 Model: USN 58L Linearity: L-12-004
 Delay: 1.2000 µs Range: 5.000"
 M'tl Cal/Vel: 0.2334"/µs Energy: High
 Damping: 1000 Ohms Reject: 0%
 PRF Mode: Auto High SU Freq.: 2.25 MHz
 Disp. Start: IP Rectify: Full Wave
 Inst. Freq.: 2.25 MHz

Ax. Gain (dB): 36 Circ. Gain (dB): 36
1 Screen Div. = 0.5" in. of Sound Path

Calibration Block
 Cal. Block No.: UT-050-1
 Thickness: 3.50" Dia.: FLAT
 Cal. Blk. Temp.: 80° Temp. Tool: 277634
 Comp. Temp.: 89° Temp. Tool: 277634

Recordable Indication(s): Yes No (If Yes, Ref. Attached Ultrasonic Indication Report.)
 Results: Sat Unsat Eval
 Percent Of Coverage Obtained > 90%: 66.31% Reviewed Previous Data: YES

Search Unit
 Serial No.: A29045 Manufacturer: KB AeroTech
 Size: 0.75" Model: GAMMA HP
 Freq.: 2.25 MHz Center Freq.: N/A
 Exam Angle: 0° Squint Angle: N/A
 Measured Angle: N/A Mode: LONG
 Exit Point: N/A # of Elements: 1
 Config.: SINGLE Focus: N/A
 Shape: Round Contour: N/A
 Wedge Style: N/A

Search Unit Cable
 Type: RG58U Length: 12' No. Conn.: 0

Scan Coverage
 Upstream Downstream Scan dB: 48
 CW CCW Scan dB: 48
 Exam Surface: OUTSIDE DIAMETER
 Surface Condition: GROUND SMOOTH

Cal. Checks	Time	Date
Initial Cal.	1415	4/30/2012
Inter. Cal.	N/A	
Inter. Cal.	N/A	
Inter. Cal.	N/A	
Final Cal.	1815	4/30/2012

Couplant
 Cal. Batch: 05325
 Type: Ultragel II
 Mfg.: Sonotech, Inc.
 Exam Batch: 05325
 Type: Ultragel II
 Mfg.: Sonotech, Inc.

Reference Block
 Serial No.: 6045-83
 Type: SS Rompas

Axial Orientated Search Unit			
Calibration Reflector	Signal Amplitude %	Sweep Division	Sound Path
1/4 T SDH	82%	1.6	0.795"
1/2 T SDH	70%	3.3	1.668"
3/4 T SDH	54%	5.1	2.541"
*B.W.	62%	7.1	3.536"
N/A	N/A	N/A	N/A

Circumferential Orientated Search Unit			
Calibration Reflector	Signal Amplitude %	Sweep Division	Sound Path
N/A	N/A	N/A	N/A

Reference/Simulator Block				
Gain dB	Reflector	Signal Amplitude %	Sweep Division	Sound Path
36	FSDH	45%	1.4	0.718"
N/A	N/A	N/A	N/A	N/A

Comments: **SWEEP & VELOCITY CALIBRATION WAS ACHIEVED ON IIW 2 BLOCK S/N 788805. *B.W. @ -6dB. REFERENCE PREVIOUS REPORT (210-98-01) FOR COVERAGE PLOTS.**

Examiner	Level	Signature	Date	Reviewer	Signature	Date
Malia, Mark	II-PDI	<i>Mark Malia</i>	4/30/2012	George Buck Level III	<i>George Buck</i>	5/4/2012
Perry, Robert	IIL	<i>Robert Perry</i>	4/30/2012	James Salton	<i>James Salton</i>	5/5/2012
N/A	N/A			Robert Winegarden ANII	<i>Robert Winegarden</i>	5/7/2012



UT Calibration/Examination

Site/Unit: HNP / 1
 Summary No.: H-02996
 Workscope: ISI

Procedure: NDEP-0450
 Procedure Rev.: 4
 Work Order No.: 2050436

Outage No.: RFO-17
 Report No.: UT-12-010
 Page: 2 of 4

Code: 2001 Edition, 2003 Addenda Cat./Item: B-D/B3.110 Location: Containment 302'
 Drawing No.: 1-ISI-PZR-1 Description: Nozzle to Head
 System ID: RC-2050
 Component ID: II-PZR-01NTHW-09 Size/Length: _____ Thickness/Diameter: 3.50"
 Limitations: EXAM LIMITED TO HEAD SIDE ONLY, SEE PREVIOUS DATA 210-98-01 Start Time: 1515 Finish Time: 1730

Instrument Settings
 Serial No.: 0134L2
 Manufacturer: Krautkramer Branson
 Model: USN 58L Linearity: L-12-004
 Delay: 12.3353 μs Range: 7.000"
 M'tl Cal/Vel: 0.1267"/μs Energy: High
 Damping: 1000 Ohms Reject: 0%
 PRF Mode: Auto High SU Freq.: 2.25 MHz
 Disp. Start: IP Rectify: Full Wave
 Inst. Freq.: 2.25 MHz

Search Unit
 Serial No.: L07926
 Manufacturer: KB AeroTech
 Size: 0.5"x1.0" Model: GAMMA
 Freq.: 2.25 MHz Center Freq.: N/A
 Exam Angle: 45° Squint Angle: N/A
 Measured Angle: 45° Mode: Shear
 Exit Point: 0.65" # of Elements: 1
 Config.: SINGLE Focus: N/A
 Shape: Rect. Contour: FLAT
 Wedge Style: NON INTEGRAL

Cal. Checks	Time	Date
Initial Cal.	1415	4/30/2012
Inter. Cal.	N/A	
Inter. Cal.	N/A	
Inter. Cal.	N/A	
Final Cal.	1815	4/30/2012

Couplant
 Cal. Batch: 05325
 Type: Ultragel II
 Mfg.: Sonotech, Inc.
 Exam Batch: 05325
 Type: Ultragel II
 Mfg.: Sonotech, Inc.

Axial Orientated Search Unit			
Calibration Reflector	Signal Amplitude %	Sweep Division	Sound Path
1/4 T SDH	82%	1.7	1.194"
1/2 T SDH	53%	3.4	2.397"
3/4 T SDH	34%	5.3	3.727"
ID NOTCH	6%	6.6	4.609"
5/4 T SDH	16%	8.7	6.090"

Circumferential Orientated Search Unit			
Calibration Reflector	Signal Amplitude %	Sweep Division	Sound Path
N/A	N/A	N/A	N/A

Reference/Simulator Block				
Gain dB	Reflector	Signal Amplitude %	Sweep Division	Sound Path
48	FSDH	62%	2.4	0.726"
N/A	N/A	N/A	N/A	N/A

Ax. Gain (dB): 42 Circ. Gain (dB): 42
1 Screen Div. = 0.7 in. of Sound Path
Calibration Block
 Cal. Block No.: UT-050-1
 Thickness: 3.50" Dia.: FLAT
 Cal. Blk. Temp.: 80° Temp. Tool: 277634
 Comp. Temp.: 89° Temp. Tool: 277634

Search Unit Cable
 Type: RG54U Length: 12' No. Conn.: 0
Scan Coverage
 Upstream Downstream Scan dB: 54
 CW CCW Scan dB: 54
 Exam Surface: OUTSIDE DIAMETER
 Surface Condition: GROUND SMOOTH

Reference Block
 Serial No.: 6045-83
 Type: SS Rompas

Recordable Indication(s): Yes No (If Yes, Ref. Attached Ultrasonic Indication Report.)
 Results: Sat Unsat Eval

Comments: **SWEEP & VELOCITY CALIBRATION WAS ACHIEVED ON IIW 2 BLOCK S/N 78880. dB change 3/4 to 5/4 from clad side = 6.5dB.**

Percent Of Coverage Obtained > 90%: 67.86% Reviewed Previous Data: YES

Examiner	Level	Signature	Date	Reviewer	Signature	Date
Malia, Mark	II-PDI	<i>Mark Malia</i>	4/30/2012	George Buck Level III	<i>George Buck</i>	5/4/2012
Examiner	Level	Signature	Date	Site Review	Signature	Date
Perry, Robert	III	<i>Robert Perry</i>	4/30/2012	James Salton	<i>James Salton</i>	5/5/2012
Other	Level	Signature	Date	ANII Review	Signature	Date
N/A	N/A			Robert Winegarden ANII	<i>Robert Winegarden</i>	5/7/2012



UT Calibration/Examination

Site/Unit: HNP / 1 Procedure: NDEP-0450 Outage No.: RFO-17
 Summary No.: H-02996 Procedure Rev.: 4 Report No.: UT-12-010
 Workscope: ISI Work Order No.: 2050436 Page: 3 of 4

Code: 2001 Edition, 2003 Addenda Cat./Item: B-D/B3.110 Location: Containment 302'
 Drawing No.: 1-ISI-PZR-1 Description: Nozzle to Head
 System ID: RC-2050
 Component ID: II-PZR-01NTHW-09 Size/Length: _____ Thickness/Diameter: 3.50"
 Limitations: EXAM LIMITED TO HEAD SIDE ONLY, SEE PREVIOUS DATA 210-98-01 Start Time: 1515 Finish Time: 1730

Instrument Settings
 Serial No.: 0134L2 Manufacturer: Krautkramer Branson Model: USN 58L Linearity: L-12-004
 Delay: 15.3406 μs Range: 10.00" M'tl Cal/Vel: 0.1271"/μs Energy: High
 Damping: 1000 Ohms Reject: 0% PRF Mode: Auto High SU Freq.: 2.25 MHz
 Disp. Start: IP Rectify: Full Wave Inst. Freq.: 2.25 MHz

Ax. Gain (dB): 50 Circ. Gain (dB): 50
1 Screen Div. = 1.0 in. of Sound Path

Calibration Block
 Cal. Block No.: UT-050-1 Thickness: 3.50" Dia.: FLAT
 Cal. Blk. Temp.: 80° Temp. Tool: 277634 Comp. Temp.: 89° Temp. Tool: 277634

Recordable Indication(s): Yes No (If Yes, Ref. Attached Ultrasonic Indication Report.)
 Results: Sat Unsat Eval
 Percent Of Coverage Obtained > 90%: 67.25% Reviewed Previous Data: YES

Search Unit
 Serial No.: L19954 Manufacturer: KB AeroTech Size: 0.5"x1.0" Model: GAMMA
 Freq.: 2.25 MHz Center Freq.: N/A Exam Angle: 60° Squint Angle: N/A
 Measured Angle: 62° Mode: SHEAR Exit Point: 0.65" # of Elements: 1
 Config.: SINGLE Focus: N/A Shape: RECT. Contour: FLAT
 Wedge Style: NON INTEGRAL

Search Unit Cable
 Type: RG58U Length: 12' No. Conn.: 0

Scan Coverage
 Upstream Downstream Scan dB: 62
 CW CCW Scan dB: 62
 Exam Surface: OUTSIDE DIAMETER Surface Condition: GROUNDS SMOOTH

Cal. Checks	Time	Date
Initial Cal.	1415	4/30/2012
Inter. Cal.	N/A	
Inter. Cal.	N/A	
Inter. Cal.	N/A	
Final Cal.	1815	4/30/2012

Couplant
 Cal. Batch: 05325 Type: Ultragel II
 Mfg.: Sonotech, Inc.
 Exam Batch: 05325 Type: Ultragel II
 Mfg.: Sonotech, Inc.

Reference Block
 Serial No.: 6045-83 Type: SS Rompas

Axial Orientated Search Unit			
Calibration Reflector	Signal Amplitude %	Sweep Division	Sound Path
1/4 T SDH	80%	1.8	1.786"
1/2 T SDH	45%	3.6	3.532"
3/4 T SDH	31%	5.5	5.488"
*ID NOTCH	30%	7.1	7.148"
5/4 T SDH	15%	8.3	8.324"

Circumferential Orientated Search Unit			
Calibration Reflector	Signal Amplitude %	Sweep Division	Sound Path
N/A	N/A	N/A	N/A

Reference/Simulator Block				
Gain dB	Reflector	Signal Amplitude %	Sweep Division	Sound Path
50	NSDH	69%	0.7	0.705"
N/A	N/A	N/A	N/A	N/A

Comments: **SWEEP & VELOCITY CALIBRATION WAS ACHIEVED ON IIW 2 BLOCK S/N 78880. dB change 3/4 to 5/4 from clad side = 6dB. *ID NOTCH = +12dB.**

Examiner	Level	Signature	Date	Reviewer	Signature	Date
Malia, Mark	II-PDI	<i>Mark Malia</i>	4/30/2012	George Buck Level III	<i>George Buck</i>	5/4/2012
Examiner	Level	Signature	Date	Site Review	Signature	Date
Perry, Robert	II	<i>Robert Perry</i>	4/30/2012	James Salton	<i>James Salton</i>	5/5/2012
Other	Level	Signature	Date	ANII Review	Signature	Date
N/A	N/A	<i>Robert Winegarden</i>		Robert Winegarden ANII	<i>Robert Winegarden</i>	5/7/2012



Determination of Percent Coverage for UT Examinations - Vessels

Site/Unit: HNP / 1 Procedure: NDEP-0450 Outage No.: RFO-17
 Summary No.: H-02996 Procedure Rev.: 4 Report No.: UT-12-010
 Workscope: ISI Work Order No.: 2050436 Page: 4 of 4

0 deg Planar

Scan 66.310 % Length X 100.000 % volume of length / 100 = 66.310 % total for 0 deg

45 deg

Scan 1 18.700 % Length X 100.000 % volume of length / 100 = 18.700 % total for Scan 1

Scan 2 93.620 % Length X 100.000 % volume of length / 100 = 93.620 % total for Scan 2

Scan 3 79.550 % Length X 100.000 % volume of length / 100 = 79.550 % total for Scan 3

Scan 4 79.550 % Length X 100.000 % volume of length / 100 = 79.550 % total for Scan 4

Add totals and divide by # scans = 67.855 % total for 45 deg

Other deg 60

Scan 1 14.870 % Length X 100.000 % volume of length / 100 = 14.870 % total for Scan 1

Scan 2 95.040 % Length X 100.000 % volume of length / 100 = 95.040 % total for Scan 2

Scan 3 79.550 % Length X 100.000 % volume of length / 100 = 79.550 % total for Scan 3

Scan 4 79.550 % Length X 100.000 % volume of length / 100 = 79.550 % total for Scan 4

Add totals and divide by # scans = 67.253 % total for 60 deg

Percent complete coverage

Add totals for each angle and scan required and divide by # of angles to determine;

67.139 % Total for complete exam

Note:

Supplemental coverage may be achieved by use of other angles / methods. When used, the coverage for volume not obtained with angles as noted above shall be calculated and added to the total to provide the percent total for the complete examination.

Site Field Supervisor: Edmund Donovan

Date: 4/30/2012

This Document is a QA Record

CAROLINA POWER & LIGHT COMPANY NDE REPORT/SUMMARY		Report No. _____ Page <u>1</u> Of <u>1</u>
Plant/Unit HNP	Component(s) or Item(s) Examined II-PZR-01, NTHW-09	
Procedure(s) ISI-210T		
<p>Per the ISI Program Plan, Interval 2, Period 1, Outage 1 (RFO-8), an ultrasonic examination (UT) was performed on the subject nozzle to head weld. This examination meets the requirements of ASME Section XI, 1989 Ed. and is acceptable to the evaluation criteria of IWA-3000.</p> <p>The UT exam was performed using 0°, 45°, and 60° shear wave techniques from the head side of the PZR. Due to the nozzle to head configuration access is limited. Per cent of weld volume complete is as follows:</p> <p>0° = 66.31% 45° = 67.85% 60° = 65.55% 67.26% <i>CLB 11-19-98</i></p> <p>Average of the 3 scans equals 66.57% 67.14% <i>CLB 11-19-98</i></p>		
Reported By: Scott Larson	Level III	Date 11-10-98
Reviewed By <i>Adrian Blunk</i>	Title <i>CP III</i>	Date 11-19-98

Exam Item: NTHW-09
 ISO/Drawing 1-ISO-PER-1

ULTRASONIC CALIBRATION DATA SHEET

DATA SHEET NO. 210-98-01
 PAGE 1 OF 15
 PROC. NO. ISS-210T
 REV. 0
 CHANGE NO. N/A


INSTRUMENT	
Make	<u>Staveley</u>
Model	<u>Sonic-136</u>
Serial No.	<u>1010L</u>
Daily Linearity	<u>yes</u>
VEL.	<u>0.233 in/μs Delay 0.004 in</u>
Range	<u>5.0 in Rep. Rate 4K</u>
Pulsar/Damping	<u>222AS/500.2</u>
Freq.	<u>2.25 MHz Filter 2</u>
Mode	<u>P-E Reject OFF</u>
Ref. Sensitivity:	<u>33.6 dB</u>
Dynamic Cal. Verified	<u>yes</u>
Remarks:	<u>N/A</u>

SEARCH UNIT	
Make	<u>AeroTech</u>
Serial No.	<u>L12580</u>
Size	<u>1.0" Ø</u>
Frequency	<u>2.25 MHz</u>
Mode	<u>Long</u>
Nom. Angle	<u>0°</u>
Measured Angle	<u>N/A</u>
Cable Type	<u>RG-58 B14</u>
Cable Length	<u>6'</u>
Wedge	<u>N/A</u>
Remarks:	<u>N/A</u>

CALIBRATION BLOCK	
No.	<u>4T-50-1</u>
"T"	<u>3.5</u> Dia. <u>N/A</u>
Temperature	<u>70 °F</u>
Thermometer S/N	<u>29424</u>

CALIBRATION	
0° <input checked="" type="checkbox"/> Axial	<input type="checkbox"/> Circ. <input type="checkbox"/> N/A
Metal Path <input type="checkbox"/> N/A	Depth <input checked="" type="checkbox"/>
Each Major Screen Div. =	<u>0.5"</u>
Remarks:	<u>N/A</u>

COUPLANT	
Brand	<u>Ultrage II</u>
Batch No.	<u>95225</u>

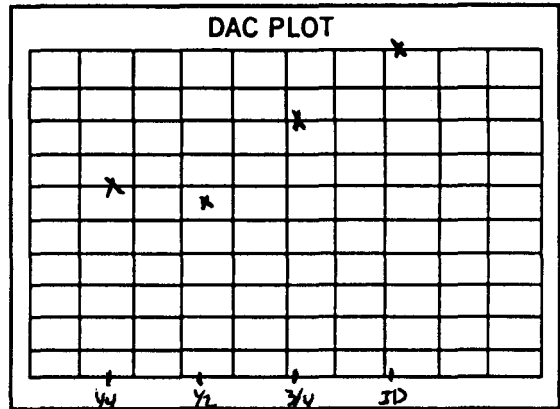

Remarks: 1/4T 1.6 @ 60% 33.8dB
1/2T 3.3 @ 55% 33.8dB
3/4T 5.1 @ 80% 33.8dB
ID 7.1 @ 100% 33.8dB

CAL. CHECKS	TIME
INITIAL CAL.	<u>0700</u>
INTERMEDIATE	<u>N/A</u>
INTERMEDIATE	<u>N/A</u>
INTERMEDIATE	<u>N/A</u>
FINAL CAL.	<u>1340</u>

SCAN dB <u>45/8</u>	COMP. TEMP	EXAMINATION COMPLETE		GEOMETRIC INDICATIONS		RECORDABLE INDICATIONS		EVALUATION	
		YES	NO	YES	NO	YES	NO	ACC.	REJ.
0° <u>1</u> = <u>N/A</u>	<u>88 °F</u>	YES	NO	YES	NO	YES	NO	ACC.	REJ.
<input checked="" type="checkbox"/> <u>N/A</u> <u>N/A</u> <u>N/A</u>	<u>S/N 29424</u>	<input checked="" type="checkbox"/> <u>N/A</u>	<input checked="" type="checkbox"/>	<u>N/A</u>	<input checked="" type="checkbox"/>	<u>N/A</u>	<input checked="" type="checkbox"/>	<input checked="" type="checkbox"/>	<u>N/A</u>
REMARKS: <u>INCOMPLETE HEAD TO NOZZLE SEE ATTACHED DRAWING FOR INCOMPLETE AREA</u>									

SCAN dB	COMP. TEMP	EXAMINATION COMPLETE		GEOMETRIC INDICATIONS		RECORDABLE INDICATIONS		EVALUATION	
		YES	NO	YES	NO	YES	NO	ACC.	REJ.
0° <u>1</u> =	°F	YES	NO	YES	NO	YES	NO	ACC.	REJ.
	<u>S/N</u>	<input checked="" type="checkbox"/>	<input checked="" type="checkbox"/>						
REMARKS: <u>A</u>									

ADDITIONAL COMMENTS	

ANII REVIEW
 ANII [Signature]
 DATE 11-25-98

EXAMINERS:
 1. [Signature] LEVEL II DATE 10-30-98
 2. [Signature] LEVEL III DATE 11-30-98

REVIEWERS:
 1. [Signature] LEVEL III DATE 11-3-98
 2. [Signature] LEVEL DATE
 3. [Signature] LEVEL III DATE 11-19-98

NES, Inc.

POST 8810 6600

WELD LENGTH = 40.05 in

REQUIRED EXAM VOLUME = (ABEF)(40.05) = 637.2 in³

VOLUME NOT EXAMINED = (ABCD)(40.05) = 214.7 in³

% INCOMPLETE = $\left[\frac{214.7}{637.2} \right] 100 = 33.7\%$

% COMPLETE = 100 - 33.7 = 66.3


DATA SHEET # 210-98-01

PAGE 2 OF 15

ISO# 1-ISI-PER-1

WELD# NTHW-09

0°

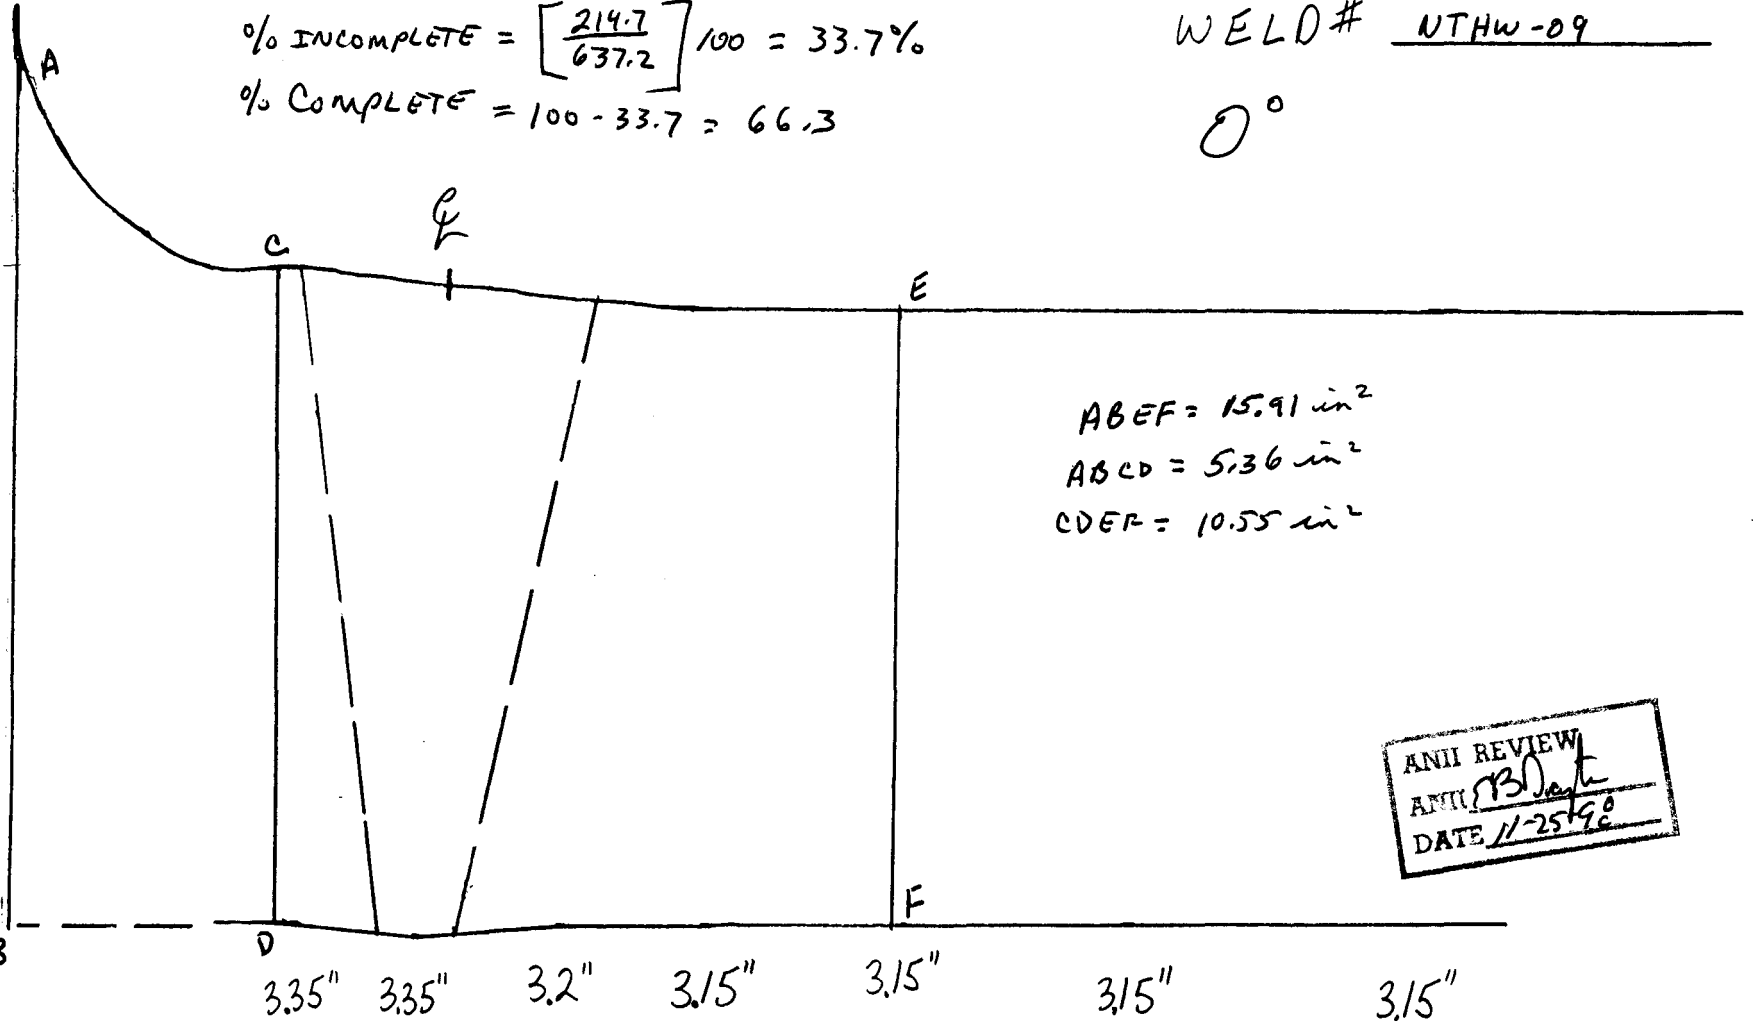

ABEF = 15.91 in²
 ABCD = 5.36 in²
 CDEF = 10.55 in²

ANII REVIEW
 ANII RB
 DATE 11-25-98

CB 11-19-98

EXAMINER Glen R. Dawson LEVEL II DATE 10-30-98
 EXAMINER Dale M. ... LEVEL III DATE 10/3/98
 REVIEWER Scott ... LEVEL III DATE 11-3-98

P 3 of 15
 ISO # 1-ISI-PZR-1
 DATA SHT # 210-98-01

0099 0188 1557

WELD NO.:NTHW-09							0 DEGREE ONLY							
TOTAL WELD LENGTH (INCHES)	WELD LENGTH EXAMINED RESTRICTED (INCHES)	LENGTH EXAMINED RESTRICTED %	WELD LENGTH EXAMINED UNRESTRICTED (INCHES)	WELD LENGTH EXAMINED UNRESTRICTED %	CROSS SECTION AREA (SQ. INCHES)	RESTRICTED CROSS SECTION AREA EXAMINED (SQ. INCHES)	TOTAL CROSS SECTION RESTRICTED COVERAGE %	UNRESTRICTED CROSS SECTION AREA EXAMINED (SQ. INCHES)	TOTAL CROSS SECTION UNRESTRICTED COVERAGE %	TOTAL RESTRICTED COVERAGE (LENGTH X CROSS SECTION) %	TOTAL UNRESTRICTED COVERAGE (LENGTH X CROSS SECTION) %	TOTAL COVERAGE (RESTRICTED + UNRESTRICTED) %		
HEAD SIDE BASE MATERIAL AXIAL COVERAGE	40.05	40.05	100.00%	0	0.00%	15.91	10.55	66.31%	0	0.00%	66.31%	0.00%	66.31%	

John W Block, CR LIII, 11-19-98

API REVIEW
 API EBN
 DATE 11-25-98

0000010001000

Exam It. NTHW-09
 ISO/Drawing 1-IST-P2R-1

ULTRASONIC C. VIBRATION DATA SHEET

DATA SHEET NO 210-98-01
 PAGE 4 OF 15
 PROC. NO. ISI-210
 REV. 0
 CHANGE NO. N/A


INSTRUMENT
Make <u>STAVELEY</u>
Model <u>SONIC 136</u>
Serial No. <u>10086</u>
Daily Linearity <u>YES</u>
VEL. <u>.124</u> In/ps Delay <u>.653</u> In
Range <u>7.0</u> In Rep. Rate <u>4KHZ</u>
Pulser/Damping <u>222ns/500R</u>
Freq. <u>2.25</u> MHz Filter <u>1</u>
Mode <u>P/E</u> Reject <u>OFF</u>
Ref. Sensitivity: <u>45.4</u> dB
Dynamic Cal. Verified <u>YES</u>
Remarks: <u>N/A</u>

SEARCH UNIT
Make <u>KBA</u>
Serial No. <u>610188</u>
Size <u>.50" x 1.00"</u>
Frequency <u>2.25</u> MHz
Mode <u>SHEAR</u> °
Nom. Angle <u>45</u> °
Measured Angle <u>45</u> °
Cable Type <u>RG58A</u>
Cable Length <u>12'</u>
Wedge <u>NONINTEGRAL</u>
Remarks: <u>N/A</u>

COUPLANT
Brand <u>ULTRAGEL II</u>
Batch No. <u>95225</u>

CALIBRATION BLOCK
No. <u>UT-50-1</u>
"T" <u>3.5</u> " Dia. <u>N/A</u>
Temperature <u>70</u> °F
Thermometer S/N <u>29684</u>

CALIBRATION
0° <input type="checkbox"/> <u>N/A</u> Axial <input checked="" type="checkbox"/> Circ. <input checked="" type="checkbox"/>
Metal Path <input checked="" type="checkbox"/> Depth <input type="checkbox"/> <u>N/A</u>
Each Major Screen Div. = <u>.7</u> "
Remarks <u>N/A</u>

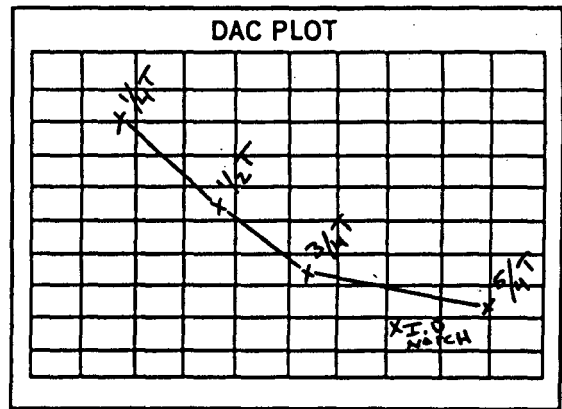

Remarks: N/A

SCAN dB <u>57.4</u>				COMP. TEMP	EXAMINATION COMPLETE		GEOMETRIC INDICATIONS		RECORDABLE INDICATIONS		EVALUATION	
0°	I	=	N/A	88 °F	YES	NO	YES	NO	YES	NO	ACC.	REJ.
N/A	X	N/A	N/A	S/N 29684	N/A	X	N/A	X	N/A	X	X	N/A

REMARKS: NOZZLE TO HEAD WELD. SCANNED BOTH DIRECTIONS FROM HEAD SIDE ONLY. EXAM INCOMPLETE DUE TO CONFIGURATION. SEE ATTACHED DRAWING FOR EXAM VOLUME LIMITATIONS.

SCAN dB <u>57.4</u>				COMP. TEMP	EXAMINATION COMPLETE		GEOMETRIC INDICATIONS		RECORDABLE INDICATIONS		EVALUATION	
0°	I	=	N/A	88 °F	YES	NO	YES	NO	YES	NO	ACC.	REJ.
N/A	N/A	X	N/A	S/N 29684	N/A	X	N/A	X	N/A	X	X	N/A

REMARKS: NOZZLE TO HEAD WELD. SCANNED BOTH DIRECTIONS FROM HEAD SIDE ONLY. EXAM INCOMPLETE DUE TO CONFIGURATION. SEE ATTACHED DRAWING FOR EXAM VOLUME LIMITATIONS.

CAL. CHECKS	TIME
INITIAL CAL.	<u>0947</u>
INTERMEDIATE	<u>N/A</u>
INTERMEDIATE	<u>N/A</u>
INTERMEDIATE	<u>N/A</u>
FINAL CAL.	<u>1604</u>

ADDITIONAL COMMENTS

N/A

ANII REVIEW

ANII 831

DATE 11-25-98

EXAMINERS:

1. T. Hule LEVEL II DATE 10/30/98

2. Joy D. Bio LEVEL II DATE 10/30/98

REVIEWERS:

1. [Signature] LEVEL III DATE 11-11-98

2. [Signature] LEVEL III DATE 11-19-98

3. [Signature] LEVEL III DATE 11-19-98

TRANSDUCER BEAM SPREAD MEASUREMENT

Data Sheet No. 210-98-01
Page 5 of 15

INSTRUMENT		DATA MEASUREMENTS		
MFG:	MODEL	POSITION	Distance from sound exit point to scribe line	HOLE DEPTH
STAVELEY	SONIC-136	¼ "T" HOLE		
		Forward 20% DAC	0.57"	0.88"
SERIAL NO: 1011L		Forward 50% DAC	0.75"	0.88"
		Maximum Signal	0.88"	0.88"
		Backward 50% DAC	1.03"	0.88"
SEARCH UNIT		Backward 20% DAC	1.12"	0.88"
		½ "T" HOLE		
MFG: KB AEROTECH		Forward 20% DAC	1.45"	1.76"
		Forward 50% DAC	1.55"	1.76"
SERIAL NO: 610188	SIZE: 0.5" X 1.0"	Maximum Signal	1.72"	1.76"
		Backward 50% DAC	1.98"	1.76"
FREQUENCY: 2.25 MHz	NOMINAL ANGLE: 45°	Backward 20% DAC	2.18"	1.76"
		¾ "T" HOLE		
WEDGE NO: 0-6		Forward 20% DAC	2.35"	2.64"
		Forward 50% DAC	2.45"	2.64"
CALIBRATION BLOCK I.D. NO: UT-50-1		Maximum Signal	2.68"	2.64"
		Backward 50% DAC	2.95"	2.64"
		Backward 20% DAC	3.15"	2.64"

Examinee Cherry R. Donovan

Level II

Date 10-27-98

Reviewer Scott L. Leno

Level III

Date 11-11-98

CLB 11-19-98

ANII REVIEW
ANII EB Dwyer
DATE 11-25-98




DATA SHEET # 210-98 01
 PAGE 6 OF 15
 ISO# 1-ISI-PZR-1
 WELD# NTHW-09

45° SCAN TOWARD HEAD

NES, Inc.

0981 8810 6600

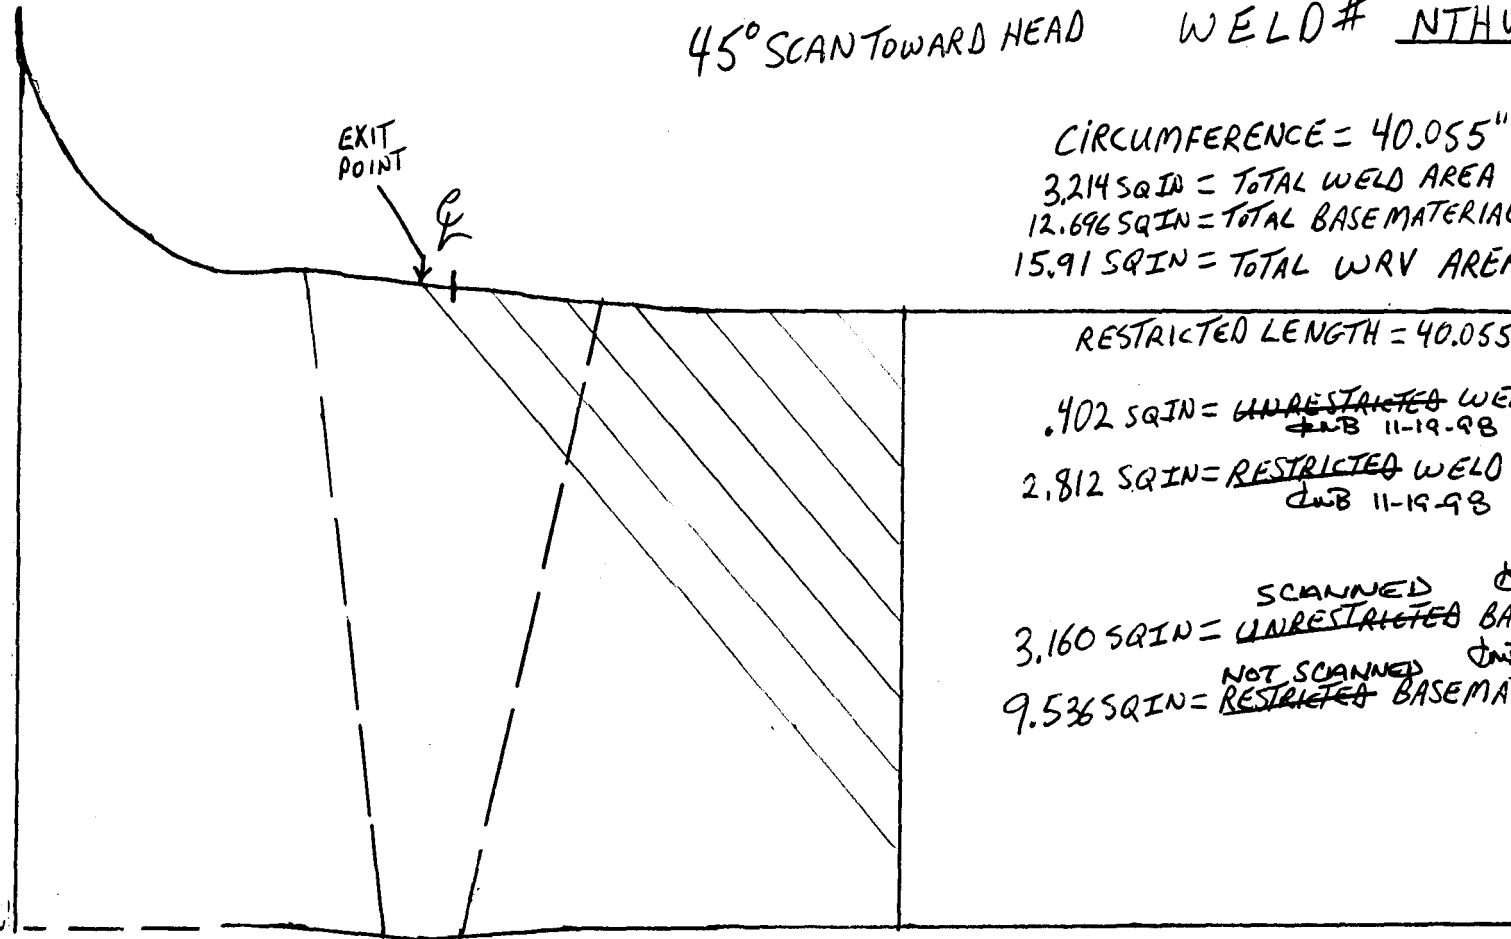

CIRCUMFERENCE = 40.055"
 3.214 SQIN = TOTAL WELD AREA
 12.696 SQIN = TOTAL BASE MATERIAL WRV AREA
 15.91 SQIN = TOTAL WRV AREA

RESTRICTED LENGTH = 40.055"

.402 SQIN = ~~UNRESTRICTED~~ WELD AREA SCANNED
 CNB 11-19-98

2.812 SQIN = ~~RESTRICTED~~ WELD AREA NOT SCANNED
 CNB 11-19-98

3.160 SQIN = ~~UNRESTRICTED~~ BASE MATERIAL WRV AREA
 SCANNED CNB 11-19-98

9.536 SQIN = ~~RESTRICTED~~ BASE MATERIAL WRV AREA
 NOT SCANNED CNB 11-19-98

3.35" 3.35" 3.2" 3.15" 3.15" 3.15" 3.15"

ANTI REVIEW
 ANI SP1
 DATE 11-25-98

EXAMINER T. Huh LEVEL II DATE 10/30/98
 EXAMINER [Signature] LEVEL II DATE 10/30/98
 REVIEWER [Signature] LEVEL III DATE 11-3-98

DATA SHEET # 210-98-2401
11-11-98

PAGE 7 OF 15

ISO# 1-ISI-P2R-1

WELD# NTHW-09

CIRCUMFERENCE = 40.055

NES, Inc.

45° SCAN TOWARD NOZZLE

EXIT POINT

Q

RESTRICTED LENGTH = 40.055

3.214 = TOTAL WELD SQ IN

12.696 = TOTAL BASE MATERIAL WRV SQ IN

15.91 = TOTAL WRV SQ IN

NOT SCANNED QMB 11-19-98
1.62 SQ IN = RESTRICTED BASE MATERIAL WRV
SCANNED
11.076 SQ IN = UNRESTRICTED BASE MATERIAL WRV
QMB 11-19-98

3.214 SQ IN = TOTAL WELD AREA 100% COMPLETE
SCAN TOWARD NOZZLE

3.35" 3.35" 3.2" 3.15" 3.15" 3.15" 3.15"

ANTI REVIEW
ANTI SP/ML
DATE 11-25-98

EXAMINER Ty Huh LEVEL II DATE 10/30/98
EXAMINER Joey D. B... LEVEL II DATE 10/30/98
REVIEWER Scott L... LEVEL III DATE 11-3-98

NES, Inc.

DATA SHEET # 210-98-6-01
PAGE 8 OF 15
ISO# HSL-PZR-1
WELD# NTNW-09

45° CIRC

NOZZLE SIDE
CIRC

HEAD SIDE CIRC

CIRCUMFERENCE = 40.055"
HEAD SIDE AREA = 6.222 SQ IN BASE MATERIAL WRV
NOZZLE SIDE AREA = 6.474 SQ IN BASE MATERIAL WRV
HEAD SIDE WELD AREA = 1.607 SQ IN
NOZZLE SIDE WELD AREA = 1.607 SQ IN

RESTRICTED LENGTH = 40.055"

5.297 SQ IN = RESTRICTED ^{ΦB 11-19-98} BASE MATERIAL
WRV AREA NOT SCANNED
1.177 SQ IN = UNRESTRICTED ^{SCANNED ΦB 11-19-98} BASE MATERIAL
WRV AREA

NOZZLE SIDE WELD IS 100% COMPLETE

HEAD SIDE WELD + BASE MATERIAL
WRV IS 100% COMPLETE

3.35" 3.35" 3.2" 3.15" 3.15" 3.15" 3.15"


ANII REVIEW
ANII BSA
DATE 11-25-98

EXAMINER T. Huh LEVEL II DATE 10/30/98
EXAMINER D. Big LEVEL II DATE 10/30/98
REVIEWER Scott Larson LEVEL III DATE 11-3-98

P.9 of 15
 ISO# 1-ISI-PZR-1
 DATA SHEET 210-98-01

WELD NO.:NTHW-09	45 DEGREE												
	TOTAL WELD LENGTH (INCHES)	WELD LENGTH EXAMINED RESTRICTED (INCHES)	LENGTH EXAMINED RESTRICTED %	WELD LENGTH EXAMINED UNRESTRICTED (INCHES)	WELD LENGTH EXAMINED UNRESTRICTED %	CROSS SECTION AREA (SQ. INCHES)	RESTRICTED CROSS SECTION AREA EXAMINED (SQ. INCHES)	TOTAL CROSS SECTION RESTRICTED COVERAGE %	UNRESTRICTED CROSS SECTION AREA EXAMINED (SQ. INCHES)	TOTAL CROSS SECTION UNRESTRICTED COVERAGE %	TOTAL RESTRICTED COVERAGE (LENGTH X CROSS SECTION) %	TOTAL UNRESTRICTED COVERAGE (LENGTH X CROSS SECTION) %	TOTAL COVERAGE (RESTRICTED + UNRESTRICTED) %
TOWARD HEAD BASE MATERIAL AXIAL COVERAGE	40.055	40.055	100.00%	0	0.00%	12.696	3.16	24.89%	0	0.00%	24.89%	0.00%	24.89%
TOWARD HEAD WELD AXIAL COVERAGE	40.055	40.055	100.00%	0	0.00%	3.214	0.402	12.51%	0	0.00%	12.51%	0.00%	12.51%
TOWARD NOZZLE BASE MATERIAL AXIAL COVERAGE	40.055	40.055	100.00%	0	0.00%	12.696	11.076	87.24%	0	0.00%	87.24%	0.00%	87.24%
TOWARD NOZZLE WELD AXIAL COVERAGE	40.055	0	0.00%	40.055	100.00%	3.214	0	0.00%	3.214	100.00%	0.00%	100.00%	100.00%
HEAD SIDE CIRC COVERAGE WELD	40.055	0	0.00%	40.055	100.00%	1.607	0	0.00%	1.607	100.00%	0.00%	100.00%	100.00%
HEAD SIDE CIRC COVERAGE BASEMATERIAL	40.055	0	0.00%	40.055	100.00%	6.222	0	0.00%	6.222	100.00%	0.00%	100.00%	100.00%
NOZZLE SIDE CIRC COVERAGE WELD	40.055	0	0.00%	40.055	100.00%	1.607	0	0.00%	1.607	100.00%	0.00%	100.00%	100.00%
NOZZ SIDE CIRC COVERAGE BASEMATERIAL	40.055	40.055	100.00%	0	0.00%	6.474	1.177	18.18%	0	0.00%	18.18%	0.00%	18.18%
TOTAL WELD VOLUME COVERAGE													67.85%

Edwin Black CPL III, 11-19-98

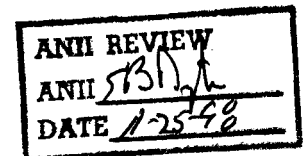

Exam Item: NTHW-9
 ISO/Drawing 1-ISI-PZR-1

ULTRASONIC CALIBRATION DATA SHEET

DATA SHEET NO. 210-98-01
 PAGE 10 OF 15
 PROC. NO. ISI-210T
 REV. 0
 CHANGE NO. N/A


INSTRUMENT	
Make	<u>STAVELEY</u>
Model	<u>SONIC 136</u>
Serial No.	<u>1339</u>
Daily Linearity	<u>YES</u>
VEL. <u>126</u> in/μs	Delay <u>.961</u> in
Range <u>10</u> in	Rep. Rate <u>4K</u>
Pulsar/Damping <u>500 OHMS</u>	
Freq. <u>2.25</u> MHz	Filter <u>1</u>
Mode <u>P/E</u>	Reject <u>OFF</u>
Ref. Sensitivity:	<u>48.4</u> dB
Dynamic Cal. Verified	<u>YES</u>
Remarks:	<u>NONE</u>

SEARCH UNIT	
Make	<u>KB-AEROTECH</u>
Serial No.	<u>LO3117</u>
Size	<u>.5" X 1.0"</u>
Frequency	<u>2.25</u> MHz
Mode	<u>SHEAR</u> °
Nom. Angle	<u>60</u> °
Measured Angle	<u>61</u>
Cable Type	<u>RG58A/U</u>
Cable Length	<u>12'</u>
Wedge	<u>NON-INTEGRAL</u>
Remarks:	<u>LUCITE WEDGE</u>
<u>MATERIAL</u>	

COUPLANT	
Brand	<u>ULTRAGEL II</u>
Batch No.	<u>95225</u>

CALIBRATION BLOCK	
No.	<u>UT 50-1</u>
"T" <u>3.5"</u>	Dia. <u>N/A</u>
Temperature	<u>71</u> °F
Thermometer S/N	<u>29684</u>

CALIBRATION	
0° <input checked="" type="checkbox"/> <u>N/A</u> Axial <input checked="" type="checkbox"/> Circ. <input checked="" type="checkbox"/>	Metal Path <input checked="" type="checkbox"/> Depth <input checked="" type="checkbox"/> <u>N/A</u>
Each Major Screen Div. =	<u>1"</u>
Remarks	<u>NONE</u>

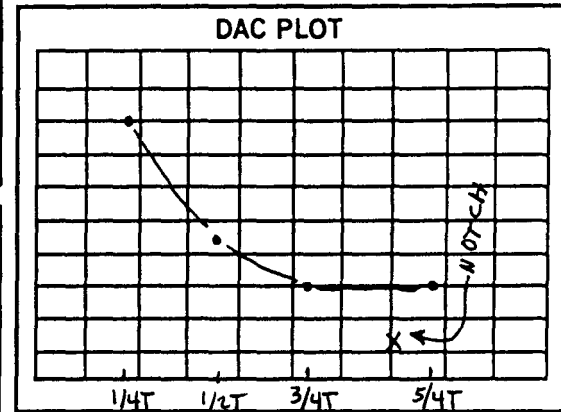

Remarks: NONE

SCAN dB <u>60.4</u>	COMP. TEMP	EXAMINATION COMPLETE		GEOMETRIC INDICATIONS		RECORDABLE INDICATIONS		EVALUATION	
		YES	NO	YES	NO	YES	NO	ACC.	REJ.
0° <u>1</u> = <u>N</u>	<u>88</u> °F	YES	NO	YES	NO	YES	NO	ACC.	REJ.
<u>N/A</u> <u>N/A</u> <u>N/A</u>	S/N <u>29684</u>	<u>N/A</u>	<u>N/A</u>	<u>N/A</u>	<u>N/A</u>	<u>N/A</u>	<u>N/A</u>	<u>N/A</u>	<u>N/A</u>

REMARKS: NOZZLE TO HEAD WELD. SCANNED BOTH DIRECTIONS FROM HEAD ONLY. EXAM INCOMPLETE DUE TO CONFIGURATION. SEE ATTACHED DRAWING FOR EXAM VOLUMN LIMITATIONS.

SCAN dB <u>60.4</u>	COMP. TEMP	EXAMINATION COMPLETE		GEOMETRIC INDICATIONS		RECORDABLE INDICATIONS		EVALUATION	
		YES	NO	YES	NO	YES	NO	ACC.	REJ.
0° <u>1</u> = <u>N</u>	<u>88</u> °F	YES	NO	YES	NO	YES	NO	ACC.	REJ.
<u>N/A</u> <u>N/A</u> <u>N/A</u>	S/N <u>29684</u>	<u>N/A</u>	<u>N/A</u>	<u>N/A</u>	<u>N/A</u>	<u>N/A</u>	<u>N/A</u>	<u>N/A</u>	<u>N/A</u>

REMARKS: NOZZLE TO HEAD WELD. SCANNED BOTH DIRECTIONS FROM HEAD ONLY. EXAM INCOMPLETE DUE TO CONFIGURATION. SEE ATTACHED DRAWING FOR EXAM VOLUMN LIMITATIONS.

CAL. CHECKS	TIME
INITIAL CAL.	<u>1054</u>
INTERMEDIATE	
INTERMEDIATE	
INTERMEDIATE	
FINAL CAL.	<u>1728</u>

ADDITIONAL COMMENTS	

ANII REVIEW
 ANII SP1
 DATE 11-25-98

EXAMINERS:
 1. Paul S Blech LEVEL II DATE 10/30/97
 2. N/A LEVEL N/A DATE N/A

REVIEWERS:
 1. [Signature] LEVEL III DATE 11-3-98
 2. [Signature] LEVEL DATE
 3. [Signature] LEVEL III DATE 11-19-98

TRANSDUCER BEAM SPREAD MEASUREMENT

Data Sheet No. 210-98-01

Page 11 of 15

INSTRUMENT		DATA MEASUREMENTS		
MFG:	MODEL	POSITION	Distance from sound exit point to scribe line	HOLE DEPTH
STAVELEY	SONIC 136	¼ "T" HOLE		
		Forward 20% DAC	1.25"	0.88"
SERIAL NO:	1010L	Forward 50% DAC	1.37"	0.88"
		Maximum Signal	1.67"	0.88"
SEARCH UNIT		Backward 50% DAC	2.0"	0.88"
		Backward 20% DAC	2.13"	0.88"
MFG:	KB-AEROTECH	½ "T" HOLE		
		Forward 20% DAC	2.62"	1.76"
SERIAL NO:	SIZE:	Forward 50% DAC	2.75"	1.76"
		Maximum Signal	3.15"	1.76"
FREQUENCY:	NOMINAL ANGLE:	Backward 50% DAC	3.47"	1.76"
		Backward 20% DAC	3.63"	1.76"
WEDGE NO:	05	¾ "T" HOLE		
		Forward 20% DAC	3.85"	2.64"
CALIBRATION BLOCK I.D. NO:	UT-50-1	Forward 50% DAC	4.13"	2.64"
		Maximum Signal	4.80"	2.64"
		Backward 50% DAC	5.65"	2.64"
		Backward 20% DAC	6.10"	2.64"

Examiner Edmund J. Donera

Level II

Date 10-27-98

Reviewer Joe Fawcett

Level III

Date 11-11-98

JTB 11-19-98

ANII REVIEW
 ANII FBH
 DATE 11-25-98



00000100010000


NES, Inc.

150106600

DATA SHEET # 210-98-01
PAGE 13 OF 15
ISO# 1-ISI-P2A-1
WELD# NTHW-09

60° SCAN TOWARD NOZZLE
FROM HEAD SIDE

CIRCUMFERENCE = 40.055"
3.214 = TOTAL WELD SQ IN
12.696 = TOTAL BASE MATERIAL WRV SQ IN
15.91 = TOTAL WRV SQ IN

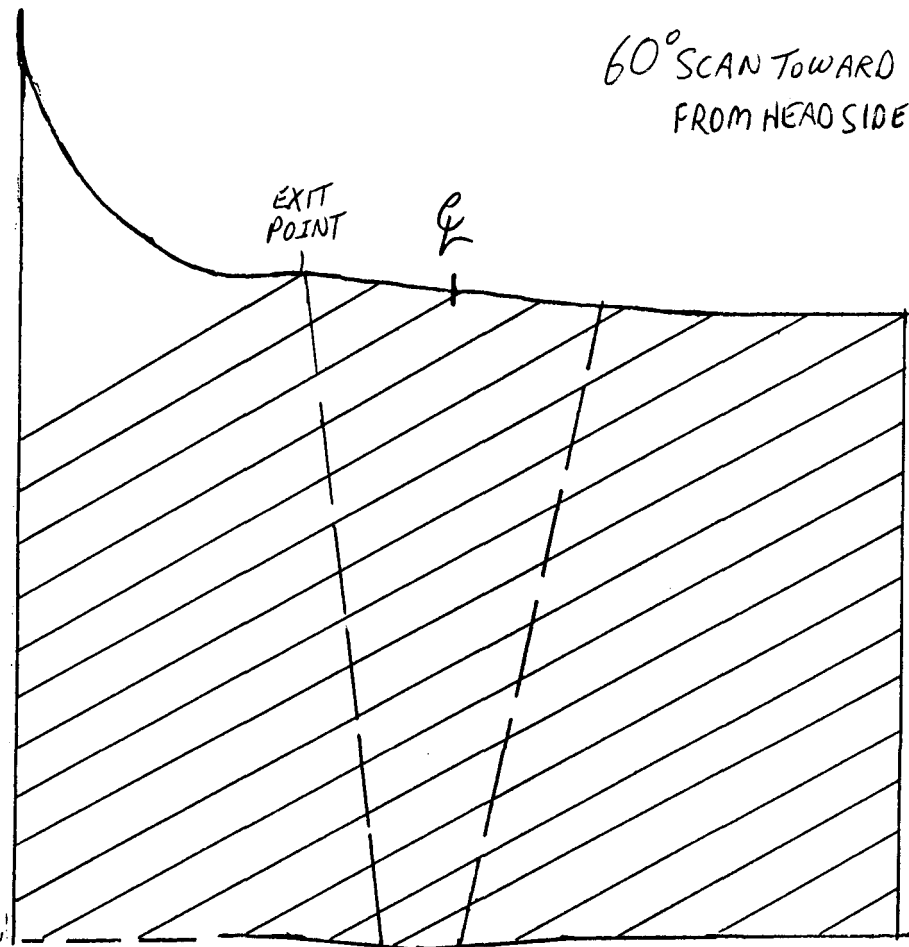

RESTRICTED LENGTH IS ~~47.129~~ ^{DNB 11-19-98} 40.055"
NOT SCANNED ^{DNB 11-19-98}
1.26 SQ IN = RESTRICTED BASE MATERIAL WRV
11.436 SQ IN = UNRESTRICTED BASE MATERIAL WRV
SCANNED ^{DNB 11-19-98}

3.214 SQ IN = TOTAL WELD AREA 100% COMPLETE
SCAN TOWARD NOZZLE

3.35" 3.35" 3.2" 3.15" 3.15" 3.15" 3.15"

ANII REVIEW
ANID B. Blech
DATE 11-25-98

DNB
11-19-98

EXAMINER Paul S Blech LEVEL II DATE 10/30/98
EXAMINER N/A LEVEL N/A DATE N/A
REVIEWER Scott L... LEVEL III DATE 11-3-98

NES, Inc.

0901 0010 6600

60° CIRC SCAN

DATA SHEET # 210-98-01

PAGE 14 OF 15

ISO# 1-ISIPZR-1

WELD# NTHW-09

NOZZLE SIDE CIRC

HEAD SIDE CIRC

CIRCUMFERENCE = 40.055"
 HEADSIDE AREA = 6.222 SQ IN BASE MATERIAL WRV
 NOZZLE SIDE AREA = 6.474 SQ IN BASE MATERIAL WRV
 HEAD SIDE WELD AREA = 1.607 SQ IN
 NOZZLE SIDE WELD AREA = 1.607 SQ IN

RESTRICTED LENGTH = 40.055"

5.297 SQ IN = ~~RESTRICTED~~ NOT SCANNED CMB 11-19-98
 BASE MATERIAL WRV AREA

1.177 SQ IN = ~~UNRESTRICTED~~ SCANNED CMB 11-19-98
 BASE MATERIAL WRV AREA

NOZZLE SIDE WELD IS 100% COMPLETE

HEAD SIDE WELD + BASE MATERIAL WRV IS 100% COMPLETE

3.35" 3.35" 3.2" 3.15" 3.15" 3.15" 3.15"

ANII REVIEW
 ANII PSA
 DATE 11-25-98

CMB
11-19-98

EXAMINER Paul S Blecha LEVEL II DATE 10/30/98

EXAMINER N/A LEVEL N/A DATE N/A

REVIEWER Scott Lauer LEVEL III DATE 11-3-98

COVERAGE CALCULATION SHEET


AMB 11-19-98
 15
 PL# of 15

ISS# 1-ISI-PER-1
 DATA SHEET # 210-98-01

0099 0188 1888

WELD NO.: NTHW-09	90 DEGREE												
	TOTAL WELD LENGTH (INCHES)	WELD LENGTH EXAMINED RESTRICTED (INCHES)	LENGTH EXAMINED RESTRICTED %	WELD LENGTH EXAMINED UNRESTRICTED (INCHES)	WELD LENGTH EXAMINED UNRESTRICTED %	CROSS SECTION AREA (SQ. INCHES)	RESTRICTED CROSS SECTION AREA EXAMINED (SQ. INCHES)	TOTAL CROSS SECTION RESTRICTED COVERAGE %	UNRESTRICTED CROSS SECTION AREA EXAMINED (SQ. INCHES)	TOTAL CROSS SECTION UNRESTRICTED COVERAGE %	TOTAL RESTRICTED COVERAGE (LENGTH X CROSS SECTION) %	TOTAL UNRESTRICTED COVERAGE (LENGTH X CROSS SECTION) %	TOTAL COVERAGE (RESTRICTED + UNRESTRICTED) %
TOWARD HEAD BASE MATERIAL AXIAL COVERAGE	40.055	40.055	100.00%	0	0.00%	12.696	1.856	14.62%	0	0.00%	14.62%	0.00%	14.62%
TOWARD HEAD WELD AXIAL COVERAGE	40.055	40.055	100.00%	0	0.00%	3.214	0.489	15.21%	0	0.00%	15.21%	0.00%	15.21%
TOWARD NOZZLE BASE MATERIAL AXIAL COVERAGE	40.055	40.055	100.00%	0	0.00%	12.696	11.438	90.08%	0	0.00%	90.08%	0.00%	90.08%
TOWARD NOZZLE WELD AXIAL COVERAGE	40.055	0	0.00%	40.055	100.00%	3.214	0	0.00%	3.214	100.00%	0.00%	100.00%	100.00%
HEAD SIDE CIRC COVERAGE WELD	40.055	0	0.00%	40.055	100.00%	1.607	0	0.00%	1.607	100.00%	0.00%	100.00%	100.00%
HEAD SIDE CIRC COVERAGE BASE MATERIAL	40.055	0	0.00%	40.055	100.00%	6.222	0	0.00%	6.222	100.00%	0.00%	100.00%	100.00%
NOZZLE SIDE CIRC COVERAGE WELD	40.055	0	0.00%	40.055	100.00%	1.607	0	0.00%	1.607	100.00%	0.00%	100.00%	100.00%
NOZZLE SIDE CIRC COVERAGE BASE MATERIAL	40.055	40.055	100.00%	0	0.00%	6.474	1.177	18.18%	0	0.00%	18.18%	0.00%	18.18%
TOTAL WELD VOLUME COVERAGE													67.26%

Adwin Black, CPA III, 11-19-98

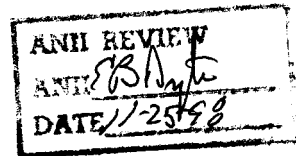



UT Calibration/Examination

Site/Unit: HNP / 1
 Summary No.: H-03000
 Workscope: ISI

Procedure: NDEP-0450
 Procedure Rev.: 4
 Work Order No.: 2050436

Outage No.: RFO-17
 Report No.: UT-12-014
 Page: 1 of 5

Code: 2001 Edition, 2003 Addenda Cat./Item: B-D/B3.110 Location: Containment 302'
 Drawing No.: 1-ISI-PZR-1 Description: Nozzle to Head
 System ID: RC-2050
 Component ID: II-PZR-01NTHW-13 Size/Length: N/A Thickness/Diameter: N/A
 Limitations: CONFIGURATION (SEE SKETCH) Start Time: 1302 Finish Time: 1520

Instrument Settings
 Serial No.: 021063 Manufacturer: General Electric Model: USN 58Lsw Linearity: L-12-001
 Delay: 1.15 µs Range: 5.000" M'tl Cal/Vel: 0.2330"/µs Pulsar Type: Square
 Damping: 500 Ohms Reject: 0% PRF: Auto High SU Freq.: 2.25 MHz
 Frequency: 2.25 MHz Rectify: Fullwave Voltage: 450 Pulse Width: 220

Search Unit
 Serial No.: C29344 Manufacturer: KB AeroTech Size: 0.75" Model: Gamma
 Freq.: 2.25 MHz Center Freq.: N/A Exam Angle: 0° Squint Angle: N/A
 Measured Angle: 0° Mode: LONG. Exit Point: N/A # of Elements: 1
 Config.: SINGLE Focus: N/A Shape: ROUND Contour: N/A
 Wedge Style: INTEGRAL

Search Unit Cable
 Ax. Gain (dB): 17 Circ. Gain (dB): N/A
1 Screen Div. = 0.5 in. of Depth Type: RG58 Length: 6' No. Conn.: 0

Calibration Block
 Cal. Block No.: UT-050-1 Thickness: 3.50" Dia.: FLAT
 Cal. Blk. Temp.: 85° Temp. Tool: 277510 Exam Surface: OUTSIDE DIAMETER
 Comp. Temp.: 90° Temp. Tool: 277510 Surface Condition: GROUND FLUSH

Recordable Indication(s): Yes No (If Yes, Ref. Attached Ultrasonic Indication Report.)
 Results: Sat Unsat Eval
 Percent Of Coverage Obtained > 90%: 69.26% Reviewed Previous Data: YES

Cal. Checks	Time	Date
Initial Cal.	1130	5/3/2012
Inter. Cal.	1302	5/3/2012
Inter. Cal.	N/A	
Inter. Cal.	N/A	
Final Cal.	1540	5/3/2012

Couplant
 Cal. Batch: 05325 Type: Ultrigel II
 Mfg.: Sonotech, Inc.
 Exam Batch: 05325 Type: Ultrigel II
 Mfg.: Sonotech, Inc.

Reference Block
 Serial No.: 792221 Type: CS Rompas

Axial Orientated Search Unit			
Calibration Reflector	Signal Amplitude %	Sweep Division	Depth
1/4 T	82%	1.6	0.81"
1/2 T	82%	3.4	1.676"
3/4 T	56%	5.1	2.54"
N/A	N/A	N/A	N/A

Circumferential Orientated Search Unit			
Calibration Reflector	Signal Amplitude %	Sweep Division	Depth
N/A	N/A	N/A	N/A

Reference/Simulator Block				
Gain dB	Reflector	Signal Amplitude %	Sweep Division	Depth
9	1" BW	81%	2.0	1.01"
N/A	N/A	N/A	N/A	N/A

Comments: **NO RECORDABLE INDICATIONS.**

Examiner	Level	Signature	Date	Reviewer	Signature	Date
Mahoney, Patrick V.	II	<i>[Signature]</i>	5/3/2012	George Buck Level III	<i>[Signature]</i>	5/4/2012
N/A	N/A			James Salton	<i>[Signature]</i>	5/5/2012
N/A	N/A			Robert Winegarden ANII	<i>[Signature]</i>	5/7/2012



UT Calibration/Examination

Site/Unit: HNP / 1
 Summary No.: H-03000
 Workscope: ISI

Procedure: NDEP-0450
 Procedure Rev.: 4
 Work Order No.: 2050436

Outage No.: RFO-17
 Report No.: UT-12-014
 Page: 2 of 5

Code: 2001 Edition, 2003 Addenda Cat./Item: B-D/B3.110 Location: Containment 302'
 Drawing No.: 1-ISI-PZR-1 Description: Nozzle to Head
 System ID: RC-2050
 Component ID: II-PZR-01NTHW-13 Size/Length: N/A Thickness/Diameter: N/A
 Limitations: CONFIGURATION (SEE SKETCH) Start Time: 1302 Finish Time: 1520

Instrument Settings
 Serial No.: 021063
 Manufacturer: General Electric
 Model: USN 58Lsw Linearity: L-12-001
 Delay: 12.6941 μs Range: 6.400"
 M'tl Cal/Vel: 0.1280"/μs Pulsar Type: Square
 Damping: 500 Ohms Reject: 0%
 PRF: Auto High SU Freq.: 2.25 MHz
 Frequency: 2.25 MHz Rectify: Fullwave
 Voltage: 450 Pulse Width: 220
 Ax. Gain (dB): 32.5 Circ. Gain (dB): N/A
1 Screen Div. = 0.640 in. of Sound Path

Search Unit
 Serial No.: C18133
 Manufacturer: KB AeroTech
 Size: 0.5" x 1.0" Model: Gamma
 Freq.: 2.25 MHz Center Freq.: N/A
 Exam Angle: 45° Squint Angle: N/A
 Measured Angle: 45° Mode: SHEAR
 Exit Point: 0.65" # of Elements: 1
 Config.: SINGLE Focus: N/A
 Shape: RECT. Contour: N/A
 Wedge Style: NON INTEGRAL

Search Unit Cable
 Type: RG58 Length: 6' No. Conn.: 0

Scan Coverage
 Upstream Downstream Scan dB: 44
 CW CCW Scan dB: 44
 Exam Surface: OUTSIDE DIAMETER
 Surface Condition: GROUND FLUSH

Cal. Checks	Time	Date
Initial Cal.	1133	5/3/2012
Inter. Cal.	1302	5/3/2012
Inter. Cal.	N/A	
Inter. Cal.	N/A	
Final Cal.	1543	5/3/2012

Couplant
 Cal. Batch: 05325
 Type: Ultragel II
 Mfg.: Sonotech, Inc.
 Exam Batch: 05325
 Type: Ultragel II
 Mfg.: Sonotech, Inc.

Reference Block
 Serial No.: 792221
 Type: CS Rompas

Axial Orientated Search Unit			
Calibration Reflector	Signal Amplitude %	Sweep Division	Sound Path
1/4 T	80%	1.8	1.18"
1/2 T	58%	3.7	2.4"
3/4 T	40%	5.7	3.70"
ID	22%	8.0	5.11"
5/4 T	30%	10.0	6.38"

Circumferential Orientated Search Unit			
Calibration Reflector	Signal Amplitude %	Sweep Division	Sound Path
N/A	N/A	N/A	N/A

Reference/Simulator Block				
Gain dB	Reflector	Signal Amplitude %	Sweep Division	Sound Path
55	FSDH	52%	1.6	1.06"
N/A	N/A	N/A	N/A	N/A

Recordable Indication(s): Yes No (If Yes, Ref. Attached Ultrasonic Indication Report.)
 Results: Sat Unsat Eval

Comments: **NO RECORDABLE INDICATIONS.**

Percent Of Coverage Obtained > 90%: 69.26% Reviewed Previous Data: YES

Examiner	Level	Signature	Date	Reviewer	Signature	Date
Mahoney, Patrick V.	II		5/2/2012	George Buck Level III		5/4/2012
Examiner	Level	Signature	Date	Site Review	Signature	Date
N/A	N/A			James Salton		5/5/2012
Other	Level	Signature	Date	ANII Review	Signature	Date
N/A	N/A			Robert Winegarden ANII		5/7/2012



UT Calibration/Examination

Site/Unit: HNP / 1
 Summary No.: H-03000
 Workscope: ISI

Procedure: NDEP-0450
 Procedure Rev.: 4
 Work Order No.: 2050436

Outage No.: RFO-17
 Report No.: UT-12-014
 Page: 3 of 5

Code: 2001 Edition, 2003 Addenda Cat./Item: B-D/B3.110 Location: Containment 302'
 Drawing No.: 1-ISI-PZR-1 Description: Nozzle to Head
 System ID: RC-2050
 Component ID: II-PZR-01NTHW-13 Size/Length: N/A Thickness/Diameter: N/A
 Limitations: CONFIGURATION (SEE SKETCH) Start Time: 1302 Finish Time: 1520

Instrument Settings
 Serial No.: 021063
 Manufacturer: General Electric
 Model: USN 58Lsw Linearity: L-12-001
 Delay: 17.2038 μs Range: 9.281"
 M'tl Cal/Vel: 0.1280"/μs Pulsar Type: Square
 Damping: 500 Ohms Reject: 0%
 PRF: Auto High SU Freq.: 2.25 MHz
 Frequency: 2.25 MHz Rectify: Fullwave
 Voltage: 450 Pulse Width: 220
 Ax. Gain (dB): 40 Circ. Gain (dB): N/A
1 Screen Div. = 0.928 in. of Sound Path

Search Unit
 Serial No.: M20228
 Manufacturer: KB AeroTech
 Size: 0.5" x 1" Model: Gamma
 Freq.: 2.25 MHz Center Freq.: N/A
 Exam Angle: 60° Squint Angle: N/A
 Measured Angle: 63° Mode: SHEAR
 Exit Point: 0.65" # of Elements: 1
 Config.: SINGLE Focus: N/A
 Shape: RECT. Contour: N/A
 Wedge Style: NON INTEGRAL
Search Unit Cable
 Type: RG58 Length: 6' No. Conn.: 0

Cal. Checks	Time	Date
Initial Cal.	1138	5/3/2012
Inter. Cal.	1302	5/3/2012
Inter. Cal.	N/A	
Inter. Cal.	N/A	
Final Cal.	1540	5/3/2012

Couplant
 Cal. Batch: 05325
 Type: Ultragel II
 Mfg.: Sonotech, Inc.
 Exam Batch: 05325
 Type: Ultragel II
 Mfg.: Sonotech, Inc.

Calibration Block
 Cal. Block No.: UT-050-1
 Thickness: 3.50" Dia.: FLAT
 Cal. Blk. Temp.: 85° Temp. Tool: 277510
 Comp. Temp.: 90° Temp. Tool: 277510

Scan Coverage
 Upstream Downstream Scan dB: 52
 CW CCW Scan dB: 52
 Exam Surface: OUTSIDE DIAMETER
 Surface Condition: GROUND FLUSH

Reference Block
 Serial No.: 792221
 Type: CS Rompas

Axial Orientated Search Unit			
Calibration Reflector	Signal Amplitude %	Sweep Division	Sound Path
1/4 T	80%	1.98	1.75"
1/2 T	41%	3.86	3.56"
3/4 T	32%	5.87	5.49
ID	11%	8.0	7.38"
5/4 T	17%	10.0	9.28"

Circumferential Orientated Search Unit			
Calibration Reflector	Signal Amplitude %	Sweep Division	Sound Path
N/A	N/A	N/A	N/A

Reference/Simulator Block				
Gain dB	Reflector	Signal Amplitude %	Sweep Division	Sound Path
41	FSDH	44%	1.6	1.51"
N/A	N/A	N/A	N/A	N/A

Recordable Indication(s): Yes No (If Yes, Ref. Attached Ultrasonic Indication Report.)
 Results: Sat Unsat Eval


Comments: **NO RECORDABLE INDICATIONS.**

Percent Of Coverage Obtained > 90%: 69.26% Reviewed Previous Data: YES

Examiner	Level	Signature	Date	Reviewer	Signature	Date
Mahoney, Patrick V.	II		5/2/2012	George Buck Level III		5/4/2012
Examiner	Level	Signature	Date	Site Review	Signature	Date
N/A	N/A			James Salton		5/5/2012
Other	Level	Signature	Date	ANII Review	Signature	Date
N/A	N/A			Robert Winegarden ANII		5/7/2012

Summary No.: H-03000

Sketch or Photo: Y:\Shared\Ideal\HNP_Data\DataSheet_Info\UT-12-014.jpg

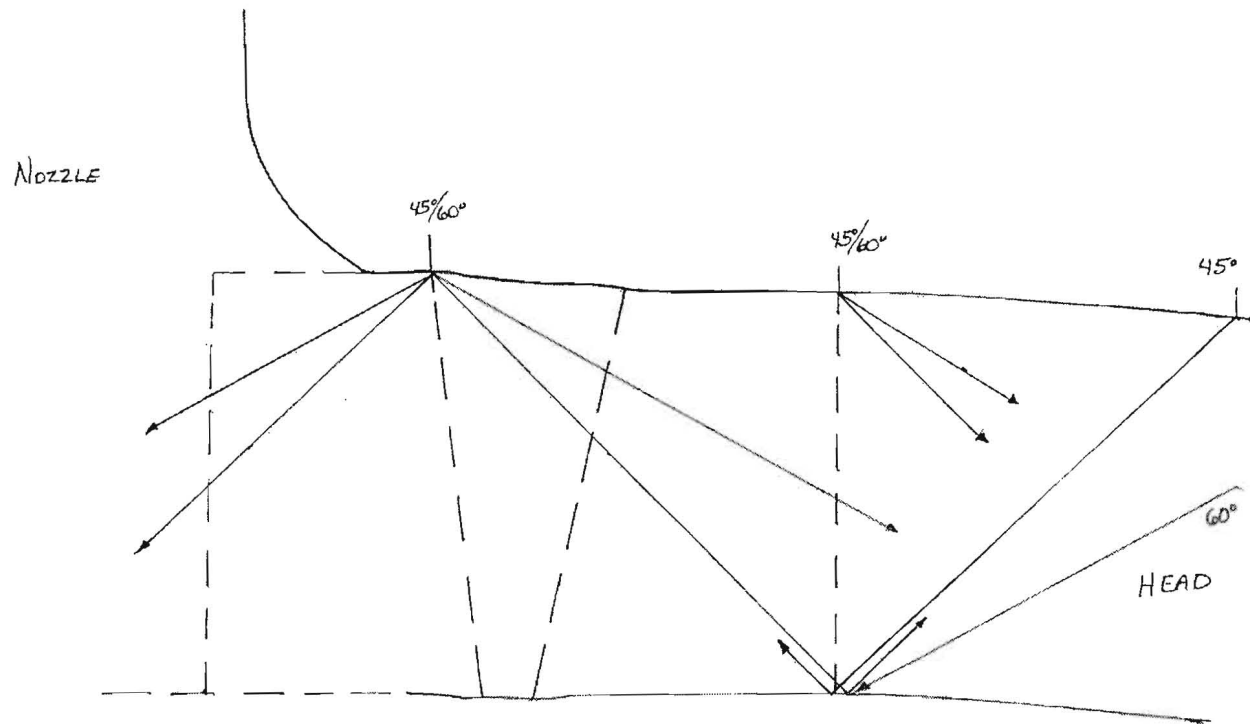

T&C BASED ON PREVIOUS DATA



Determination of Percent Coverage for UT Examinations - Vessels

Site/Unit: <u> HNP </u> / <u> 1 </u>	Procedure: <u> NDEP-0450 </u>	Outage No.: <u> RFO-17 </u>
Summary No.: <u> H-03000 </u>	Procedure Rev.: <u> 4 </u>	Report No.: <u> UT-12-014 </u>
Workscope: <u> ISI </u>	Work Order No.: <u> 2050436 </u>	Page: <u> 5 </u> of <u> 5 </u>

0 deg Planar

Scan 100.000 % Length X 74.700 % volume of length / 100 = 74.700 % total for 0 deg

45 deg

Scan 1 100.000 % Length X 90.900 % volume of length / 100 = 90.900 % total for Scan 1

Scan 2 100.000 % Length X 31.300 % volume of length / 100 = 31.300 % total for Scan 2

Scan 3 100.000 % Length X 74.700 % volume of length / 100 = 74.700 % total for Scan 3

Scan 4 100.000 % Length X 74.700 % volume of length / 100 = 74.700 % total for Scan 4

Add totals and divide by # scans = 67.900 % total for 45 deg

Other deg 60

Scan 1 100.000 % Length X 94.600 % volume of length / 100 = 94.600 % total for Scan 1

Scan 2 100.000 % Length X 16.700 % volume of length / 100 = 16.700 % total for Scan 2

Scan 3 100.000 % Length X 74.700 % volume of length / 100 = 74.700 % total for Scan 3

Scan 4 100.000 % Length X 74.700 % volume of length / 100 = 74.700 % total for Scan 4

Add totals and divide by # scans = 65.175 % total for 60 deg

Percent complete coverage

Add totals for each angle and scan required and divide by # of angles to determine;

 69.258 % Total for complete exam

Note:

Supplemental coverage may be achieved by use of other angles / methods. When used, the coverage for volume not obtained with angles as noted above shall be calculated and added to the total to provide the percent total for the complete examination.

Site Field Supervisor: Edmund Donovan

Date: 5/3/2012

This Document is a QA Record



UT Calibration/Examination

Site/Unit: HNP / 1
 Summary No.: H-02995
 Workscope: ISI

Procedure: NDEP-0450
 Procedure Rev.: 4
 Work Order No.: 2050436

Outage No.: RFO-17
 Report No.: UT-12-015
 Page: 1 of 5

Code: 2001 Edition, 2003 Addenda Cat./Item: B-D/B3.110 Location: Containment 260'
 Drawing No.: 1-ISI-PZR-1 Description: Surge Nozzle to Vessel Weld
 System ID: RC-2050
 Component ID: II-PZR-01NTHW-08 Size/Length: N/A Thickness/Diameter: N/A
 Limitations: CONFIGURATION (SEE SKETCH) Start Time: 1020 Finish Time: 1130

Instrument Settings
 Serial No.: 021063 Manufacturer: General Electric Model: USN 58Lsw Linearity: L-12-001
 Delay: 1.15 µs Range: 5.000" M'tl Cal/Vel: 0.2330"/µs Pulsar Type: Square
 Damping: 500 Ohms Reject: 0% PRF: Auto High SU Freq.: 2.25 MHz
 Frequency: 2.25 MHz Rectify: Fullwave Voltage: 450 Pulse Width: 220
 Ax. Gain (dB): 17 Circ. Gain (dB): N/A
1 Screen Div. = 0.5 in. of Depth

Search Unit
 Serial No.: C29344 Manufacturer: KB AeroTech Size: 0.75" Model: Gamma
 Freq.: 2.25 MHz Center Freq.: N/A Exam Angle: 0° Squint Angle: N/A
 Measured Angle: 0° Mode: LONG. Exit Point: N/A # of Elements: 1
 Config.: SINGLE Focus: N/A Shape: ROUND Contour: N/A
 Wedge Style: INTEGRAL

Search Unit Cable
 Type: RG58 Length: 6' No. Conn.: 0

Cal. Checks	Time	Date
Initial Cal.	0816	5/2/2012
Inter. Cal.	1020	5/2/2012
Inter. Cal.	N/A	
Inter. Cal.	N/A	
Final Cal.	1155	5/2/2012

Couplant
 Cal. Batch: 05325
 Type: Ultragel II
 Mfg.: Sonotech, Inc.
 Exam Batch: 05325
 Type: Ultragel II
 Mfg.: Sonotech, Inc.

Axial Orientated Search Unit			
Calibration Reflector	Signal Amplitude %	Sweep Division	Depth
1/4 T	82%	1.6	0.81"
1/2 T	82%	3.4	1.676"
3/4 T	56%	5.1	2.54"
N/A	N/A	N/A	N/A

Circumferential Orientated Search Unit			
Calibration Reflector	Signal Amplitude %	Sweep Division	Depth
N/A	N/A	N/A	N/A

Reference/Simulator Block				
Gain dB	Reflector	Signal Amplitude %	Sweep Division	Depth
9	1" BW	81%	2.0	1.01"
N/A	N/A	N/A	N/A	N/A

Calibration Block
 Cal. Block No.: UT-050-1 Thickness: 3.50" Dia.: FLAT
 Cal. Blk. Temp.: 85° Temp. Tool: 277510 Exam Surface: OUTSIDE DIAMETER
 Comp. Temp.: 91° Temp. Tool: 277510 Surface Condition: GROUND FLUSH

Scan Coverage
 Upstream Downstream Scan dB: 40
 CW CCW Scan dB: 40

Recordable Indication(s): Yes No (If Yes, Ref. Attached Ultrasonic Indication Report.)
 Results: Sat Unsat Eval
 Percent Of Coverage Obtained > 90%: 59.1% Reviewed Previous Data: YES

Reference Block
 Serial No.: 792221
 Type: CS Rompas

Comments: **WELD DISCONTINUITIES WERE OBSERVED NEAR RT STAMP #1 BELOW RECORDABLE LEVELS. REFLECTORS WERE VERIFIED NOT TO BE ID CONNECTED OR SERVICE INDUCED. GLB**

Examiner	Level	Signature	Date	Reviewer	Signature	Date
Mahoney, Patrick V.	II		5/2/2012	George Buck Level III		5/4/2012
Examiner	Level	Signature	Date	Site Review	Signature	Date
N/A	N/A			James Salton		5/5/2012
Other	Level	Signature	Date	ANII Review	Signature	Date
N/A	N/A			Robert Winegarden ANII		5/7/2012



UT Calibration/Examination

Site/Unit: HNP / 1 Procedure: NDEP-0450 Outage No.: RFO-17
 Summary No.: H-02995 Procedure Rev.: 4 Report No.: UT-12-015
 Workscope: ISI Work Order No.: 2050436 Page: 2 of 5

Code: 2001 Edition, 2003 Addenda Cat./Item: B-D/B3.110 Location: Containment 260'
 Drawing No.: 1-ISI-PZR-1 Description: Surge Nozzle to Vessel Weld
 System ID: RC-2050
 Component ID: II-PZR-01NTHW-08 Size/Length: N/A Thickness/Diameter: N/A
 Limitations: CONFIGURATION (SEE SKETCH) Start Time: 1020 Finish Time: 1130

Instrument Settings		Search Unit	
Serial No.: <u>021063</u>	Manufacturer: <u>General Electric</u>	Serial No.: <u>C18133</u>	Manufacturer: <u>KB AeroTech</u>
Model: <u>USN 58Lsw</u> Linearity: <u>L-12-001</u>	Delay: <u>12.6941 μs</u> Range: <u>6.400"</u>	Size: <u>0.5" x 1"</u> Model: <u>Gamma</u>	Exam Angle: <u>45°</u> Squint Angle: <u>N/A</u>
M'tl Cal/Vel: <u>0.1280"/μs</u> Pulsar Type: <u>Square</u>	Damping: <u>500 Ohms</u> Reject: <u>0%</u>	Freq.: <u>2.25 MHz</u> Center Freq.: <u>N/A</u>	Measured Angle: <u>45°</u> Mode: <u>SHEAR</u>
PRF: <u>Auto High</u> SU Freq.: <u>2.25 MHz</u>	Frequency: <u>2.25 MHz</u> Rectify: <u>Fullwave</u>	Exit Point: <u>0.65"</u> # of Elements: <u>1</u>	Config.: <u>SINGLE</u> Focus: <u>N/A</u>
Voltage: <u>450</u> Pulse Width: <u>220</u>	Ax. Gain (dB): <u>32.5</u> Circ. Gain (dB): <u>N/A</u>	Shape: <u>RECT.</u> Contour: <u>N/A</u>	Wedge Style: <u>NON INTEGRAL</u>
<u>1</u> Screen Div. = <u>0.640</u> in. of <u>Sound Path</u>	Cal. Block No.: <u>UT-050-1</u>	Search Unit Cable	Scan Coverage
	Thickness: <u>3.50"</u> Dia.: <u>FLAT</u>	Type: <u>RG58</u> Length: <u>6'</u> No. Conn.: <u>0</u>	Upstream <input checked="" type="checkbox"/> Downstream <input checked="" type="checkbox"/> Scan dB: <u>44</u>
	Cal. Blk. Temp.: <u>85°</u> Temp. Tool: <u>277510</u>	Exam Surface: <u>OUTSIDE DIAMETER</u>	CW <input checked="" type="checkbox"/> CCW <input checked="" type="checkbox"/> Scan dB: <u>44</u>
	Comp. Temp.: <u>91°</u> Temp. Tool: <u>277510</u>	Surface Condition: <u>GROUND FLUSH</u>	

Cal. Checks	Time	Date
Initial Cal.	0802	5/2/2012
Inter. Cal.	1035	5/2/2012
Inter. Cal.	N/A	
Inter. Cal.	N/A	
Final Cal.	1157	5/2/2012

Couplant
 Cal. Batch: 05325
 Type: Ultrage II
 Mfg.: Sonotech, Inc.
 Exam Batch: 05325
 Type: Ultrage II
 Mfg.: Sonotech, Inc.

Axial Orientated Search Unit				
Calibration Reflector	Signal Amplitude %	Sweep Division	Sound Path	
1/4 T	80%	1.8	1.18"	
1/2 T	58%	3.7	2.4"	
3/4 T	40%	5.7	3.70"	
ID	22%	8.0	5.11"	
5/4 T	30%	10.0	6.38"	
Circumferential Orientated Search Unit				
Calibration Reflector	Signal Amplitude %	Sweep Division	Sound Path	
N/A	N/A	N/A	N/A	
Reference/Simulator Block				
Gain dB	Reflector	Signal Amplitude %	Sweep Division	Sound Path
55	FSDH	52%	1.6	1.06"
N/A	N/A	N/A	N/A	N/A

Recordable Indication(s): Yes No (If Yes, Ref. Attached Ultrasonic Indication Report.)
 Results: Sat Unsat Eval
 Percent Of Coverage Obtained > 90%: 59.1% Reviewed Previous Data: YES

Comments: SEE PAGE 1 FOR COMMENTS.

Examiner	Level	Signature	Date	Reviewer	Signature	Date
Mahoney, Patrick V.	II		5/2/2012	George Buck Level III		5/4/2012
Examiner	Level	Signature	Date	Site Review	Signature	Date
N/A	N/A			James Salton		5/5/2012
Other	Level	Signature	Date	ANII Review	Signature	Date
N/A	N/A			Robert Winegarden ANII		5/7/2012



UT Calibration/Examination

Site/Unit: HNP / 1
 Summary No.: H-02995
 Workscope: ISI

Procedure: NDEP-0450
 Procedure Rev.: 4
 Work Order No.: 2050436

Outage No.: RFO-17
 Report No.: UT-12-015
 Page: 3 of 5

Code: 2001 Edition, 2003 Addenda Cat./Item: B-D/B3.110 Location: Containment 260'
 Drawing No.: 1-ISI-PZR-1 Description: Surge Nozzle to Vessel Weld
 System ID: RC-2050
 Component ID: II-PZR-01NTHW-08 Size/Length: N/A Thickness/Diameter: N/A
 Limitations: CONFIGURATION (SEE SKETCH) Start Time: 1020 Finish Time: 1130

Instrument Settings
 Serial No.: 021063 Manufacturer: General Electric Model: USN 58Lsw Linearity: L-12-001
 Delay: 17.2038 μs Range: 9.281" M'tl Cal/Vel: 0.1280"/μs Pulsar Type: Square
 Damping: 500 Ohms Reject: 0% PRF: Auto High SU Freq.: 2.25 MHz
 Frequency: 2.25 MHz Rectify: Fullwave Voltage: 450 Pulse Width: 220
 Ax. Gain (dB): 40 Circ. Gain (dB): N/A
1 Screen Div. = 0.928 in. of Sound Path

Search Unit
 Serial No.: M20228 Manufacturer: KB AeroTech Size: 0.5" x 1" Model: Gamma
 Freq.: 2.25 MHz Center Freq.: N/A Exam Angle: 60° Squint Angle: N/A
 Measured Angle: 63° Mode: SHEAR Exit Point: 0.65" # of Elements: 1
 Config.: SINGLE Focus: N/A Shape: RECT. Contour: N/A
 Wedge Style: NON INTEGRAL

Search Unit Cable
 Type: RG58 Length: 6' No. Conn.: 0

Scan Coverage
 Upstream Downstream Scan dB: 50
 CW CCW Scan dB: 50
 Exam Surface: OUTSIDE DIAMETER
 Surface Condition: GROUND FLUSH

Calibration Block
 Cal. Block No.: UT-050-1 Thickness: 3.50" Dia.: FLAT
 Cal. Blk. Temp.: 85° Temp. Tool: 277510
 Comp. Temp.: 91° Temp. Tool: 277510

Recordable Indication(s): Yes No (If Yes, Ref. Attached Ultrasonic Indication Report.)
 Results: Sat Unsat Eval

Percent Of Coverage Obtained > 90%: 59.1% Reviewed Previous Data: YES

Cal. Checks	Time	Date
Initial Cal.	0809	5/2/2012
Inter. Cal.	1105	5/2/2012
Inter. Cal.	N/A	
Inter. Cal.	N/A	
Final Cal.	1201	5/2/2012

Couplant
 Cal. Batch: 05325
 Type: Ultragel II
 Mfg.: Sonotech, Inc.
 Exam Batch: 05325
 Type: Ultragel II
 Mfg.: Sonotech, Inc.

Axial Orientated Search Unit			
Calibration Reflector	Signal Amplitude %	Sweep Division	Sound Path
1/4 T	80%	1.98	1.75"
1/2 T	41%	3.86	3.56"
3/4 T	32%	5.87	5.49
ID	11%	8.0	7.38"
5/4 T	17%	10.0	9.28"

Circumferential Orientated Search Unit			
Calibration Reflector	Signal Amplitude %	Sweep Division	Sound Path
N/A	N/A	N/A	N/A

Reference/Simulator Block				
Gain dB	Reflector	Signal Amplitude %	Sweep Division	Sound Path
41	FSDH	44%	1.6	1.51"
N/A	N/A	N/A	N/A	N/A


Reference Block
 Serial No.: 792221
 Type: CS Rompas

Comments: **SEE PAGE 1 FOR COMMENTS.**

Examiner	Level	Signature	Date	Reviewer	Signature	Date
Mahoney, Patrick V.	II	<i>Patrick Mahoney</i>	5/2/2012	George Buck Level III	<i>George Buck</i>	5/4/2012
Examiner	Level	Signature	Date	Site Review	Signature	Date
N/A	N/A			James Salton	<i>James Salton</i>	5/5/2012
Other	Level	Signature	Date	ANII Review	Signature	Date
N/A	N/A			Robert Winegarden ANII	<i>Robert Winegarden</i>	5/7/2012

Summary No.: H-02995

Sketch or Photo: Y:\Shared\Ideal\HNP_Data\DataSheet_Info\UT-12-015.jpg

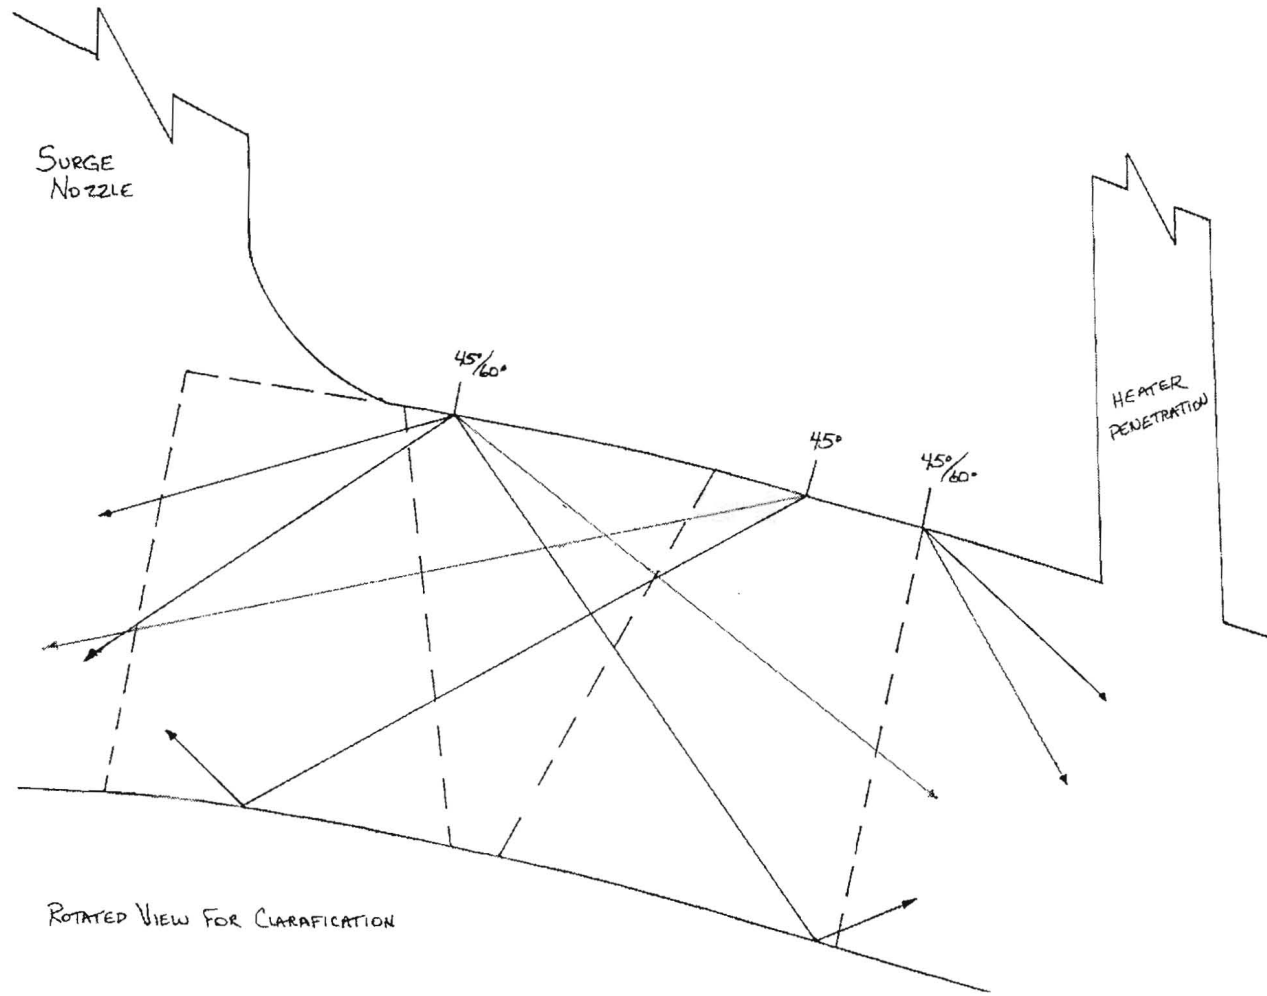



Determination of Percent Coverage for UT Examinations - Vessels

Site/Unit: <u>HNP / 1</u>	Procedure: <u>NDEP-0450</u>	Outage No.: <u>RFO-17</u>
Summary No.: <u>H-02995</u>	Procedure Rev.: <u>4</u>	Report No.: <u>UT-12-015</u>
Workscope: <u>ISI</u>	Work Order No.: <u>2050436</u>	Page: <u>5</u> of <u>5</u>

0 deg Planar

Scan 100.000 % Length X 73.000 % volume of length / 100 = 73.000 % total for 0 deg

45 deg

Scan 1 100.000 % Length X 44.000 % volume of length / 100 = 44.000 % total for Scan 1

Scan 2 100.000 % Length X 43.000 % volume of length / 100 = 43.000 % total for Scan 2

Scan 3 100.000 % Length X 73.000 % volume of length / 100 = 73.000 % total for Scan 3

Scan 4 100.000 % Length X 73.000 % volume of length / 100 = 73.000 % total for Scan 4

Add totals and divide by # scans = 58.250 % total for 45 deg

Other deg 60

Scan 1 100.000 % Length X 21.100 % volume of length / 100 = 21.100 % total for Scan 1

Scan 2 100.000 % Length X 16.900 % volume of length / 100 = 16.900 % total for Scan 2

Scan 3 100.000 % Length X 73.000 % volume of length / 100 = 73.000 % total for Scan 3

Scan 4 100.000 % Length X 73.000 % volume of length / 100 = 73.000 % total for Scan 4

Add totals and divide by # scans = 46.000 % total for 60 deg

Percent complete coverage

Add totals for each angle and scan required and divide by # of angles to determine;

59.083 % Total for complete exam

Note:

Supplemental coverage may be achieved by use of other angles / methods. When used, the coverage for volume not obtained with angles as noted above shall be calculated and added to the total to provide the percent total for the complete examination.

Site Field Supervisor: Edmund Donovan

Date: 5/2/2012

This Document is a QA Record



UT Calibration Examination

Site/Unit: HNP / 1
 Summary No.: H-03713
 Workscope: ISI

Procedure: NDEP-0448
 Procedure Rev.: 3
 Work Order No.: 1313525

Outage No.: RFO-15
 Report No.: UT-09-016
 Page: 1 of 4

Code: 2001 Ed 2003 Add Cat./Item: C-A/C1.10 Location: RAB 236'
 Drawing No.: 1-ISI-RHR-1 Description: Circumferential Shell Weld
 System ID: RH-2085
 Component ID: II-RHR-01RHRA-CSW-02A,B,C Size/Length: 123.25" Thickness/Diameter: .800"/39.2"
 Limitations: None Start Time: 1315 Finish Time: 1545

Instrument Settings
 Serial No.: 0134D2 Manufacturer: Krautkramer Branson Model: USN-58L
 Delay: 6.1419 Range: 5" M'tl Cal/Vel: 0.1237 Pulser: Single Damping: 1000 Ω Reject: 0% Rep. Rate: High Freq.: 2.25 MHz Filter: N/A Mode: Shear Wave Voltage: N/A Other: Full Wave
 Ax. Gain (dB): 31.7 Circ. Gain (dB): 31.7
 10 Screen Div. = 5 in. of Sound Path
 Linearity Report No.: L-09-001

Search Unit
 Serial No.: 00WMYL Manufacturer: KBA Size: 0.5 Shape: Round Freq.: 2.25 MHz Style: Composite Exam Angle: 45° # of Elements: Single Mode: Shear Wave Measured Angle: 46° Wedge Style: MSWQC
 Search Unit Cable Type: RG-174 Length: 6' No. Conn.: 0

Cal. Checks	Time	Date
Initial Cal.	1315	4/6/2009
Inter. Cal.		
Inter. Cal.		
Inter. Cal.		
Final Cal.	1545	4/6/2009

Couplant
 Cal. Batch: 05225
 Type: Ultragel II
 Mfg.: Sonotech, Inc.
 Exam Batch: 05225
 Type: Ultragel II
 Mfg.: Sonotech, Inc.

Axial Orientated Search Unit			
Calibration Reflector	Signal Amplitude %	Sweep Division	Sound Path
1" ID Notch	82%	3	1.47"

Circumferential Orientated Search Unit			
Calibration Reflector	Signal Amplitude %	Sweep Division	Sound Path
1" ID Notch	82%	3	1.47"

Calibration Block
 Cal. Block No.: CPL-77 Thickness: 1.00" Dia.: Flat Cal. Blk. Temp. 74° Temp. Tool: 68951 Comp. Temp.: 72° Temp. Tool: 68951
 Upstream Downstream Scan dB: N/A CW CCW Scan dB: 37.7
 Exam Surface: OD Surface Condition: GROUND SMOOTH
 Recordable Indication(s): Yes No (If Yes, Ref. Attached Ultrasonic Indication Report.)

Reference Block
 Serial No.: 86-3248
 Type: SS Rompas

Reference/Simulator Block				
Gain dB	Reflector	Signal Amplitude %	Sweep Division	Sound Path
44.7	SDH	85%	2.2	1.1"

Results: Sat Unsat Eval
 Percent Of Coverage Obtained > 90%: 75% Reviewed Previous Data: Yes

Comments: **Also scanned 12" of weld # 3. Calibration Block conforms to ASME XI, Appx I, Supp 3(b)(3); Appx III Fig. III-3230-1, Note 2; III-3410; III-3430; III, Supp 1(b)(3); and NDEP-0448**

Examiner	Level	II-PDI	Signature	Date	Reviewer	Signature	Date
Malia, Mark E.			<i>Mark & Malia</i>	4/6/2009	Damon Priestley PGN Lv III	<i>DP</i>	4/29/2009
Examiner	Level	N/A	Signature	Date	Site Review	Signature	Date
N/A					Scott Larson Level III	<i>Scott Larson</i>	4/29/2009
Other	Level	III-PDI	Signature	Date	ANII Review	Signature	Date
Dugan, Michael P			<i>Shw. Dugan</i>	4/14/2009	Nancy Ritchie-Slaughter	<i>Nancy Ritchie-Slaughter</i>	5/4/09



UT Calibration Examination

Site/Unit: HNP / 1
 Summary No.: H-03713
 Workscope: ISI

Procedure: NDEP-0448
 Procedure Rev.: 3
 Work Order No.: 1313525

Outage No.: RFO-15
 Report No.: UT-09-016
 Page: 2 of 4

Code: 2001 Ed 2003 Add Cat./Item: C-A/C1.10 Location: RAB 236'

Drawing No.: 1-ISI-RHR-1 Description: Circumferential Shell Weld

System ID: RH-2085

Component ID: II-RHR-01RHRA-CSW-02A,B,C Size/Length: 123.25" Thickness/Diameter: .800"/39.2"

Limitations: Axial scan limited to shell side only. Start Time: 1300 Finish Time: 1530

Instrument Settings
 Serial No.: 0134D2
 Manufacturer: Krautkramer Branson
 Model: USN-58L
 Delay: 6.1419 Range: 5"
 M'tl Cal/Vel: 0.1237 Pulser: Single
 Damping: 1000 Ω Reject: 0%
 Rep. Rate: High Freq.: 2.25 MHz
 Filter: N/A Mode: Shear Wave
 Voltage: N/A Other: Full Wave
 Ax. Gain (dB): 47 Circ. Gain (dB): 47
10 Screen Div. = 5 in. of Sound Path
 Linearity Report No.: L-09-001

Search Unit
 Serial No.: 00WPMD
 Manufacturer: KBA
 Size: .5" Shape: Round
 Freq.: 2.25 MHz Style: Comp-G
 Exam Angle: 60 # of Elements: 1
 Mode: Shear Wave
 Measured Angle: 60
 Wedge Style: MSWQC
Search Unit Cable
 Type: RG-174
 Length: 6' No. Conn.: 0

Cal. Checks	Time	Date
Initial Cal.	1300	4/6/2009
Inter. Cal.		
Inter. Cal.		
Inter. Cal.		
Final Cal.	1530	4/6/2009

Couplant
 Cal. Batch: 05225
 Type: Ultragel II
 Mfg.: Sonotech, Inc.
 Exam Batch: 05225
 Type: Ultragel II
 Mfg.: Sonotech, Inc.

Axial Orientated Search Unit			
Calibration Reflector	Signal Amplitude %	Sweep Division	Sound Path
1" Notch	82%	3.8	1.873"

Circumferential Orientated Search Unit			
Calibration Reflector	Signal Amplitude %	Sweep Division	Sound Path
N/A	N/A	N/A	N/A

Reference Block
 Serial No.: 86-3248
 Type: SS Rompas

Reference/Simulator Block				
Gain dB	Reflector	Signal Amplitude %	Sweep Division	Sound Path
41	SDH	70%	3.1	1.547

Calibration Block
 Cal. Block No.: CPL-77
 Thickness: 1.0" Dia.: Flat
 Cal. Blk. Temp. 74 Temp. Tool: 68951
 Comp. Temp.: 72 Temp. Tool: 68951

Scan Coverage
 Upstream Downstream Scan dB: 59
 CW CCW Scan dB:
 Exam Surface: OD
 Surface Condition: GROUND SMOOTH

Recordable Indication(s): Yes No (If Yes, Ref. Attached Ultrasonic Indication Report.)

Results: Sat Unsat Eval

Percent Of Coverage Obtained > 90%: 75% Reviewed Previous Data: Yes

Comments: **Also scanned 12" of weld # 3. Calibration Block conforms to ASME XI, Appx I, Supp 3(b)(3); Appx III Fig. III-3230-1, Note 2; III-3410; III-3430; III, Supp 1(b)(3); and NDEP-0448**

Examiner	Level	Signature	Date	Reviewer	Signature	Date
Malia, Mark E.	II-PDI	<i>Mark E Malia</i>	4/6/2009	Damon Priestley PGN Lv III	<i>Damon Priestley</i>	4/29/2009
N/A	N/A			Scott Larson Level III	<i>Scott Larson</i>	4/29/2009
Dugan, Michael P	III-PDI	<i>Michael P Dugan</i>	4/29/2009	Nancy Ritchie-Slaughter	<i>Nancy Ritchie-Slaughter</i>	5/4/09

This Document is a QA Record



UT Calibration Examination

Site/Unit: HNP / 1
 Summary No.: H-03713
 Workscope: ISI

Procedure: NDEP-0448
 Procedure Rev.: 3
 Work Order No.: 1313525

Outage No.: RFO-15
 Report No.: UT-09-016
 Page: 3 of 4

Code: 2001 Ed 2003 Add Cat./Item: C-A/C1.10 Location: RAB 236'
 Drawing No.: 1-ISI-RHR-1 Description: Circumferential Shell Weld
 System ID: RH-2085
 Component ID: II-RHR-01RHRA-CSW-02A,B,C Size/Length: 123.25" Thickness/Diameter: .800"/39.2"
 Limitations: Single Sided- Shell Side Only Start Time: 0830 Finish Time: 1140

Instrument Settings
 Serial No.: 0134L4
 Manufacturer: Krautkramer Branson
 Model: USN-58L
 Delay: 9.5431 Range: 5.00"
 M'tl Cal/Vel: .2390 Pulsar: Auto High
 Damping: 500 Ω Reject: 0%
 Rep. Rate: 255 MHz Freq.: 2
 Filter: N/A Mode: Dual
 Voltage: N/A Other: Full Wave
 Ax. Gain (dB): 70.8 Circ. Gain (dB): N/A
10 Screen Div. = 5 in. of Sound Path
 Linearity Report No.: L-09-002

Search Unit
 Serial No.: 90-575
 Manufacturer: RTD
 Size: 2-8 x 14mm Shape: Rect.
 Freq.: 2.0 MHz Style: TRL2-Aust
 Exam Angle: 70° # of Elements: Dual
 Mode: Long.
 Measured Angle: 70°
 Wedge Style: Integral
Search Unit Cable
 Type: RG-174
 Length: 6' x 2 No. Conn.: 0

Cal. Checks	Time	Date
Initial Cal.	0830	4/7/2009
Inter. Cal.		
Inter. Cal.		
Final Cal.	1140	4/7/2009

Couplant
 Cal. Batch: 01125
 Type: Ultragel II
 Mfg.: Sonotech
 Exam Batch: 01125
 Type: Ultragel II
 Mfg.: Sonotech

Reference Block
 Serial No.: 86-3248
 Type: SS Rompas

Axial Orientated Search Unit			
Calibration Reflector	Signal Amplitude %	Sweep Division	Sound Path
1" ID Notch	80%	5.8	2.944"

Circumferential Orientated Search Unit			
Calibration Reflector	Signal Amplitude %	Sweep Division	Sound Path
N/A	N/A	N/A	N/A

Reference/Simulator Block				
Gain dB	Reflector	Signal Amplitude %	Sweep Division	Sound Path
N/A	N/A	N/A	N/A	N/A

Calibration Block
 Cal. Block No.: CPL-77
 Thickness: 1.00" Dia.: Flat
 Cal. Blk. Temp. 72° Temp. Tool: 68951
 Comp. Temp.: 70° Temp. Tool: 68951

Scan Coverage
 Upstream Downstream Scan dB: 70.8
 CW CCW Scan dB: N/A
 Exam Surface: OD
 Surface Condition: GROUND

Recordable Indication(s): Yes No (If Yes, Ref. Attached Ultrasonic Indication Report.)

Results: Sat Unsat Eval

Percent Of Coverage Obtained > 90%: 75% Reviewed Previous Data: Yes

Comments: Supplemental 70° RL. Far side of austenitic weld examined IAW NDEP-0425 Rev 8. However, code coverage is not claimed beyond weld centerline.

Examiner	Level	Signature	Date	Reviewer	Signature	Date
Dugan, Michael P	III-PDI	<i>[Signature]</i>	4/7/2009	Damon Priestley PGN Lv III	<i>[Signature]</i>	4/29/2009
N/A	N/A			Site Review Scott Larson Level III	<i>[Signature]</i>	4/29/2009
N/A	N/A			ANII Review Nancy Ritchie-Slaughter	<i>[Signature]</i>	5/4/09

Summary No.: H-03713

Examiner: <u>Malia, Mark E.</u> <i>MEM</i>	Level: <u>II-PDI</u>	Reviewer: <u>Damon Priestley PGN Lv III</u> <i>DP</i>	Date: <u>4/29/2009</u>
Examiner: <u>N/A</u>	Level: <u>N/A</u>	Site Review: <u>Scott Larson Level III</u> <i>SL</i>	Date: <u>4/29/2009</u>
Other: <u>Dugan, Michael P</u>	Level: <u>III-PDI</u>	ANII Review: <u>Nancy Ritchie-Slaughter</u> <i>RS</i>	Date: <u>5/4/09</u>

Comments:

Determination of Percent Coverage for UT Examination

Angle: 45°

Circumferential CW: 100% of length X 100% of volume = 100% of scan complete
Circumferential CCW: 100% of length X 100% of volume = 100% of scan complete

Angle: 60°

Axial US: 100% of length X 100% of volume = 100% of scan complete
Axial DS: 0% of length X 0% of volume = 0% of scan complete

100% Circumferential CW + 100% Circumferential CCW + 100% Axial US + 0% Axial DS = 300
300 / 4 = 75% Total Coverage



UT Calibration/Examination

Site/Unit: HNP / 1
 Summary No.: H-01354
 Workscope: ISI

Procedure: NDEP-0450
 Procedure Rev.: 5
 Work Order No.: 13540520

Outage No.: RFO-20
 Report No.: UT-16-001
 Page: 1 of 12

Code: 2001 Ed 2003 Add Cat./Item: C-B/C2.21 Location: RAB 216'
 Drawing No.: 1-ISI-BIT-1 Description: Inlet Nozzle to Head Weld
 System ID: SI-2080
 Component ID: II-BIT-01NTHW-04 Size/Length: N/A Thickness/Diameter: SS / 2.0"
 Limitations: Yes - Due to nozzle configuration Start Time: 1108 Finish Time: 1131

Instrument Settings
 Serial No.: 15A024PE Manufacturer: GE Model: USN60sw Linearity: L-16-011 Delay: 8.7403 Range: 5.0" M'tl Cal/Vel: 0.1230 Pulsar Type: Square Damping: 500 Ohms Reject: 0% PRF: Auto High SU Freq.: 1.5 MHz Frequency: 2.0 MHz Rectify: Fullwave Voltage: 450 Pulse Width: 330
 Ax. Gain (dB): 27.4 Circ. Gain (dB): 27.4
1 Screen Div. = .5 in. of Sound Path

Search Unit
 Serial No.: 011CXD Manufacturer: KBA Size: 0.375" Model: Comp - G Freq.: 1.5 MHz Center Freq.: N/A Exam Angle: 45 Squint Angle: N/A Measured Angle: 45 Mode: Shear Exit Point: 0.4" # of Elements: 1 Config.: Single Focus: N/A Shape: Round Contour: Flat Wedge Style: MSWQC

Cal. Checks	Time	Date
Initial Cal.	0820	10/4/2016
Inter. Cal.	N/A	
Inter. Cal.	1107	10/4/2016
Inter. Cal.	N/A	
Final Cal.	1359	10/4/2016

Couplant
 Cal. Batch: 15B080 Type: Ultragel II Mfg.: Magnaflux
 Exam Batch: 15B080 Type: Ultragel II Mfg.: Magnaflux

Axial Oriented Search Unit			
Calibration Reflector	Signal Amplitude %	Sweep Division	Sound Path
1/4T SDH	80	2.0	0.968"
1/2T SDH	40	4.0	2.0"
3/4T SDH	20	6.0	2.97"
5/4T SDH	12	10.0	4.96"

Circumferential Oriented Search Unit			
Calibration Reflector	Signal Amplitude %	Sweep Division	Sound Path
See Axial			

Calibration Block
 Cal. Block No.: 16C-087 Thickness: 3.04 Dia.: Flat Cal. Blk. Temp.: 74 Temp. Tool: G502480 Comp. Temp.: 79 Temp. Tool: G502480
 Scan Coverage
 Upstream Downstream Scan dB: 33.4
 CW CCW Scan dB: 33.4
 Exam Surface: O.D. Surface Condition: Ground Smooth
 Recordable Indication(s): Yes No (If Yes, Ref. Attached Ultrasonic Indication Report.)
 Results: Sat Unsat Eval NCR # 02067721
 Percent Of Coverage Obtained > 90%: No - 76.5% Reviewed Previous Data: No

Reference Block
 Serial No.: 15-2377 Type: ROMPAS

Reference/Simulator Block				
Gain dB	Reflector	Signal Amplitude %	Sweep Division	Sound Path
27.4	FSDH	20	2.0	1.0"

Comments: N/A

Examiner	Level	Signature	Date	Reviewer	Signature	Date
Schmalz, Matthew W.	II-N		10/4/2016	D.R. King, UT Level III		10/20/16
Rush, J. Scott	II-N		10/4/2016	Angela Staller		10/21/16
Other	Level	Signature	Date	ANII Review	Signature	Date
N/A	N/A			Nancy Ritchie-Slaughter		10/23/16



UT Calibration/Examination

Site/Unit: HNP / 1
 Summary No.: H-01354
 Workscope: ISI

Procedure: NDEP-0450
 Procedure Rev.: 5
 Work Order No.: 13540520

Outage No.: RFO-20
 Report No.: UT-16-001
 Page: 2 of 12

Code: 2001 Ed 2003 Add Cat./Item: C-B/C2.21 Location: RAB 216'
 Drawing No.: 1-ISI-BIT-1 Description: Inlet Nozzle to Head Weld
 System ID: SI-2080
 Component ID: II-BIT-01NTHW-04 Size/Length: N/A Thickness/Diameter: SS / 2.0"
 Limitations: Yes - Due to nozzle configuration Start Time: 1148 Finish Time: 1154

Instrument Settings
 Serial No.: 15A024PE Manufacturer: GE Model: USN60sw Linearity: L-16-011
 Delay: 9.7821 Range: 5.0" M'fl Cal/Vel: 0.2280 Pulser Type: Square
 Damping: 500 Ohms Reject: 0% PRF: Auto High SU Freq.: 2.0 MHZ
 Frequency: 2.0 MHZ Rectify: Fullwave Voltage: 450 Pulse Width: 250
 Ax. Gain (dB): 39.6 Circ. Gain (dB): N/A
1 Screen Div. = .5 in. of Sound Path

Search Unit
 Serial No.: 03-780 Manufacturer: RTD Size: 2(15x25) Model: TRL2
 Freq.: 2.0 MHZ Center Freq.: N/A Exam Angle: 45 Squint Angle: 10
 Measured Angle: 45 Mode: Long. Exit Point: 0.6" # of Elements: 2
 Config.: Dual Focus: FS-55 Shape: Rect. Contour: Flat
 Wedge Style: Integral

Search Unit Cable
 Type: RG174 Length: 6' No. Conn.: 0

Cal. Checks	Time	Date
Initial Cal.	0840	10/4/2016
Inter. Cal.	N/A	
Inter. Cal.	1147	10/4/2016
Inter. Cal.	N/A	
Final Cal.	1409	10/4/2016

Couplant
 Cal. Batch: 15B080
 Type: Ultragel II
 Mfg.: Magnaflux
 Exam Batch: 15B080
 Type: Ultragel II
 Mfg.: Magnaflux

Axial Oriented Search Unit			
Calibration Reflector	Signal Amplitude %	Sweep Division	Sound Path
ID Notch	80	8.4	4.19"

Circumferential Oriented Search Unit			
Calibration Reflector	Signal Amplitude %	Sweep Division	Sound Path
N/A			

Calibration Block
 Cal. Block No.: 16C-087 Thickness: 3.04" Dia.: Flat
 Cal. Blk. Temp.: 74 Temp. Tool: G502480
 Comp. Temp.: 79 Temp. Tool: G502480
 Exam Surface: O.D.
 Surface Condition: Ground Smooth

Scan Coverage
 Upstream Downstream Scan dB: 45.6
 CW CCW Scan dB: N/A

Reference Block
 Serial No.: 15-2377
 Type: ROMPAS

Reference/Simulator Block				
Gain dB	Reflector	Signal Amplitude %	Sweep Division	Sound Path
24.2	2" Radius	80	4.0	2.0"

Recordable Indication(s): Yes No (If Yes, Ref. Attached Ultrasonic Indication Report.)
 Results: Sat Unsat Eval

Comments: L-wave verified in accordance with AD-NE-ALL-1103.

Percent Of Coverage Obtained > 90%: No - 78.6% Reviewed Previous Data: No

Examiner	Level	Signature	Date	Reviewer	Signature	Date
Schmalz, Matthew W.	II-N		10/4/2016	D.B. King, UT Level III		10/20/16
Rush, J. Scott	II-N		10/4/2016	Angela Staller		10/21/16
N/A	N/A			Nancy Ritchie-Slaughter		10/23/16



UT Calibration/Examination

Site/Unit: HNP / 1
 Summary No.: H-01354
 Workscope: ISI

Procedure: NDEP-0450
 Procedure Rev.: 5
 Work Order No.: 13540520

Outage No.: RFO-20
 Report No.: UT-16-001
 Page: 3 of 12

Code: 2001 Ed 2003 Add Cat./Item: C-B/C2.21 Location: RAB 216'
 Drawing No.: 1-ISI-BIT-1 Description: Inlet Nozzle to Head Weld
 System ID: SI-2080
 Component ID: II-BIT-01NTHW-04 Size/Length: N/A Thickness/Diameter: SS / 2.0"
 Limitations: Yes - Due to nozzle configuration Start Time: 1158 Finish Time: 1204

Instrument Settings
 Serial No.: 15A024PE Manufacturer: GE Model: USN60sw Linearity: L-16-011
 Delay: 12.1762 Range: 10.0" M'l Cal/Vel: 0.228 Pulser Type: Square
 Damping: 500 Ohms Reject: 0% PRF: Auto High SU Freq.: 2.0 MHZ
 Frequency: 2.0 MHZ Rectify: Fullwave Voltage: 450 Pulse Width: 250
 Ax. Gain (dB): 51.2 Circ. Gain (dB): N/A
1 Screen Div. = 1.0 in. of Sound Path

Search Unit
 Serial No.: 03-794 Manufacturer: RTD Size: 2(20x34) Model: TRL2
 Freq.: 2.0 MHZ Center Freq.: N/A Exam Angle: 60 Squint Angle: 3
 Measured Angle: 60 Mode: Long. Exit Point: 0.7" # of Elements: 2
 Config.: Dual Focus: FS-105 Shape: Rect. Contour: Flat
 Wedge Style: Integral

Search Unit Cable
 Type: RG174 Length: 6' No. Conn.: 0

Cal. Checks	Time	Date
Initial Cal.	0846	10/4/2016
Inter. Cal.	N/A	
Inter. Cal.	1157	10/4/2016
Inter. Cal.	N/A	
Final Cal.	1413	10/4/2016

Couplant
 Cal. Batch: 15B080
 Type: Ultrage II
 Mfg.: Magnaflux
 Exam Batch: 15B080
 Type: Ultrage II
 Mfg.: Magnaflux

Axial Oriented Search Unit			
Calibration Reflector	Signal Amplitude %	Sweep Division	Sound Path
ID Notch	80	5.8	5.85"

Circumferential Oriented Search Unit			
Calibration Reflector	Signal Amplitude %	Sweep Division	Sound Path
N/A			

Reference Block
 Serial No.: 15-2377
 Type: ROMPAS

Reference/Simulator Block				
Gain dB	Reflector	Signal Amplitude %	Sweep Division	Sound Path
51.2	FSDH	58	1.4	1.41"

Calibration Block
 Cal. Block No.: 16C-087 Thickness: 3.04" Dia.: Flat
 Cal. Blk. Temp.: 74 Temp. Tool: G502480 Exam Surface: O.D.
 Comp. Temp.: 79 Temp. Tool: G502480 Surface Condition: Ground Smooth

Scan Coverage
 Upstream Downstream Scan dB: 57.2
 CW CCW Scan dB: N/A

Recordable Indication(s): Yes No (If Yes, Ref. Attached Ultrasonic Indication Report.)
 Results: Sat Unsat Eval

Percent Of Coverage Obtained > 90%: No - 78.6% Reviewed Previous Data: No

Comments: L-wave verified in accordance with AD-NE-ALL-1103. Acoustic interface noted 360° intermittently.

Examiner	Level	Signature	Date	Reviewer	Signature	Date
Schmalz, Matthew W.	II-N		10/4/2016	D.B. King, UT Level III		10/20/16
Rush, J. Scott	II-N		10/4/2016	Angela Staller		10/21/16
N/A	N/A			Nancy Ritchie-Slaughter		10/23/16



UT Calibration/Examination

Site/Unit: HNP / 1
 Summary No.: H-01354
 Workscope: ISI

Procedure: NDEP-0450
 Procedure Rev.: 5
 Work Order No.: 13540520

Outage No.: RFO-20
 Report No.: UT-16-001
 Page: 4 of 12

Code: 2001 Ed 2003 Add Cat./Item: C-B/C2.21 Location: RAB 216'
 Drawing No.: 1-ISI-BIT-1 Description: Inlet Nozzle to Head Weld
 System ID: SI-2080
 Component ID: II-BIT-01NTHW-04 Size/Length: N/A Thickness/Diameter: SS / 2.0"
 Limitations: Yes - Due to nozzle configuration Start Time: 1135 Finish Time: 1144

Instrument Settings
 Serial No.: 15A024PE Manufacturer: GE Model: USN60sw Linearity: L-16-011
 Delay: 10.1525 Range: 6.0" M'tl Cal/Vel: 0.1228 Pulser Type: Square
 Damping: 500 Ohms Reject: 0% PRF: Auto High SU Freq.: 2.25 MHz
 Frequency: 2.25 MHz Rectify: Fullwave Voltage: 450 Pulse Width: 220
 Ax. Gain (dB): 50.0 Circ. Gain (dB): N/A
1 Screen Div. = .6 in. of Sound Path

Search Unit
 Serial No.: 01F62L Manufacturer: KBA Size: 0.375" Model: Comp - G
 Freq.: 2.25 MHz Center Freq.: N/A Exam Angle: 60 Squint Angle: N/A
 Measured Angle: 60 Mode: Shear Exit Point: 0.45" # of Elements: 1
 Config.: Single Focus: N/A Shape: Round Contour: Flat
 Wedge Style: MSWQC

Search Unit Cable
 Type: RG174 Length: 6' No. Conn.: 0

Scan Coverage
 Upstream Downstream Scan dB: 56.0
 CW CCW Scan dB: N/A
 Exam Surface: O.D. Surface Condition: Ground Smooth

Calibration Block
 Cal. Block No.: 16C-087 Thickness: 3.04" Dia.: Flat
 Cal. Blk. Temp.: 74 Temp. Tool: G502480
 Comp. Temp.: 79 Temp. Tool: G502480

Recordable Indication(s): Yes No (If Yes, Ref. Attached Ultrasonic Indication Report.)
 Results: Sat Unsat Eval

Cal. Checks	Time	Date
Initial Cal.	0835	10/4/2016
Inter. Cal.	N/A	
Inter. Cal.	1134	10/4/2016
Inter. Cal.	N/A	
Final Cal.	1404	10/4/2016

Couplant
 Cal. Batch: 15B080
 Type: Ultrage II
 Mfg.: Magnaflux
 Exam Batch: 15B080
 Type: Ultrage II
 Mfg.: Magnaflux

Axial Oriented Search Unit				
Calibration Reflector	Signal Amplitude %	Sweep Division	Sound Path	
1/4T SDH	100	2.2	1.36"	
1/2T SDH	60	4.9	2.93"	
3/4T SDH	30	7.8	4.68"	
Circumferential Oriented Search Unit				
Calibration Reflector	Signal Amplitude %	Sweep Division	Sound Path	
N/A				
Reference/Simulator Block				
Gain dB	Reflector	Signal Amplitude %	Sweep Division	Sound Path
50	FSDH	60	2.4	1.409"

Comments: Acoustic interface seen intermittently 360°.

Percent Of Coverage Obtained > 90%: No - 78.6% Reviewed Previous Data: No

Examiner	Level	Signature	Date	Reviewer	Signature	Date
Schmalz, Matthew W.	II-N		10/4/2016	D.B. King, UT Level III		10/20/16
Rush, J. Scott	II-N		10/4/2016	Angela Staller		10/21/16
N/A	N/A			Nancy Ritchie-Slaughter		10/23/16



UT Calibration/Examination

Site/Unit: HNP / 1
 Summary No.: H-01354
 Workscope: ISI

Procedure: NDEP-0408
 Procedure Rev.: 14
 Work Order No.: 13540520

Outage No.: RFO-20
 Report No.: UT-16-001
 Page: 5 of 12

Code: 2001 Ed 2003 Add Cat./Item: C-B/C2.21 Location: RAB 216'
 Drawing No.: 1-ISI-BIT-1 Description: Inlet Nozzle to Head Weld
 System ID: SI-2080
 Component ID: II-BIT-01NTHW-04 Size/Length: N/A Thickness/Diameter: SS / 2.0"
 Limitations: None Start Time: 1046 Finish Time: 1102

Instrument Settings
 Serial No.: 15A024PE Manufacturer: GE Model: USN60sw Linearity: L-16-011
 Delay: 2.0450 Range: 8.0" M'll Cal/Vel: 0.2237 Pulser Type: Square
 Damping: 500 Ohms Reject: 0% PRF: Auto High SU Freq.: 1.0 MHz
 Frequency: 1.0 MHz Rectify: Fullwave Voltage: 450 Pulse Width: 500
 Ax. Gain (dB): 10.6 Circ. Gain (dB): 10.6
1 Screen Div. = 0.8 in. of Depth

Search Unit
 Serial No.: 001WVY Manufacturer: KBA Model: Gamma
 Size: 0.50" Freq.: 1.0 MHz Center Freq.: N/A
 Exam Angle: 0 Squint Angle: N/A Measured Angle: N/A Mode: Long.
 Exit Point: N/A # of Elements: 1 Config.: Single Focus: N/A
 Shape: Round Contour: Flat Wedge Style: Integral

Search Unit Cable
 Type: RG174 Length: 6' No. Conn.: 0

Cal. Checks	Time	Date
Initial Cal.	0805	10/4/2016
Inter. Cal.	N/A	
Inter. Cal.	1045	10/4/2016
Inter. Cal.	N/A	
Final Cal.	1355	10/4/2016

Couplant
 Cal. Batch: 15B080
 Type: Ultragel II
 Mfg.: Magnaflux
 Exam Batch: 15B080
 Type: Ultragel II
 Mfg.: Magnaflux

Axial Oriented Search Unit			
Calibration Reflector	Signal Amplitude %	Sweep Division	Depth
1.0" Side	80	1.25	1.0"
4.0" Side	80	5.0	4.0"

Circumferential Oriented Search Unit			
Calibration Reflector	Signal Amplitude %	Sweep Division	Depth
See Axial			

Reference/Simulator Block				
Gain dB	Reflector	Signal Amplitude %	Sweep Division	Depth
2.3	1" Side	80	1.25	1.0"

Calibration Block
 Cal. Block No.: A06311 Thickness: 4.0" Dia.: Flat
 Cal. Blk. Temp.: 74 Temp. Tool: G502480 Comp. Temp.: 79 Temp. Tool: G502480
 Recordable Indication(s): Yes No (If Yes, Ref. Attached Ultrasonic Indication Report.)
 Results: Sat Unsat Eval
 Percent Of Coverage Obtained > 90%: N/A Reviewed Previous Data: No

Scan Coverage
 Upstream Downstream Scan dB: 13.6
 CW CCW Scan dB: 13.6
 Exam Surface: O.D. Surface Condition: Ground Smooth

Reference Block
 Serial No.: 15-2377
 Type: ROMPAS

Comments: Utilized for T & C only. Lamination scans performed in prior examination. Data not available.

Examiner	Level	Signature	Date	Reviewer	Signature	Date
Schmalz, Matthew W.	II-N		10/4/2016	D.B. King, UT Level		10/20/16
Rush, J. Scott	II-N		10/4/2016	Angela Staller		10/21/16
N/A	N/A			Nancy Ritchie-Slaughter		10/23/16

Summary No.: H-01354

Examiner: Schmalz, Matthew W.
Examiner: Rush, J. Scott
Other: N/A

Level: II-N
Level: II-N
Level: N/A


Reviewer: D.B. King, UT Lempert
Site Review: Angela Staller
ANII Review: Nancy Ritchie-Slaughter

Date: 10/10/16
Date: 10/21/16
Date: 10/23/16

NANCY RITCHIE-SLAUGHTER

Comments: T & C - Inlet connection
T & C - Taken at 0° RT marker on head.

Sketch or Photo: Z:\UT\OUTAGES\Harris\Contours and Profiles\II-BIT-01NTHW-04_Page_1.bmp

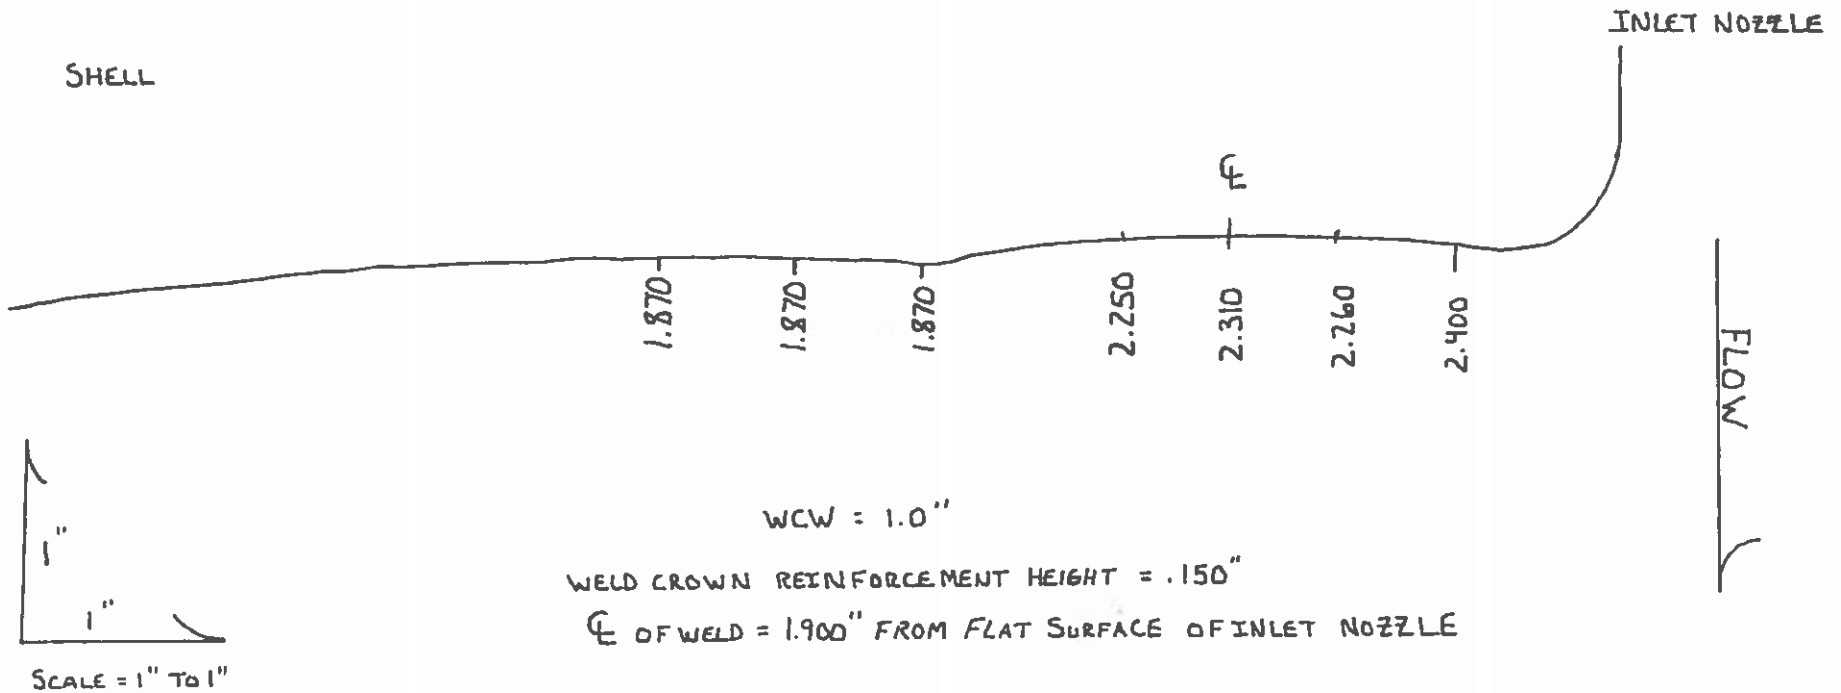

Summary No.: H-01354


Examiner: Schmalz, Matthew W. Level: II-N
 Examiner: Rush, J. Scott Level: II-N
 Other: N/A Level: N/A

Reviewer: D.B. King, UT Level III Date: 10/10/16
 Site Review: Angela Staller / Angela Staller Date: 10/21/16
 ANII Review: Nancy Ritchie Slaughter Date: 10/23/16

NANCY RITCHIE SLAUGHTER

Comments: **45° Coverage Plot**

Sketch or Photo: Z:\UT\OUTAGES\Harris\Contours and Profiles\II-BIT-01NTHW-04_Page_2.bmp

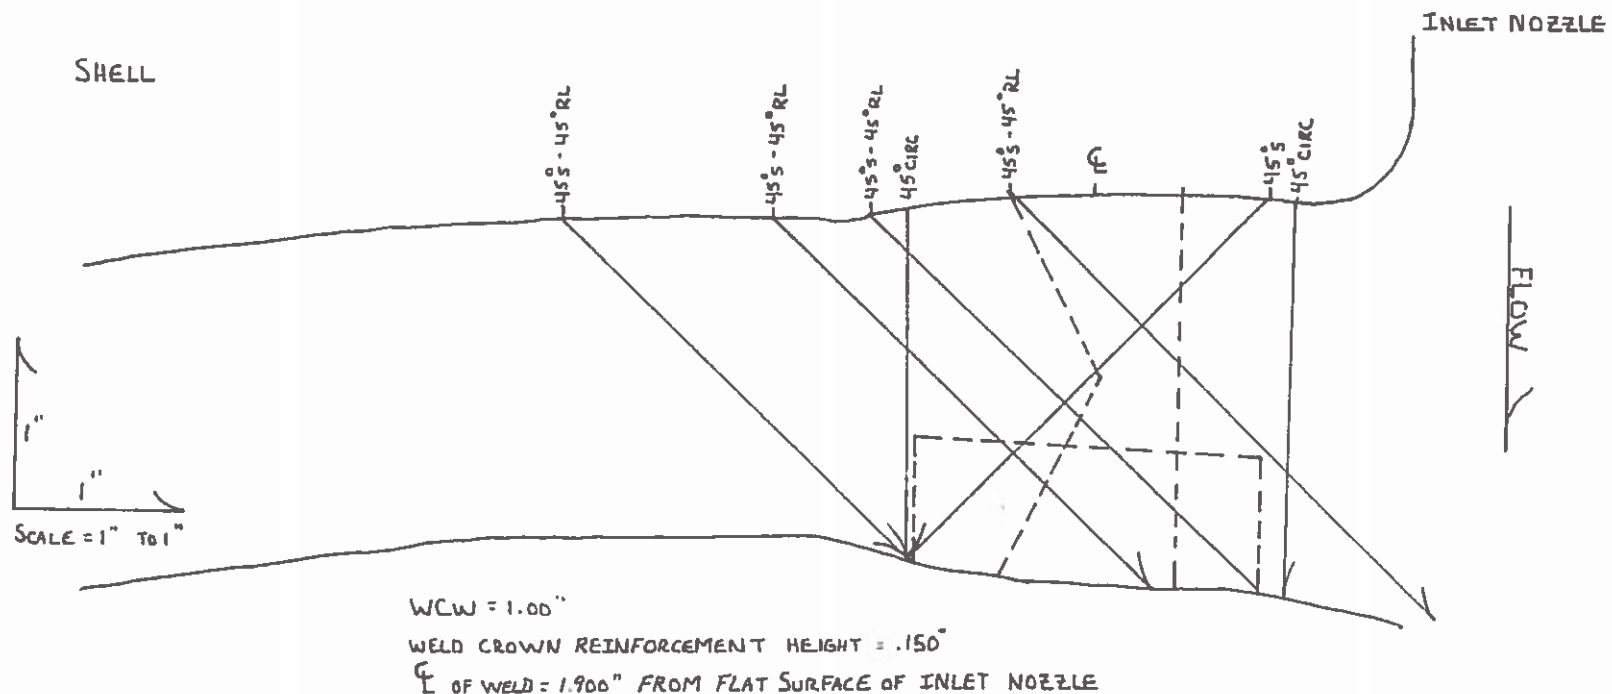

Summary No.: H-01354

Examiner: Schmalz, Matthew W. *[Signature]* Level: II-N

Examiner: Rush, J. Scott *[Signature]* Level: II-N

Other: N/A Level: N/A

Reviewer: D.B. King, UT Lead *[Signature]* Date: 10/10/16


Site Review: Angela Staller, Angela Staller *[Signature]* Date: 10/21/16

ANII Review: Nancy Ritchie-Slaughter *[Signature]* Date: 10/23/16



NANCY RITCHIE-SLAUGHTER



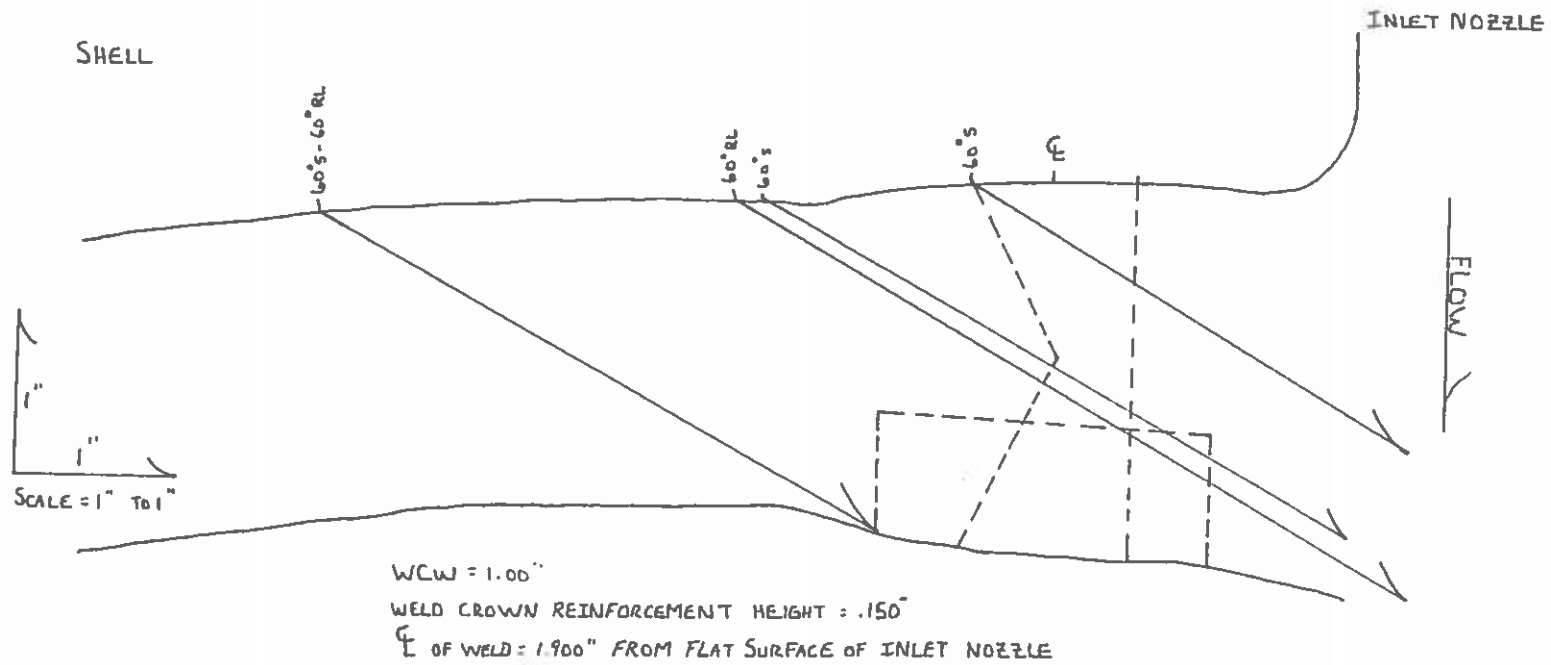

Comments: **60° Coverage Plot**

Sketch or Photo: Z:\UT\OUTAGES\Harris\Contours and Profiles\II-BIT-01NTHW-04_Page_3.bmp




Summary No.: H-01354


Examiner: Schmalz, Matthew W.  Level: II-N
Examiner: Rush, J. Scott  Level: II-N
Other: N/A Level: N/A

JASON POLISENSKY  10/10/2016
Reviewer: D.B. King UT Level III  Date: 10/10/16
Site Review: Angela Staller, Angela Staller  Date: 10/21/16
ANII Review: Nancy Ritchie-Slaughter  Date: 10/23/16
NANCY RITCHIE-SLAUGHTER

Comments: Calculation

Sketch or Photo: Z:\UT\OUTAGES\Harris\Contours and Profiles\II-BIT-01NTHW-04_Page_4.bmp

Total Weld Volume: $2.05''(w) \times .8''(h) = 1.64''^2$ 

Total AX (away from NOZ) coverage with 45°: $.95''(b) \times .5''(h) / 2 = .24''^2$  $.24 / 1.64 = 14.6\%$

SCAN COVERAGE:

CW = 100%

CCW = 100%

AX towards NOZ = 100% (using 45° and 60°)

AX away from NOZ = 14.6% (limited due to Noz Configuration)

$100 + 100 + 100 + 14.6 = 314.6 / 4 = \underline{\underline{78.6\% \text{ Total Examination Coverage}}}$



Liquid Penetrant Examination

Site/Unit: HNP / 1 Procedure: NDEP-0201 Outage No.: RFO-19
 Summary No.: H-01354 Procedure Rev.: 34 TR-A Report No.: PT-15-005
 Workscope: ISI Work Order No.: 13352682 Page: 1 of 1

Code: 2001 Edition 2003 Addenda Cat./Item: C-B/C2.21 Location: RAB 216'
 Drawing No.: 1-ISI-BIT-1 Description: Inlet Nozzle to Head Weld
 System ID: SI-2080
 Component ID: II-BIT-01NTHW-04 Mat./Thickness: SS / SA-204 - 2"
 Limitations: None

Light Meter Mfg.: Spectronics Serial No.: MCNDE40183 Illumination: >100fc
 Temp. Tool Mfg.: Fluke Serial No.: MCNDE40194 Surface Temp.: 68.4 °F
 Comparator Block Temp.: Side A: N/A °F Side B: N/A °F Resolution: Not Used
 Lo/Wo Location: N/A Surface Condition: Smooth

	Cleaner	Penetrant Visible <input checked="" type="checkbox"/> Fluorescent <input type="checkbox"/>	Remover	Developer
Brand	Magnaflux	Magnaflux	Magnaflux	Magnaflux
Type	SKC-S	SKL-SP2	SKC-S	SKD-S2
Batch No.	13J09K	12L04K	13J09K	11L05K
Time	Evap. 5 Minutes	Dwell 10 Minutes	Evap. 5 Minutes	Develop 10 Minutes
Time Exam Started: 1100		Time Exam Completed: 1140		

Indication No.	Loc L	Loc W	Diameter	Length	Type R/L	Remarks
NRI						

Comments:
NONE

Results: Sat Unsat Eval
 Percent Of Coverage Obtained > 90%: 100 Reviewed Previous Data: None

Examiner	Level	Signature	Date	Reviewer	Signature	Date
Nahory, W. Jason	II-N		4/15/2015	Jerry Newgard, Level III		4/24/2015
Examiner	Level	Signature	Date	Site Review	Signature	Date
N/A	N/A			Angela Staller		4/27/2015
Other	Level	Signature	Date	ANII Review	Signature	Date
N/A	N/A			Nancy Ritchie-Slaughter, ANII		4/28/2015

This Document is a QA Record



UT Calibration/Examination

Site/Unit: HNP / 1
 Summary No.: H-01353
 Workscope: ISI

Procedure: NDEP-0450
 Procedure Rev.: 5
 Work Order No.: 13540520

Outage No.: RFO-20
 Report No.: UT-16-002
 Page: 1 of 12

Code: 2001 Ed 2003 Add Cat./Item: C-B/C2.21 Location: RAB 226*
 Drawing No.: 1-ISI-BIT-1 Description: Outlet Nozzle to Vessel Weld
 System ID: SI-2080
 Component ID: II-BIT-01NTHW-03 Size/Length: N/A Thickness/Diameter: SS / 2.0"
 Limitations: Yes - Due to nozzle configuration Start Time: 1217 Finish Time: 1235

Instrument Settings
 Serial No.: 15A024PE
 Manufacturer: GE
 Model: USN60sw Linearity: L-16-011
 Delay: 8.7403 Range: 5.0"
 M'll Cal/Vel: 0.1230 Pulsar Type: Square
 Damping: 500 Ohms Reject: 0%
 PRF: Auto High SU Freq.: 1.5 MHz
 Frequency: 2.0 MHz Rectify: Fullwave
 Voltage: 450 Pulse Width: 330
 Ax. Gain (dB): 27.4 Circ. Gain (dB): 27.4
1 Screen Div. = .5 in. of Sound Path

Search Unit
 Serial No.: 011CXD
 Manufacturer: KBA
 Size: 0.375" Model: Comp - G
 Freq.: 1.5 MHz Center Freq.: N/A
 Exam Angle: 45 Squint Angle: N/A
 Measured Angle: 45 Mode: Shear
 Exit Point: 0.4" # of Elements: 1
 Config.: Single Focus: N/A
 Shape: Round Contour: Flat
 Wedge Style: MSWQC
Search Unit Cable
 Type: RG174 Length: 6' No. Conn.: 0

Cal. Checks	Time	Date
Initial Cal.	0820	10/4/2016
Inter. Cal.	N/A	
Inter. Cal.	1216	10/4/2016
Inter. Cal.	N/A	
Final Cal.	1359	10/4/2016

Couplant
 Cal. Batch: 15B080
 Type: Ultragel II
 Mfg.: Magnaflux
 Exam Batch: 15B080
 Type: Ultragel II
 Mfg.: Magnaflux

Scan Coverage
 Upstream Downstream Scan dB: 33.4
 CW CCW Scan dB: 33.4
 Exam Surface: O.D.
 Surface Condition: Ground Smooth

Reference Block
 Serial No.: 15-2377
 Type: ROMPAS

Axial Oriented Search Unit			
Calibration Reflector	Signal Amplitude %	Sweep Division	Sound Path
1/4T SDH	80	2.0	0.968"
1/2T SDH	40	4.0	2.0"
3/4T SDH	20	6.0	2.97"
5/4T SDH	12	10.0	4.96"

Circumferential Oriented Search Unit			
Calibration Reflector	Signal Amplitude %	Sweep Division	Sound Path
See Axial			

Reference/Simulator Block				
Gain dB	Reflector	Signal Amplitude %	Sweep Division	Sound Path
27.4	FSDH	20	2.0	1.0"

Recordable Indication(s): Yes No (If Yes, Ref. Attached Ultrasonic Indication Report.)
 Results: Sat Unsat Eval NCR # 02067723
 Percent Of Coverage Obtained > 90%: No - 76.5% Reviewed Previous Data: No

Comments: N/A

Examiner	Level	Signature	Date	Reviewer	Signature	Date
Schmalz, Matthew W.	II-N		10/4/2016	D.B. King, UT Level III		10/17/16
Rush, J. Scott	II-N		10/4/2016	Angela Staller		10/17/16
N/A	N/A			NANCY RITCHIE-SLAUGHTER		10/17/16



UT Calibration/Examination

Site/Unit: HNP / 1
 Summary No.: H-01353
 Workscope: ISI

Procedure: NDEP-0450
 Procedure Rev.: 5
 Work Order No.: 13540520

Outage No.: RFO-20
 Report No.: UT-16-002
 Page: 2 of 12

Code: 2001 Ed 2003 Add Cat./Item: C-B/C2.21 Location: RAB 226'
 Drawing No.: 1-ISI-BIT-1 Description: Outlet Nozzle to Vessel Weld
 System ID: SI-2080
 Component ID: II-BIT-01NTHW-03 Size/Length: N/A Thickness/Diameter: SS / 2.0"
 Limitations: Yes - Due to nozzle configuration Start Time: 1239 Finish Time: 1244

Instrument Settings
 Serial No.: 15A024PE
 Manufacturer: GE
 Model: USN60sw Linearity: L-16-011
 Delay: 10.1525 Range: 6.0"
 M/I Cal/Vel: 0.1228 Pulsar Type: Square
 Damping: 500 Ohms Reject: 0%
 PRF: Auto High SU Freq.: 2.25 MHz
 Frequency: 2.25 MHz Rectify: Fullwave
 Voltage: 450 Pulse Width: 220
 Ax. Gain (dB): 50.0 Circ. Gain (dB): N/A

1 Screen Div. = .6 in. of Sound Path

Calibration Block
 Cal. Block No.: 16C-087
 Thickness: 3.04" Dia.: Flat
 Cal. Blk. Temp.: 74 Temp. Tool: G502480
 Comp. Temp.: 79 Temp. Tool: G502480

Recordable Indication(s): Yes No (If Yes, Ref. Attached Ultrasonic Indication Report.)
 Results: Sat Unsat Eval

Percent Of Coverage Obtained > 90%: No - 76.5% Reviewed Previous Data: No

Search Unit
 Serial No.: 01F62L
 Manufacturer: KBA
 Size: 0.375" Model: Comp - G
 Freq.: 2.25 MHz Center Freq.: N/A
 Exam Angle: 60 Squint Angle: N/A
 Measured Angle: 60 Mode: Shear
 Exit Point: 0.45" # of Elements: 1
 Config.: Single Focus: N/A
 Shape: Round Contour: Flat
 Wedge Style: MSWQC

Search Unit Cable
 Type: RG174 Length: 6' No. Conn.: 0

Scan Coverage
 Upstream Downstream Scan dB: 56.0
 CW CCW Scan dB: N/A
 Exam Surface: O.D.
 Surface Condition: Ground Smooth

Cal. Checks	Time	Date
Initial Cal.	0835	10/4/2016
Inter. Cal.	N/A	
Inter. Cal.	1238	10/4/2016
Inter. Cal.	N/A	
Final Cal.	1404	10/4/2016

Couplant
 Cal. Batch: 15B080
 Type: Ultragel II
 Mfg.: Magnaflux
 Exam Batch: 15B080
 Type: Ultragel II
 Mfg.: Magnaflux

Reference Block
 Serial No.: 15-2377
 Type: ROMPAS

Axial Oriented Search Unit			
Calibration Reflector	Signal Amplitude %	Sweep Division	Sound Path
1/4T SDH	100	2.2	1.36"
1/2T SDH	60	4.9	2.93"
3/4T SDH	30	7.8	4.68"

Circumferential Oriented Search Unit			
Calibration Reflector	Signal Amplitude %	Sweep Division	Sound Path
N/A			

Reference/Simulator Block				
Gain dB	Reflector	Signal Amplitude %	Sweep Division	Sound Path
50	FSDH	60	2.4	1.409"

Comments: Acoustic interface seen intermittently 360°.

Examiner	Level	II-N	Signature	Date	Reviewer	Signature	Date
Schmalz, Matthew W.				10/4/2016	D.B. King, UT Level III		10/17/16
Rush, J. Scott				10/4/2016	Angela Staller		10/17/16
Other	Level	N/A	Signature	Date	ANGELA STALLER	Signature	Date
N/A					Nancy Ritchie-Slaughter		10/17/16



UT Calibration/Examination

Site/Unit: HNP / 1 Procedure: NDEP-0450 Outage No.: RFO-20
 Summary No.: H-01353 Procedure Rev.: 5 Report No.: UT-16-002
 Workscope: ISI Work Order No.: 13540520 Page: 3 of 12

Code: 2001 Ed 2003 Add Cat./Item: C-B/C2.21 Location: RAB 226'
 Drawing No.: 1-ISI-BIT-1 Description: Outlet Nozzle to Vessel Weld
 System ID: SI-2080
 Component ID: II-BIT-01NTHW-03 Size/Length: N/A Thickness/Diameter: SS / 2.0"
 Limitations: Yes - Due to nozzle configuration Start Time: 1248 Finish Time: 1255

Instrument Settings

Serial No.: 15A024PE
 Manufacturer: GE
 Model: USN60sw Linearity: L-16-011
 Delay: 9.7821 Range: 5.0"
 M'fl Cal/Vel: 0.2280 Pulsar Type: Square
 Damping: 500 Ohms Reject: 0%
 PRF: Auto High SU Freq.: 2.0 MHZ
 Frequency: 2.0 MHZ Rectify: Fullwave
 Voltage: 450 Pulse Width: 250
 Ax. Gain (dB): 39.6 Circ. Gain (dB): N/A

Search Unit

Serial No.: 03-780
 Manufacturer: RTD
 Size: 2(15x25) Model: TRL2
 Freq.: 2.0 MHZ Center Freq.: N/A
 Exam Angle: 45 Squint Angle: 10
 Measured Angle: 45 Mode: Long.
 Exit Point: 0.6" # of Elements: 2
 Config.: Dual Focus: FS-55
 Shape: Rect. Contour: Flat
 Wedge Style: Integral

Cal. Checks	Time	Date
Initial Cal.	0840	10/4/2016
Inter. Cal.	N/A	
Inter. Cal.	1247	10/4/2016
Inter. Cal.	N/A	
Final Cal.	1409	10/4/2016

Couplant

Cal. Batch: 15B080
 Type: Ultragel II
 Mfg.: Magnaflux
 Exam Batch: 15B080
 Type: Ultragel II
 Mfg.: Magnaflux

Search Unit Cable

Type: RG174 Length: 6' No. Conn.: 0
Scan Coverage
 Upstream Downstream Scan dB: 45.6
 CW CCW Scan dB: N/A
 Exam Surface: O.D.
 Surface Condition: Ground Smooth

Calibration Block

Cal. Block No.: 16C-087
 Thickness: 3.04" Dia.: Flat
 Cal. Blk. Temp.: 74 Temp. Tool: G502480
 Comp. Temp.: 79 Temp. Tool: G502480

Reference Block

Serial No.: 15-2377
 Type: ROMPAS

Axial Oriented Search Unit

Calibration Reflector	Signal Amplitude %	Sweep Division	Sound Path
ID Notch	80	8.4	4.19"

Circumferential Oriented Search Unit

Calibration Reflector	Signal Amplitude %	Sweep Division	Sound Path
N/A			

Reference/Simulator Block

Gain dB	Reflector	Signal Amplitude %	Sweep Division	Sound Path
24.2	2" Radius	80	4.0	2.0"

Recordable Indication(s): Yes No (If Yes, Ref. Attached Ultrasonic Indication Report.)
 Results: Sat Unsat Eval

Comments: L-wave verified in accordance with AD-NE-ALL-1103.

Percent Of Coverage Obtained > 90%: No - 76.5% Reviewed Previous Data: No

Examiner	Level	Signature	Date	Reviewer	Signature	Date
Schmalz, Matthew W.	II-N	<i>[Signature]</i>	10/4/2016	D.B. King, UT Center	<i>[Signature]</i>	10/17/16
Rush, J. Scott	II-N	<i>[Signature]</i>	10/4/2016	Site Review Annela Staller	<i>[Signature]</i>	10/17/16
Other N/A	Level N/A	Signature	Date	ANNE RITCHIE-SLAUGHTER Nancy Ritchie-Slaughter	Signature	Date 10/17/16



UT Calibration/Examination

Site/Unit: HNP / 1 Procedure: NDEP-0450 Outage No.: RFO-20
 Summary No.: H-01353 Procedure Rev.: 5 Report No.: UT-16-002
 Workscope: ISI Work Order No.: 13540520 Page: 4 of 12

Code: 2001 Ed 2003 Add Cat./Item: C-B/C2.21 Location: RAB 226'
 Drawing No.: 1-ISI-BIT-1 Description: Outlet Nozzle to Vessel Weld
 System ID: SI-2080
 Component ID: II-BIT-01NTHW-03 Size/Length: N/A Thickness/Diameter: SS / 2.0"
 Limitations: Yes - Due to nozzle configuration Start Time: 1259 Finish Time: 1304

Instrument Settings
 Serial No.: 15A024PE Manufacturer: GE Model: USN60sw Linearity: L-16-011
 Delay: 12.1762 Range: 10.0" M'll Cal/Vel: 0.228 Pulsar Type: Square
 Damping: 500 Ohms Reject: 0% PRF: Auto High SU Freq.: 2.0 MHZ
 Frequency: 2.0 MHZ Rectify: Fullwave Voltage: 450 Pulse Width: 250
 Ax. Gain (dB): 51.2 Circ. Gain (dB): N/A
1 Screen Div. = 1.0 in. of Sound Path

Search Unit
 Serial No.: 03-794 Manufacturer: RTD Size: 20x34 Model: TRL2
 Freq.: 2.0 MHZ Center Freq.: N/A Exam Angle: 60 Squint Angle: 3
 Measured Angle: 60 Mode: Long. Exit Point: 0.7" # of Elements: 2
 Config.: Dual Focus: FS-105 Shape: Rect. Contour: Flat
 Wedge Style: Integral
Search Unit Cable
 Type: RG174 Length: 6' No. Conn.: 0
Scan Coverage
 Upstream Downstream Scan dB: 57.2
 CW CCW Scan dB: N/A
 Exam Surface: O.D. Surface Condition: Ground Smooth

Calibration Block
 Cal. Block No.: 16C-087 Thickness: 3.04 Dia.: Flat
 Cal. Blk. Temp.: 74 Temp. Tool: G502480 Comp. Temp.: 79 Temp. Tool: G502480
 Recordable Indication(s): Yes No (If Yes, Ref. Attached Ultrasonic Indication Report.)
 Results: Sat Unsat Eval

Percent Of Coverage Obtained > 90%: No - 76.5% Reviewed Previous Data: No

Cal. Checks	Time	Date
Initial Cal.	0846	10/4/2016
Inter. Cal.	N/A	
Inter. Cal.	1258	10/4/2016
Inter. Cal.	N/A	
Final Cal.	1413	10/4/2016

Couplant
 Cal. Batch: 15B080 Type: Ultrigel II
 Mfg.: Magnaflux
 Exam Batch: 15B080 Type: Ultrigel II
 Mfg.: Magnaflux

Reference Block
 Serial No.: 15-2377 Type: ROMPAS

Axial Oriented Search Unit			
Calibration Reflector	Signal Amplitude %	Sweep Division	Sound Path
ID Notch	80	5.8	5.85"

Circumferential Oriented Search Unit			
Calibration Reflector	Signal Amplitude %	Sweep Division	Sound Path
N/A			

Reference/Simulator Block				
Gain dB	Reflector	Signal Amplitude %	Sweep Division	Sound Path
51.2	FSDH	58	1.4	1.41"

Comments: L-wave verified in accordance with AD-NE-ALL-1103. Acoustic interface noted 360° intermittently.

Examiner	Level	Signature	Date	Reviewer	Signature	Date
Schmalz, Matthew W.	II-N		10/4/2016	D.B. King, UT Level III		10/17/16
Rush, J. Scott	II-N		10/4/2016	Angela Staller		10/17/16
Other	Level N/A	Signature	Date	ANGELA STALLER	Signature	Date
N/A				NANCY RITCHIE-SLAUGHTER		10/17/16



UT Calibration/Examination

Site/Unit: HNP / 1
 Summary No.: H-01353
 Workscope: ISI

Procedure: NDEP-0408
 Procedure Rev.: 14
 Work Order No.: 13540520

Outage No.: RFO-20
 Report No.: UT-16-002
 Page: 5 of 12

Code: 2001 Ed 2003 Add Cat./Item: C-B/C2.21 Location: RAB 226'
 Drawing No.: 1-ISI-BIT-1 Description: Outlet Nozzle to Vessel Weld
 System ID: SI-2080
 Component ID: II-BIT-01NTHW-03 Size/Length: N/A Thickness/Diameter: SS / 2.0"
 Limitations: None Start Time: 1207 Finish Time: 1214

Instrument Settings
 Serial No.: 15A024PE Manufacturer: GE Model: USN60sw Linearity: L-16-011
 Delay: 2.0450 Range: 8.0"
 M/I Cal/Vel: 0.2237 Pulsar Type: Square
 Damping: 500 Ohms Reject: 0%
 PRF: Auto High SU Freq.: 1.0 MHz
 Frequency: 1.0 MHz Rectify: Fullwave
 Voltage: 450 Pulse Width: 500
 Ax. Gain (dB): 10.6 Circ. Gain (dB): 10.6
 1 Screen Div. = 0.8 in. of Depth

Search Unit
 Serial No.: 001WVY Manufacturer: KBA Size: 0.50" Model: Gamma
 Freq.: 1.0 MHz Center Freq.: N/A
 Exam Angle: 0 Squint Angle: N/A
 Measured Angle: N/A Mode: Long
 Exit Point: N/A # of Elements: 1
 Config.: Single Focus: N/A
 Shape: Round Contour: Flat
 Wedge Style: Integral

Cal. Checks	Time	Date
Initial Cal.	0805	10/4/2016
Inter. Cal.	N/A	
Inter. Cal.	1206	10/4/2016
Inter. Cal.	N/A	
Final Cal.	1355	10/4/2016

Couplant
 Cal. Batch: 15B080
 Type: Ultragel II
 Mfg.: Magnaflux
 Exam Batch: 15B080
 Type: Ultragel II
 Mfg.: Magnaflux

Axial Oriented Search Unit			
Calibration Reflector	Signal Amplitude %	Sweep Division	Depth
1.0" Side	80	1.25	1.0"
4.0" Side	80	5.0	4.0"

Search Unit Cable
 Type: RG174 Length: 6' No. Conn.: 0

Calibration Block
 Cal. Block No.: A06311
 Thickness: 4.0" Dia.: Flat
 Cal. Blk. Temp.: 74 Temp. Tool: G502480
 Comp. Temp.: 79 Temp. Tool: G502480

Scan Coverage
 Upstream Downstream Scan dB: 13.6
 CW CCW Scan dB: 13.6
 Exam Surface: O.D.
 Surface Condition: Ground Smooth

Reference Block
 Serial No.: 15-2377
 Type: ROMPAS

Circumferential Oriented Search Unit			
Calibration Reflector	Signal Amplitude %	Sweep Division	Depth
See Axial			

Reference/Simulator Block				
Gain dB	Reflector	Signal Amplitude %	Sweep Division	Depth
2.3	1" Side	80	1.25	1.0"

Recordable Indication(s): Yes No (If Yes, Ref. Attached Ultrasonic Indication Report.)
 Results: Sat Unsat Eval

Comments: Utilized for T & C only. Lamination scans performed in prior examination. Data not available.

Percent Of Coverage Obtained > 90%: N/A Reviewed Previous Data: No

Examiner	Level	Signature	Date	Reviewer	Signature	Date
Schmaiz, Matthew W.	II-N		10/4/2016	D.B. King, UT Level III		10/17/16
Rush, J. Scott	II-N		10/4/2016	Angela Staller		10/17/16
Other	Level N/A	Signature	Date	NANCY RITCHIE-SLAUGHTER		10/17/16

Supplemental Report

Report No.: UT-16-002

Page: 6 of 12

Summary No.: H-01353

Examiner: Schmalz, Matthew W.
 Examiner: Rush, J. Scott
 Other: N/A


Level: II-N
 Level: II-N
 Level: N/A

Reviewer: D.B. King, UT Level II
 Site Review: Angela Staller, Angela Staller
 ANII Review: NANCY RITCHIE-SLAUGHTER

Date: 10/17/16
 Date: 10/17/16
 Date: 10/17/16

Comments: T & C Taken at 0° RT marker on head.

Sketch or Photo: Z:\UT\OUTAGES\Harris\Contours and Profiles\II-BIT-01NTHW-03_Page 1.bmp

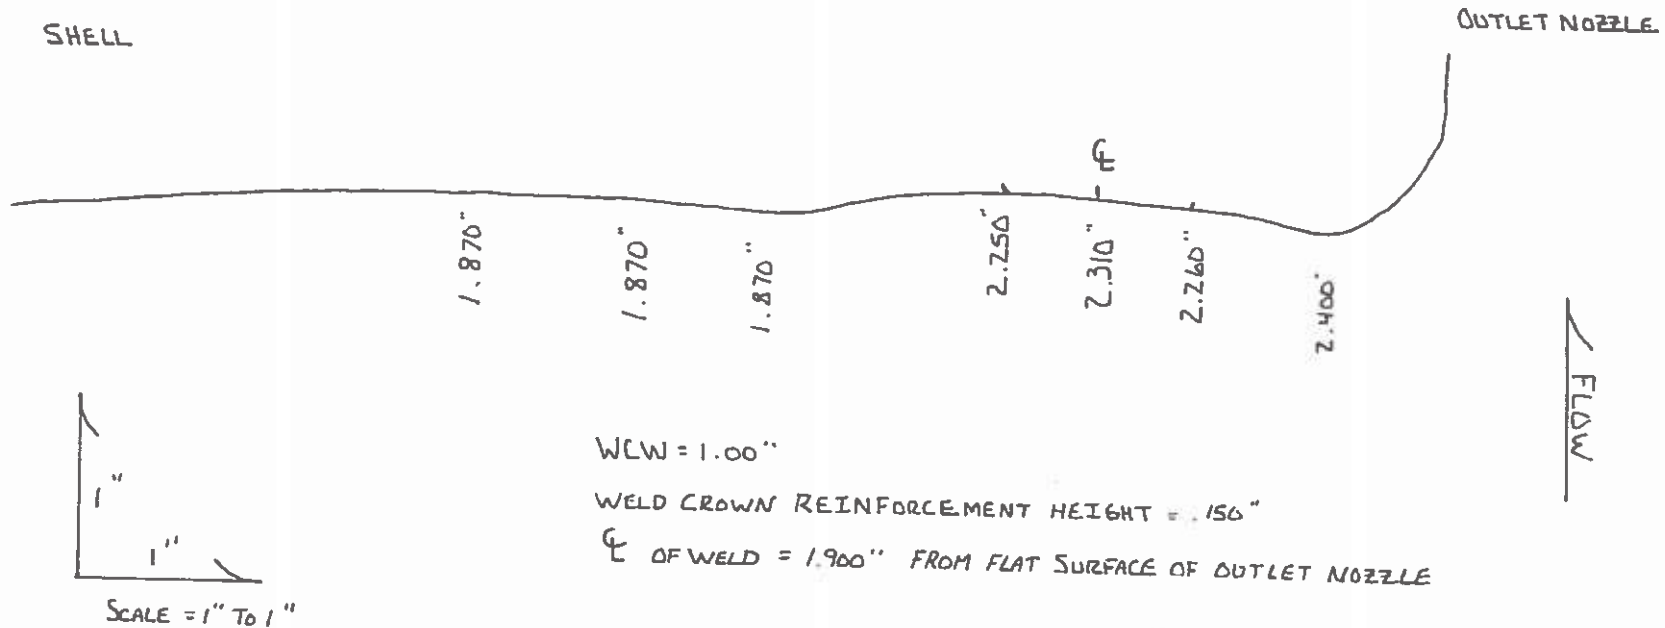

Supplemental Report

Report No.: UT-16-002

Page: 7 of 12

Summary No.: H-01353

Examiner: Schmalz, Matthew W. *[Signature]*

Level: II-N

Reviewer: Z.B. King, UT Carbon *[Signature]*

Date: 10/17/16

Examiner: Rush, J. Scott *[Signature]*

Level: II-N

Site Review: Angela Staller *[Signature]*

Date: 10/17/16

Other: N/A

Level: N/A


ANII Review: NANCY RITCHIE-SLAUGHTER

Date: 10/17/16

[Signature]
Nancy Ritchie-Slaughter

Comments: **45° Coverage Plot**

Sketch or Photo: Z:\UT\OUTAGES\Harris\Contours and Profiles\II-BIT-01NTHW-03_Page 2.bmp

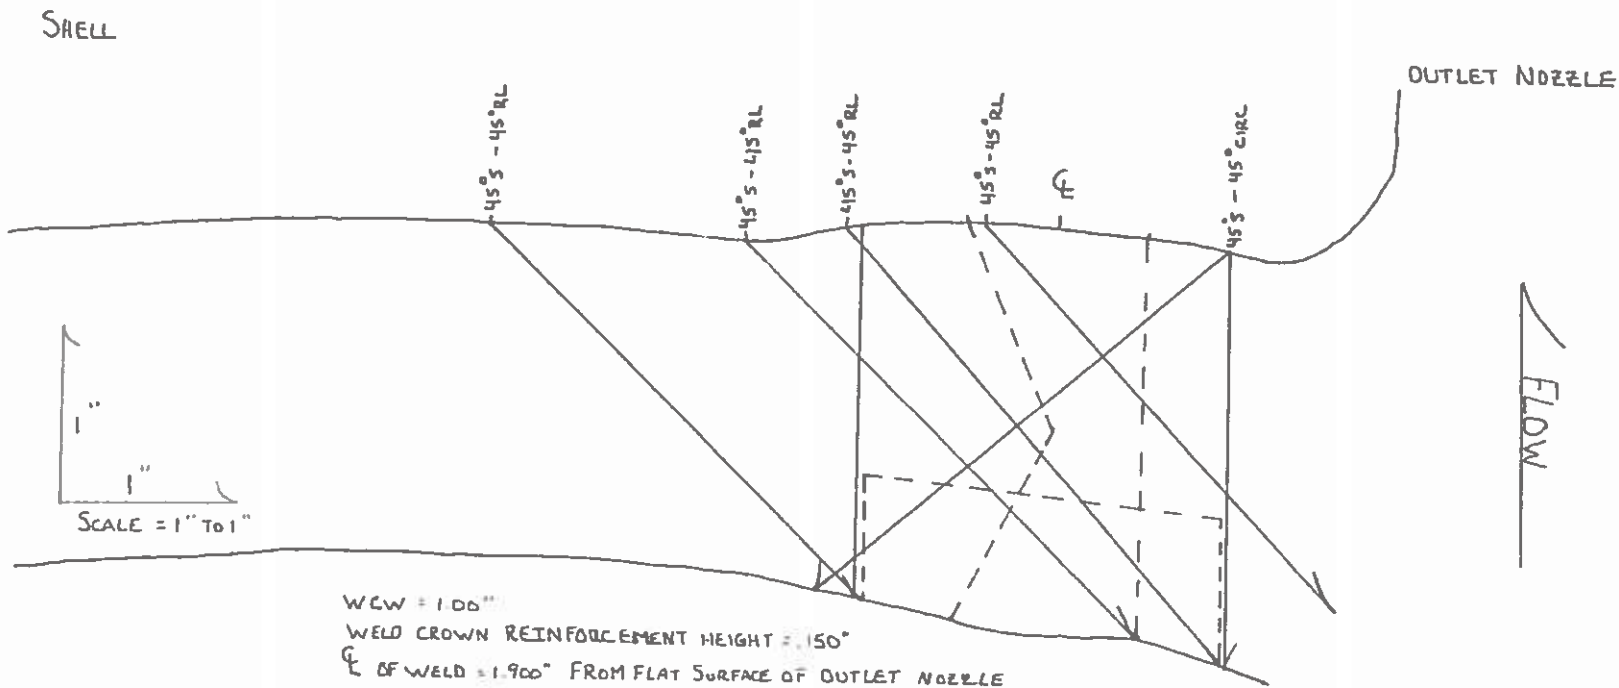

Summary No.: H-01353

Examiner: Schmalz, Matthew W.

Level: II-N

Reviewer: D.B. King, UT Level III

Date: 10/7/14

Examiner: Rush, J. Scott

Level: II-N

Site Review: Angela Staller, Angela Staller

Date: 10/7/16

Other: N/A

Level: N/A


ANII Review: NANCY RITCHIE-SLAUGHTER

Date: 10/17/16

Nancy Ritchie-Slaughter

Comments: **60° Coverage Plot**

Sketch or Photo: Z:\UT\OUTAGES\Harris\Contours and Profiles\II-BIT-01NTHW-03_Page_3.bmp

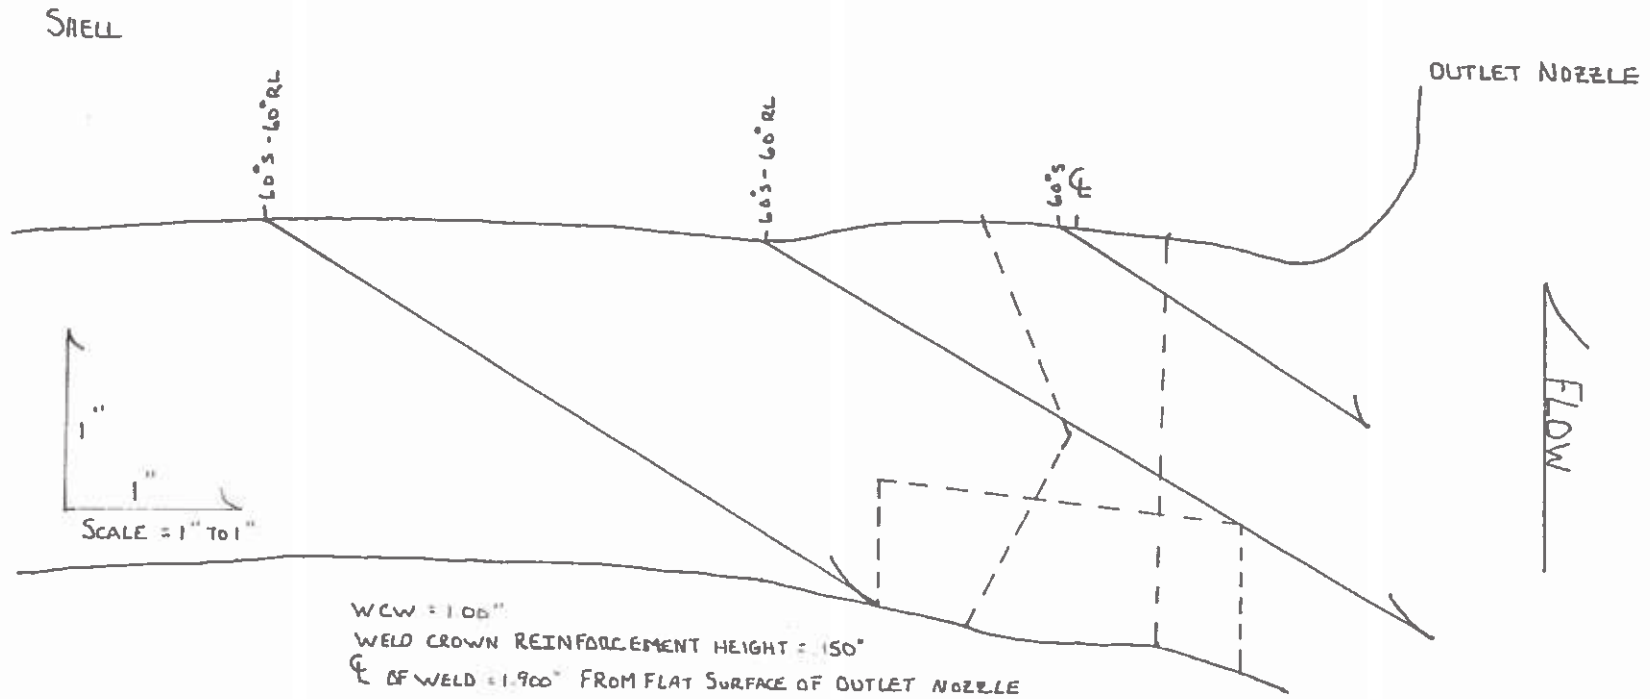

Supplemental Report

Report No.: UT-16-002

Page: 9 of 12

Summary No.: H-01353

Examiner: Schmalz, Matthew W.  Level: II-N

Examiner: Rush, J. Scott  Level: II-N

Other: N/A Level: N/A

JASON POLISENSKY  10/17/2016


Reviewer: D.B. King, UT Level II  Date: 10/17/16


Site Review: Angela Staller, Angela Staller  Date: 10/17/16

ANII Review: NANCY RITCHIE-SWAUGHTER  Date: 10/17/16

Comments: Calculation

Sketch or Photo: Z:\UT\OUTAGES\Harris\Contours and Profiles\II-BIT-01NTHW-03_Page 4.bmp

Total Weld Volume: $2.05''(w) \times .8''(h) = 1.64''^2$ 

Total AX (away from NOZ) coverage with 45°: $.6''(b) \times .33''(h) / 2 = .1''^2$  $.1 / 1.64 = 6.1\%$

SCAN COVERAGE:

CW = 100%

CCW = 100%

AX towards NOZ = 100% (using 45° and 60°)

AX away from NOZ = 6.1% (limited due to Noz Configuration)

$100 + 100 + 100 + 6.1 = 306.1 / 4 = \underline{\underline{76.5\% \text{ Total Examination Coverage}}}$



Liquid Penetrant Examination

Site/Unit: HNP / 1 Procedure: NDEP-0201 Outage No.: RFO-19
 Summary No.: H-01353 Procedure Rev.: 34 TR-A Report No.: PT-15-004
 Workscope: ISI Work Order No.: 13352682 Page: 1 of 1

Code: 2001 Edition 2003 Addenda Cat./Item: C-B/C2.21 Location: RAB 226'
 Drawing No.: 1-ISI-BIT-1 Description: Outlet Nozzle to Vessel Weld
 System ID: SI-2080
 Component ID: II-BIT-01NTHW-03 Mat./Thickness: SS / SA-204 - 2"
 Limitations: None

Light Meter Mfg.: Spectronics Serial No.: MCNDE40183 Illumination: >100fc
 Temp. Tool Mfg.: Fluke Serial No.: MCNDE40194 Surface Temp.: 68 °F
 Comparator Block Temp.: Side A: N/A °F Side B: N/A °F Resolution: Not Used
 Lo/Wo Location: N/A Surface Condition: Smooth

	Cleaner	Penetrant Visible <input checked="" type="checkbox"/> Fluorescent <input type="checkbox"/>	Remover	Developer
Brand	Magnaflux	Magnaflux	Magnaflux	Magnaflux
Type	SKC-S	SKL-SP2	SKC-S	SKD-S2
Batch No.	13J09K	12L04K	13J09K	11L05K
Time	Evap. 5 Minutes	Dwell 10 Minutes	Evap. 5 Minutes	Develop 10 Minutes
Time Exam Started: 1330		Time Exam Completed: 1410		

Indication No.	Loc L	Loc W	Diameter	Length	Type R/L	Remarks
NRI						

Comments:
NONE

Results: Sat Unsat Eval
 Percent Of Coverage Obtained > 90%: 100 Reviewed Previous Data: None

Examiner	Level	Signature	Date	Reviewer	Signature	Date
Nahory, W. Jason	II-N		4/16/2015	Jerry Newgard, Level III		4/24/2015
Examiner	Level	Signature	Date	Site Review	Signature	Date
N/A	N/A			Angela Staller		4/27/2015
Other	Level	Signature	Date	ANII Review	Signature	Date
N/A	N/A			Nancy Ritchie-Slaughter, ANII		4/28/2015

This Document is a QA Record