M-1102B

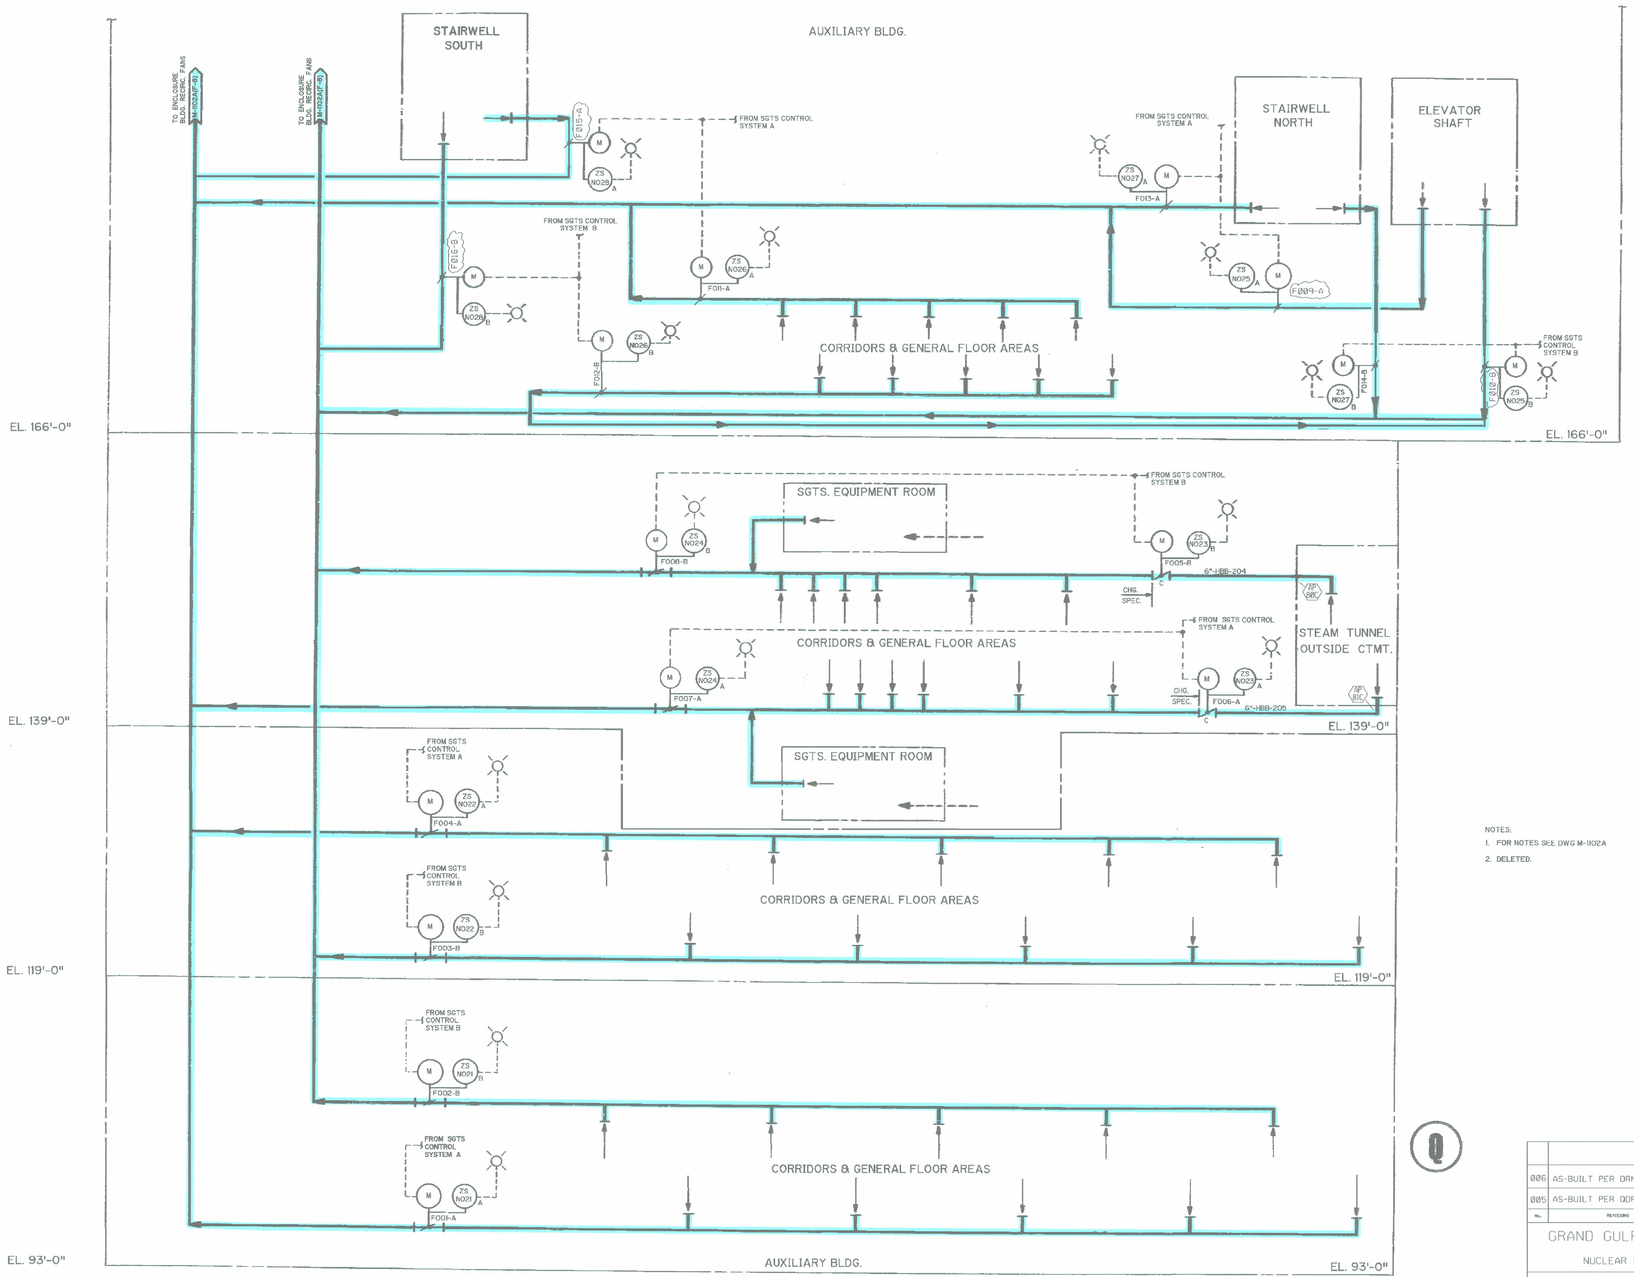

NOTES:
1. FOR NOTES SEE DWG M-1102A
2. DELETED.

COMPONENTS SUBJECT TO AMR
STANDBY GAS TREATMENT SYSTEM AMM10

NO.	REVISIONS	DWN	REV	REQ	CHKD	APPD	DATE
006	AS-BUILT PER DRN 8306	WC	N/A	N/A	BH	HDB	2-20-03
005	AS-BUILT PER QDR 0052-88	SIGN-OFF ON RECORD					

GRAND GULF NUCLEAR STATION
UNIT 1
NUCLEAR PLANT ENGINEERING

P & I DIAGRAM
STANDBY GAS TREATMENT SYSTEM
UNIT 1

SCALE:	DRAWING No.	REV.
NONE	M-1102B	006

NO.	DATE	DESCRIPTION	BY	ENG	CHK	APP
0	10-13-2011	.	.	.	.	.

REVISIONS

LRA-M-1102B

CAD FILE: m1102b.DGN
MASTER FILE:

HYBRID DFN: m1102b.dgn