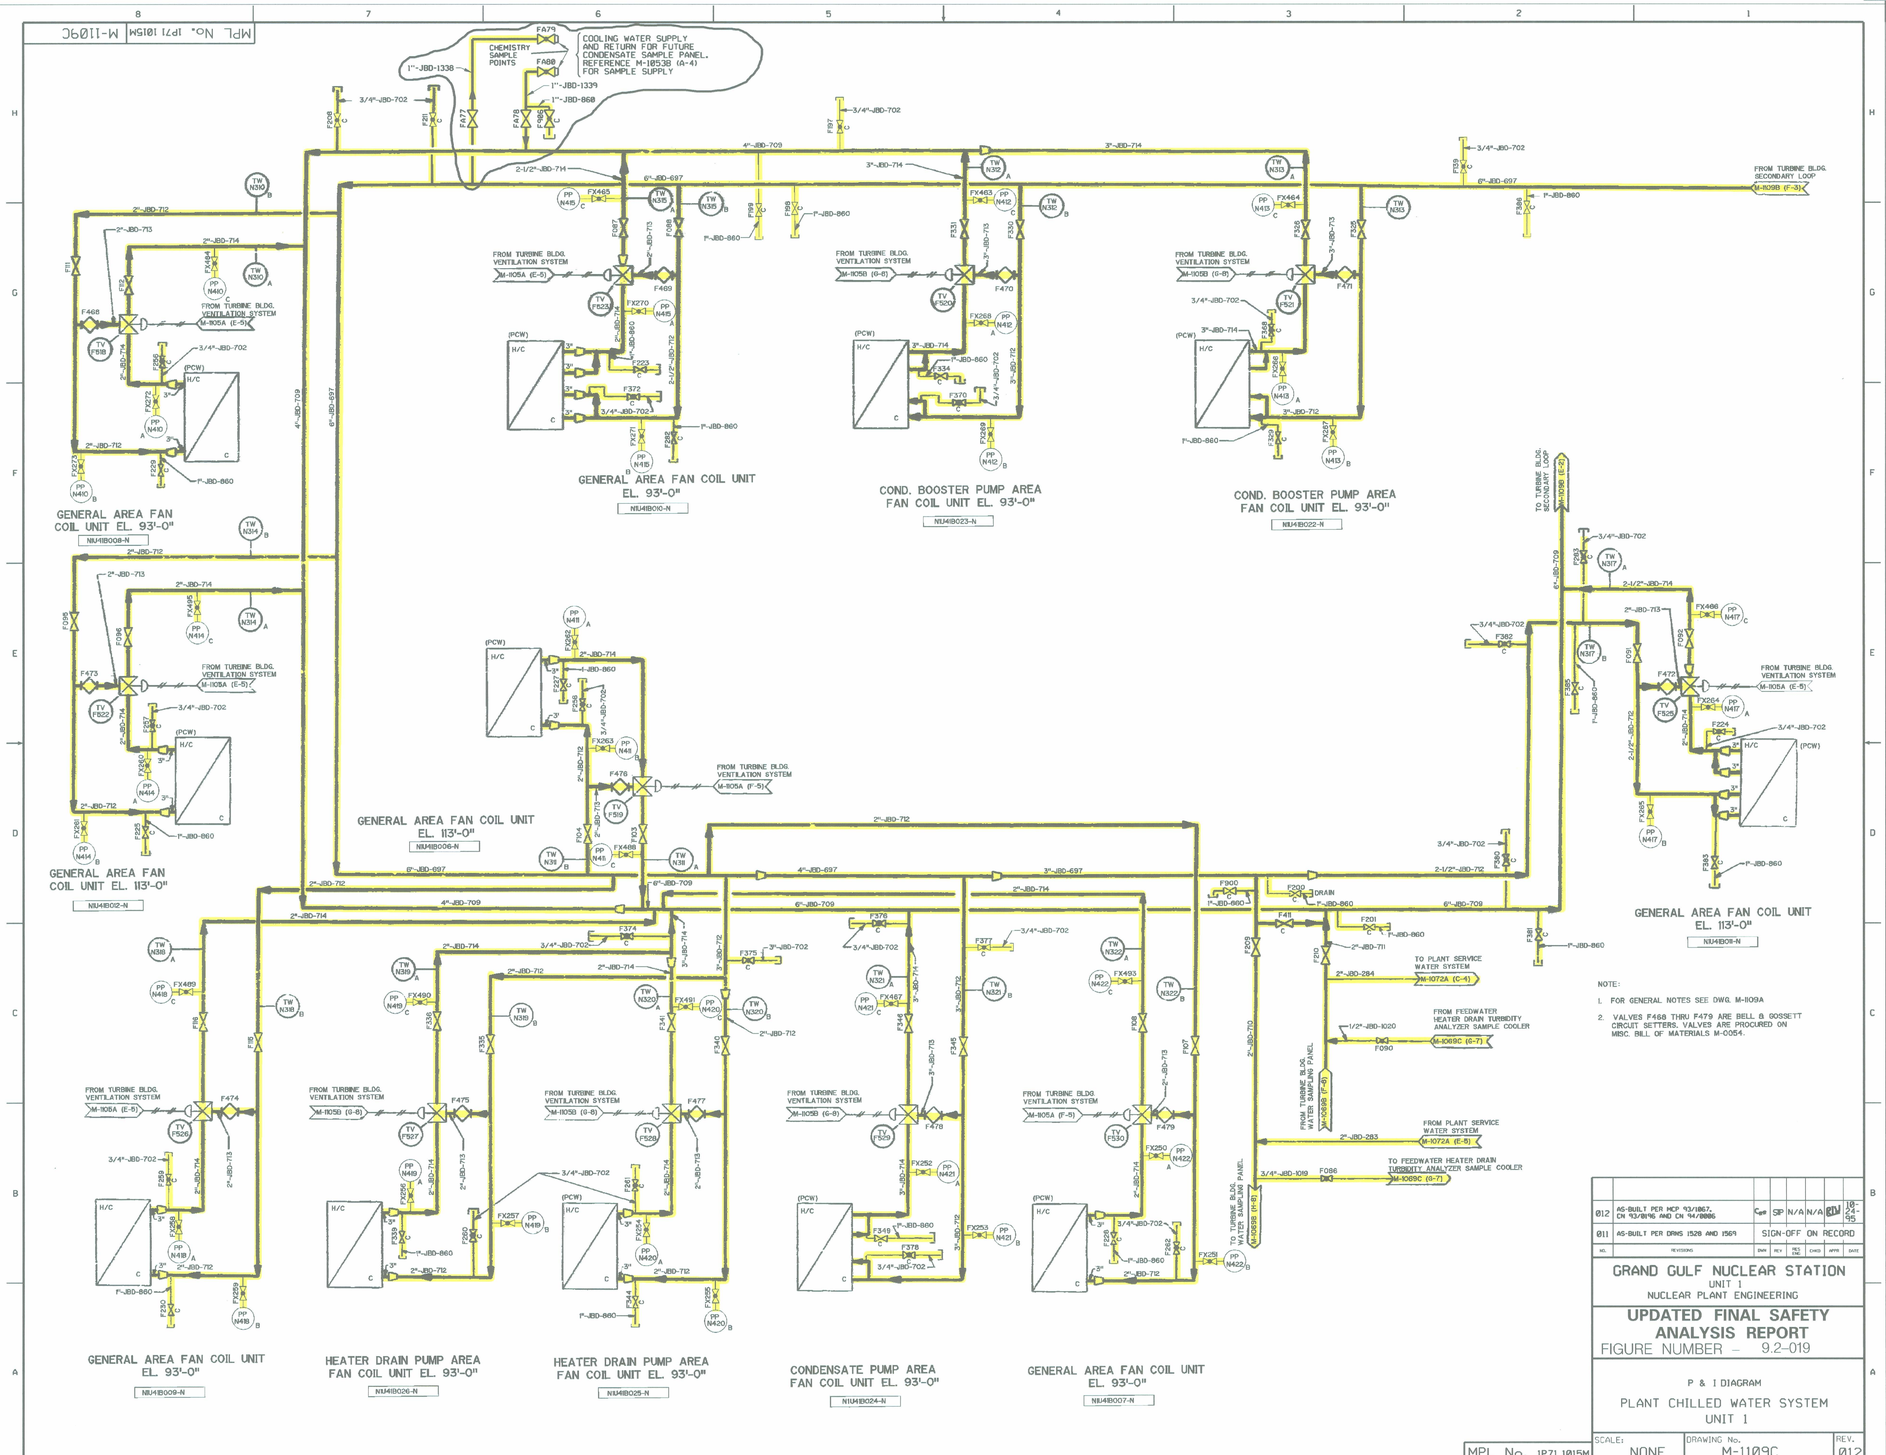

NOTE:

1. FOR GENERAL NOTES SEE DWG. M-1109A
2. VALVES F468 THRU F479 ARE BELL & GOSSETT CIRCUIT SETTERS. VALVES ARE PROCURED ON MISC. BILL OF MATERIALS M-0054.

NO.	REVISIONS	DWN	REV	RES ENG	CHKD	APPR	DATE
012	AS-BUILT PER MCP 93/1867, CN 93/0196 AND CN 94/0006	CGP	SP	N/A	N/A	RDW	10-24-95
011	AS-BUILT PER DRNS 1528 AND 1569	SIGN-OFF ON RECORD					

GRAND GULF NUCLEAR STATION
UNIT 1
NUCLEAR PLANT ENGINEERING

UPDATED FINAL SAFETY ANALYSIS REPORT
FIGURE NUMBER – 9.2-019

P & I DIAGRAM
PLANT CHILLED WATER SYSTEM
UNIT 1

MPL No. 1P71 1015M

SCALE: NONE | DRAWING No. M-1109C | REV. 012

HYBRID DFN: m1109c.dgn

COMPONENTS SUBJECT TO AMR

NON-SAFETY RELATED SYSTEMS & COMPONENTS AFFECTING SAFETY RELATED SYSTEMS AMM20

NO	DATE	DESCRIPTION	BY	ENG	CHK	APP
0	10-13-2011	.	.	.	.	.

REVISIONS

LRA-M-1109C

CAD FILE m1109c.DGN

RASTER FILE