MPL No. 1N23 1015M | M-1055D

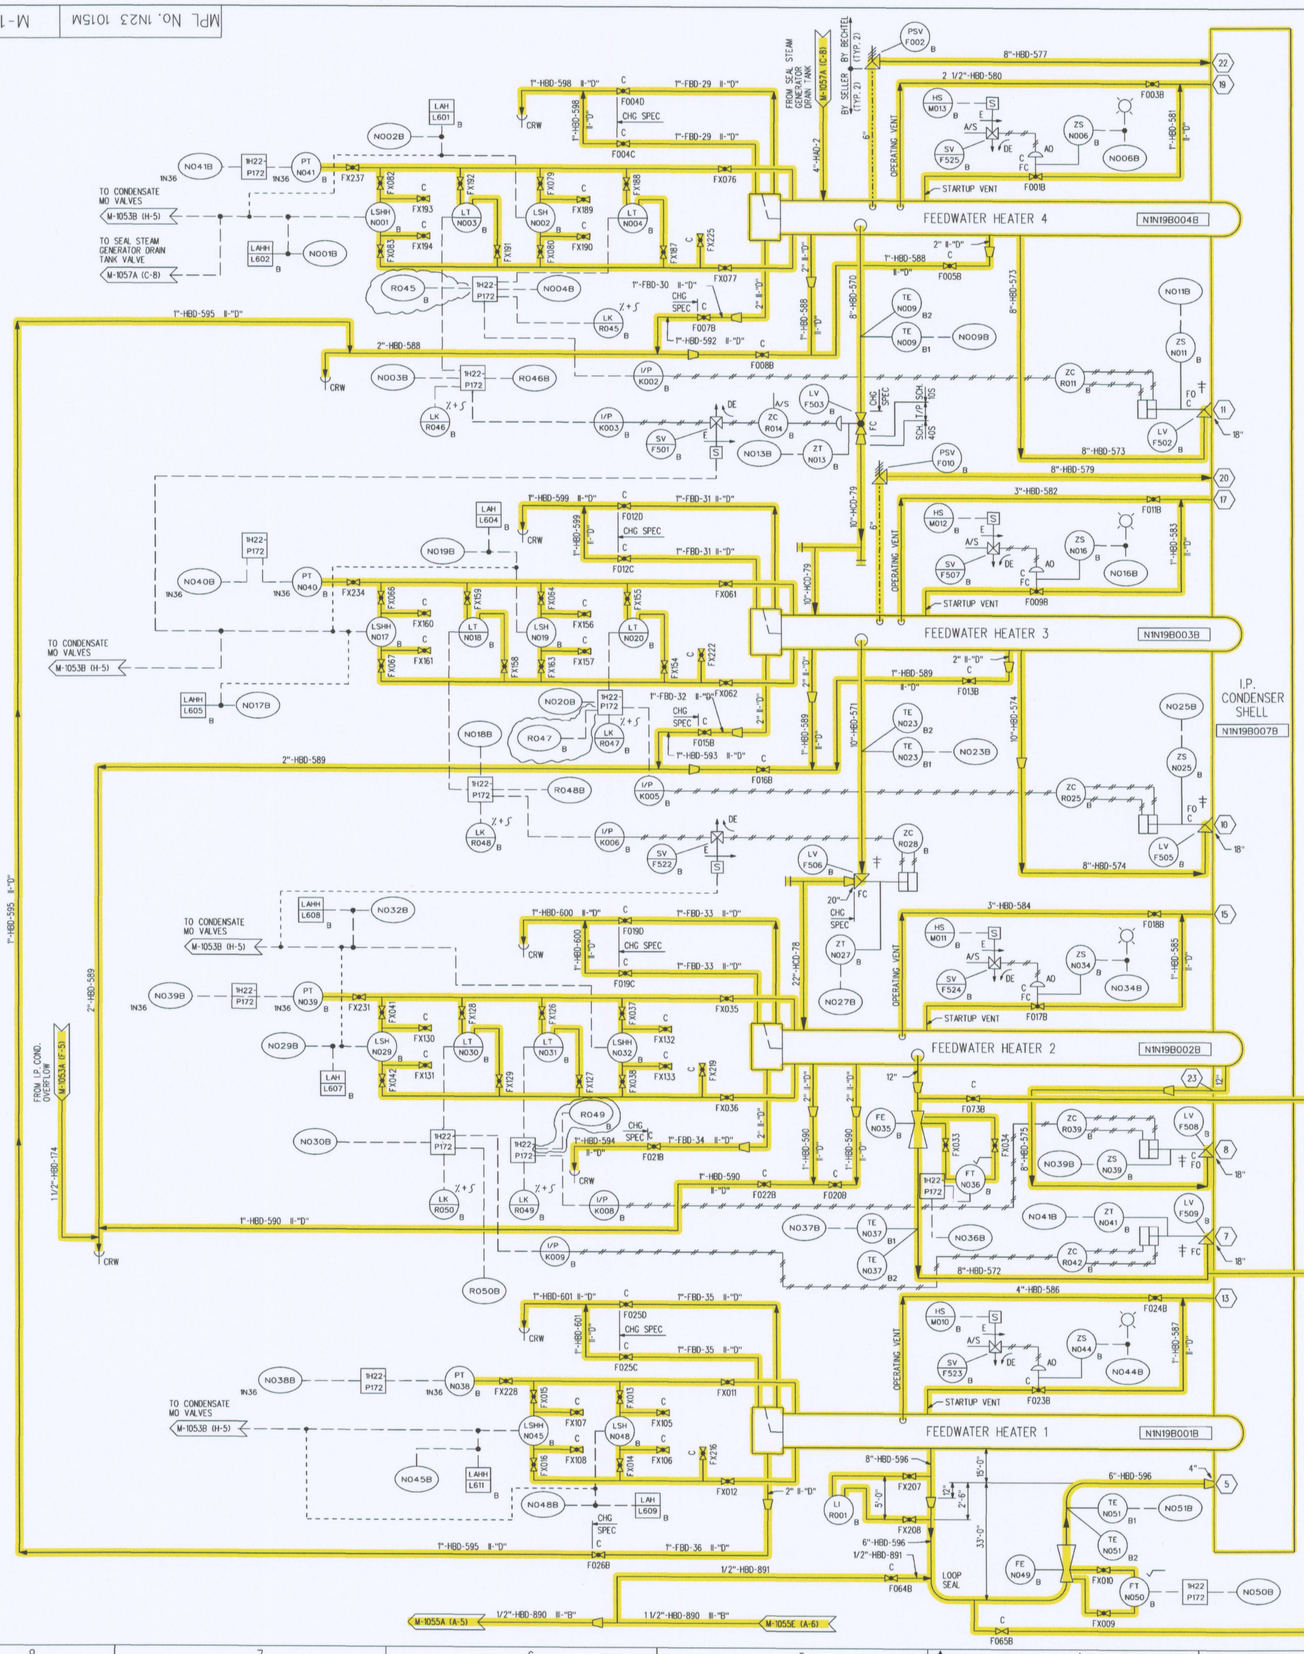

NOTES:
1. FOR NOTES SEE DRAWING M-1055A.

COMPONENTS SUBJECT TO AMR
NON-SAFETY RELATED SYSTEMS & COMPONENTS AFFECTING SAFETY RELATED SYSTEMS AMM20

No.	REVISIONS	ENG REV	RES ENG	CHKD	APPR	DATE
005	AS-BUILT PER EC-5593	WE	N/A	N/A	SP	MM	3-18-08
004	AS-BUILT PER DRN 03-443 REF. ER-GG-2003-0341-000-00	WE	SIGN-OFF ON RECORD			

GRAND GULF NUCLEAR STATION
UNIT 1
NUCLEAR PLANT ENGINEERING

UPDATED FINAL SAFETY ANALYSIS REPORT
FIGURE NUMBER - 10.3-005-02

P & I DIAGRAM
HEATER VENTS & DRAINS SYSTEMS
UNIT 1

SCALE:	DRAWING No.	REV.
NONE	M-1055D	005

MPL No. 1N23 1015M

DFN: m1055d.dgn

NO.	DATE	DESCRIPTION	BY	ENG	CHK	APP
0	9-30-2011	-	-	-	-	-

REVISIONS
LRA-M-1055D
CAD FILE: m1055d.DGN
RASTER FILE:

D146